


WEDGEWOOD 4TH ADD  
ALL BLANK LOTS TO  
CLARK CORP. OF IOWA 12-1-71

TRANSFER PAGE 13-1876

TRANSFER PAGE 64-179

TRANSFER PAGE 13-1783 (1-30)  
13-1784 (31-60)

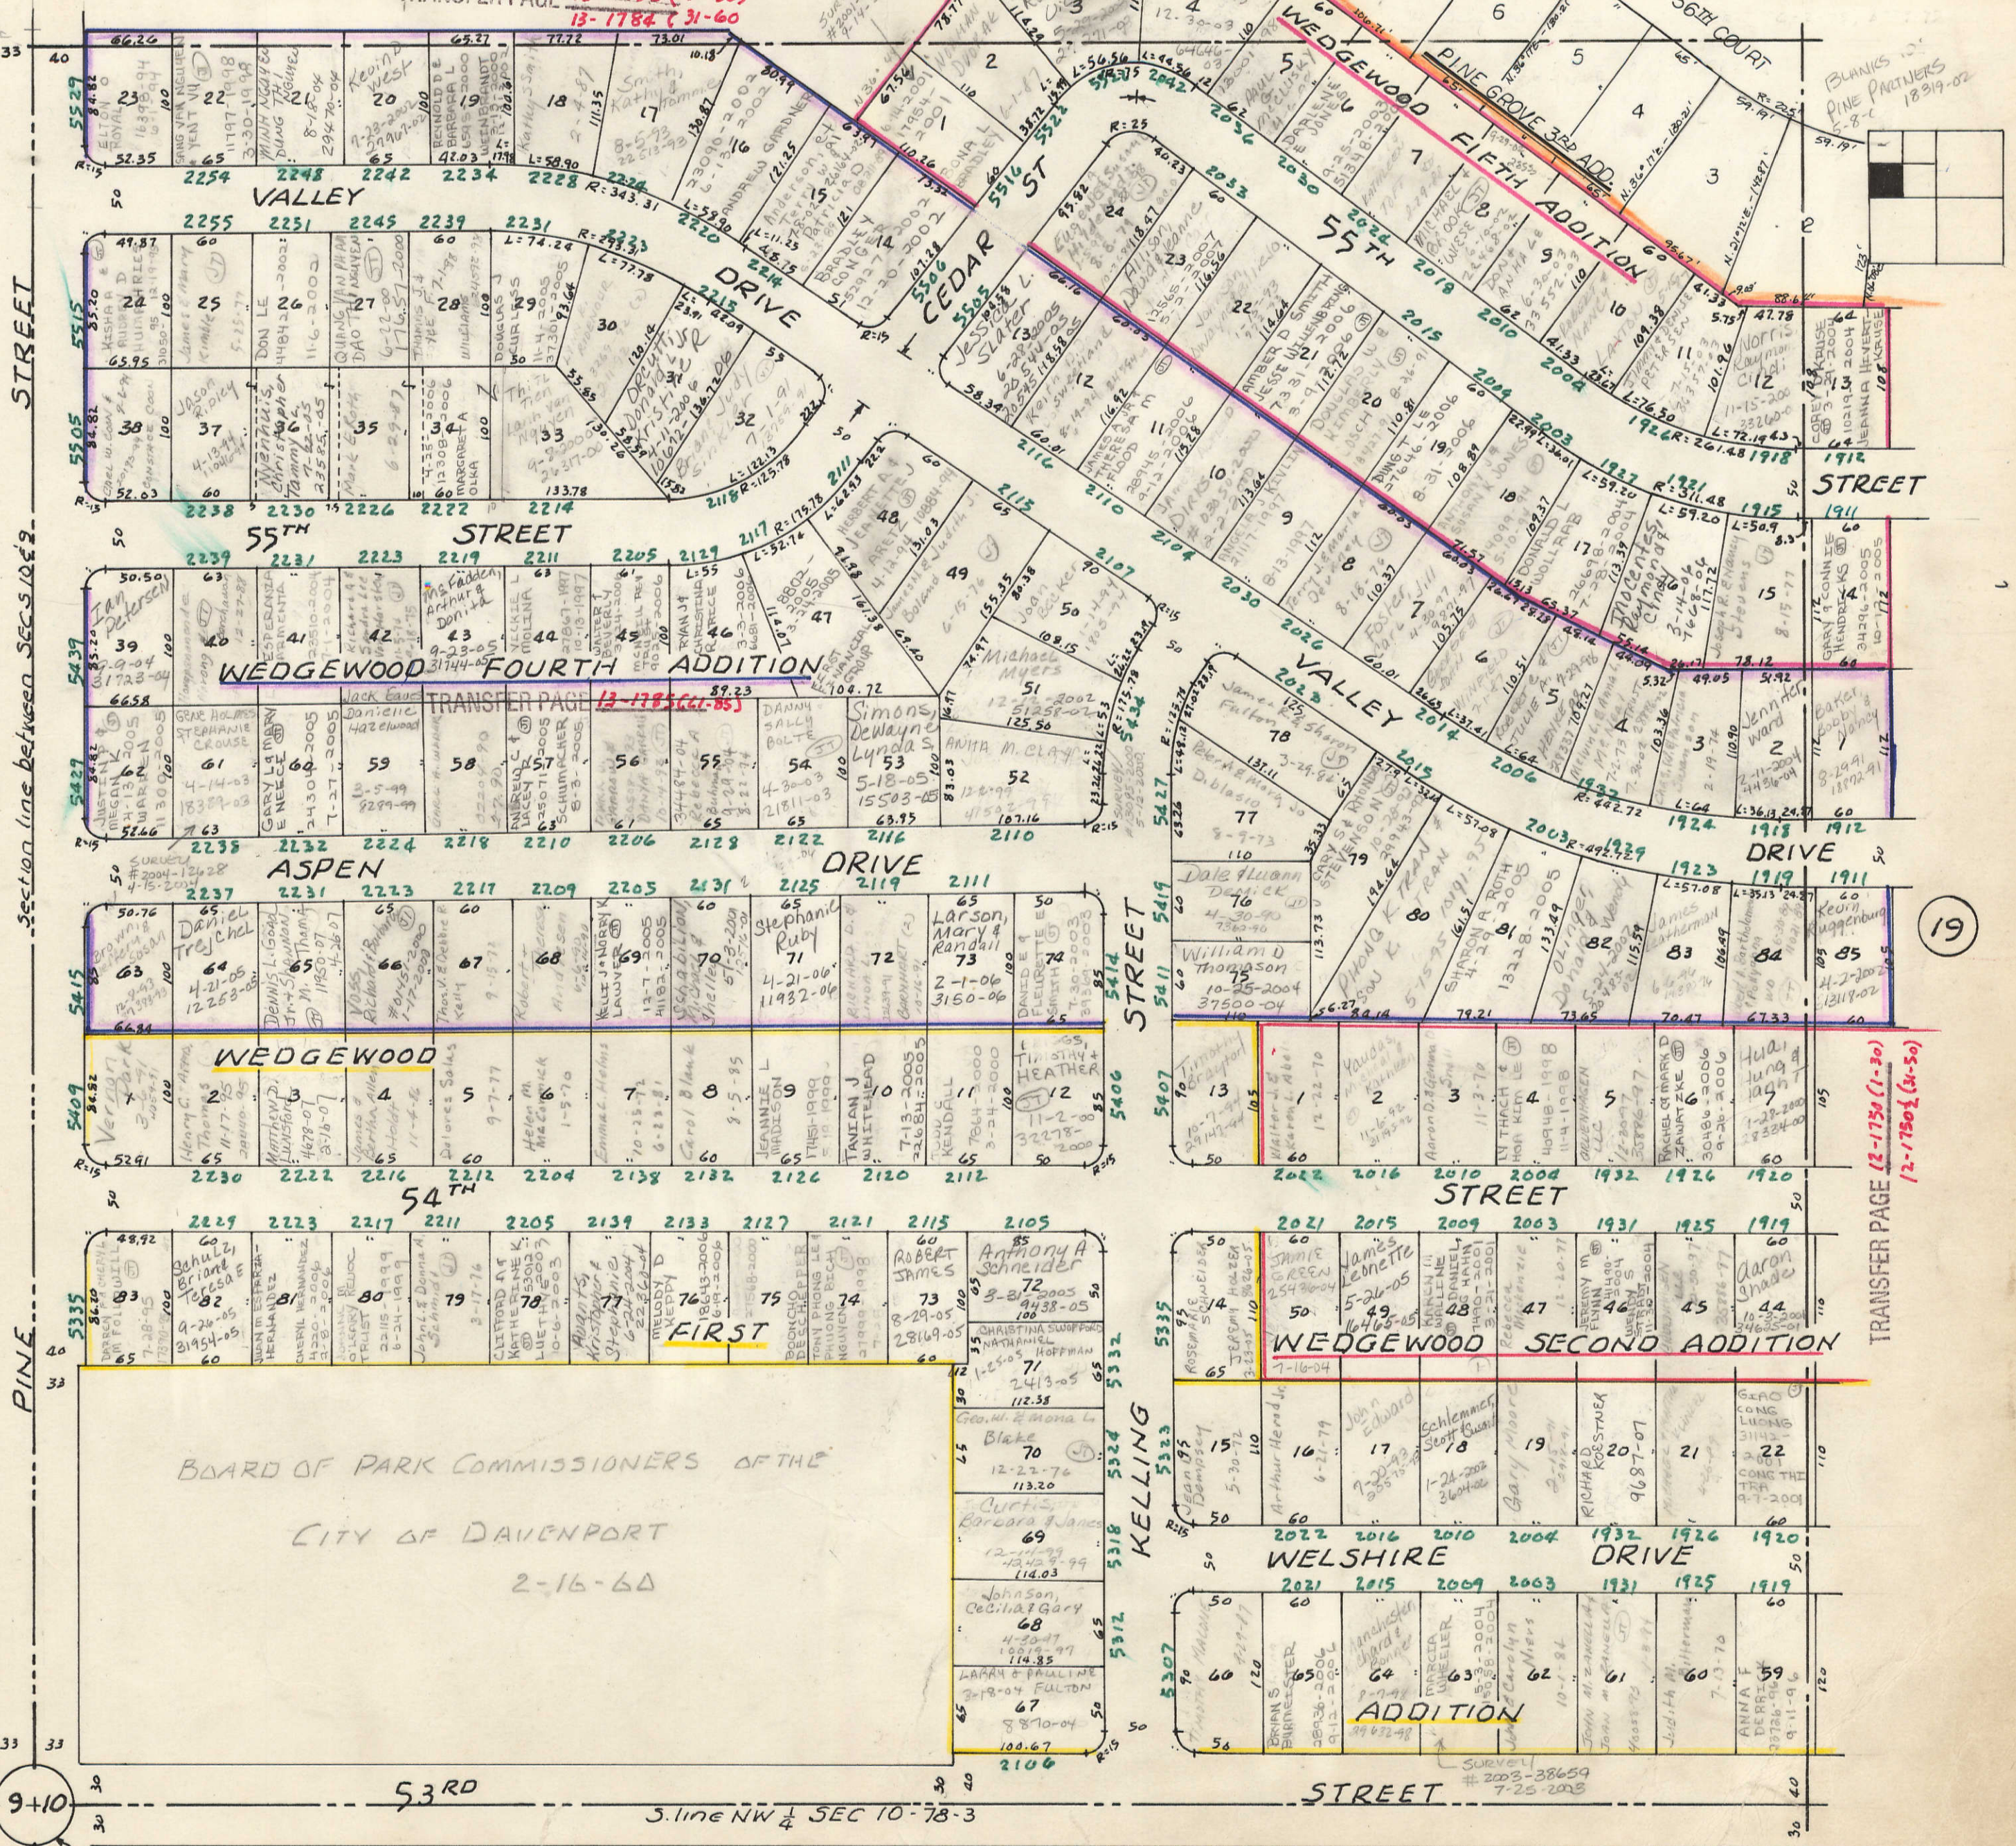

SEC 9

23

19

Section line between SECS 10 & 9

PINE STREET

9+10

53RD

S. line NW 1/4 SEC 10-78-3

VOLM SEC 10

TRANSFER PAGE 12-1742 (1-40)  
12-1743 (41-83)

33