

WEST SIXTIETH STREET TOWNHOMES

W-4153

LOT 8

2605

APT #1 OSCAR MARKET Co, Inc.

1-19-81

2607

2609

APT #1 ADVANCE HOMES

6-9-83 DCU

2611

LOT 9

LOT 10

2613

APT #2 Jill Gibson

1-4-85

2615

2617


LOT 11

2619

TRANSFER PAGE 61ds-173

TRANSFER PAGE 15A-2485

TRANSFER PAGE 15A-2460

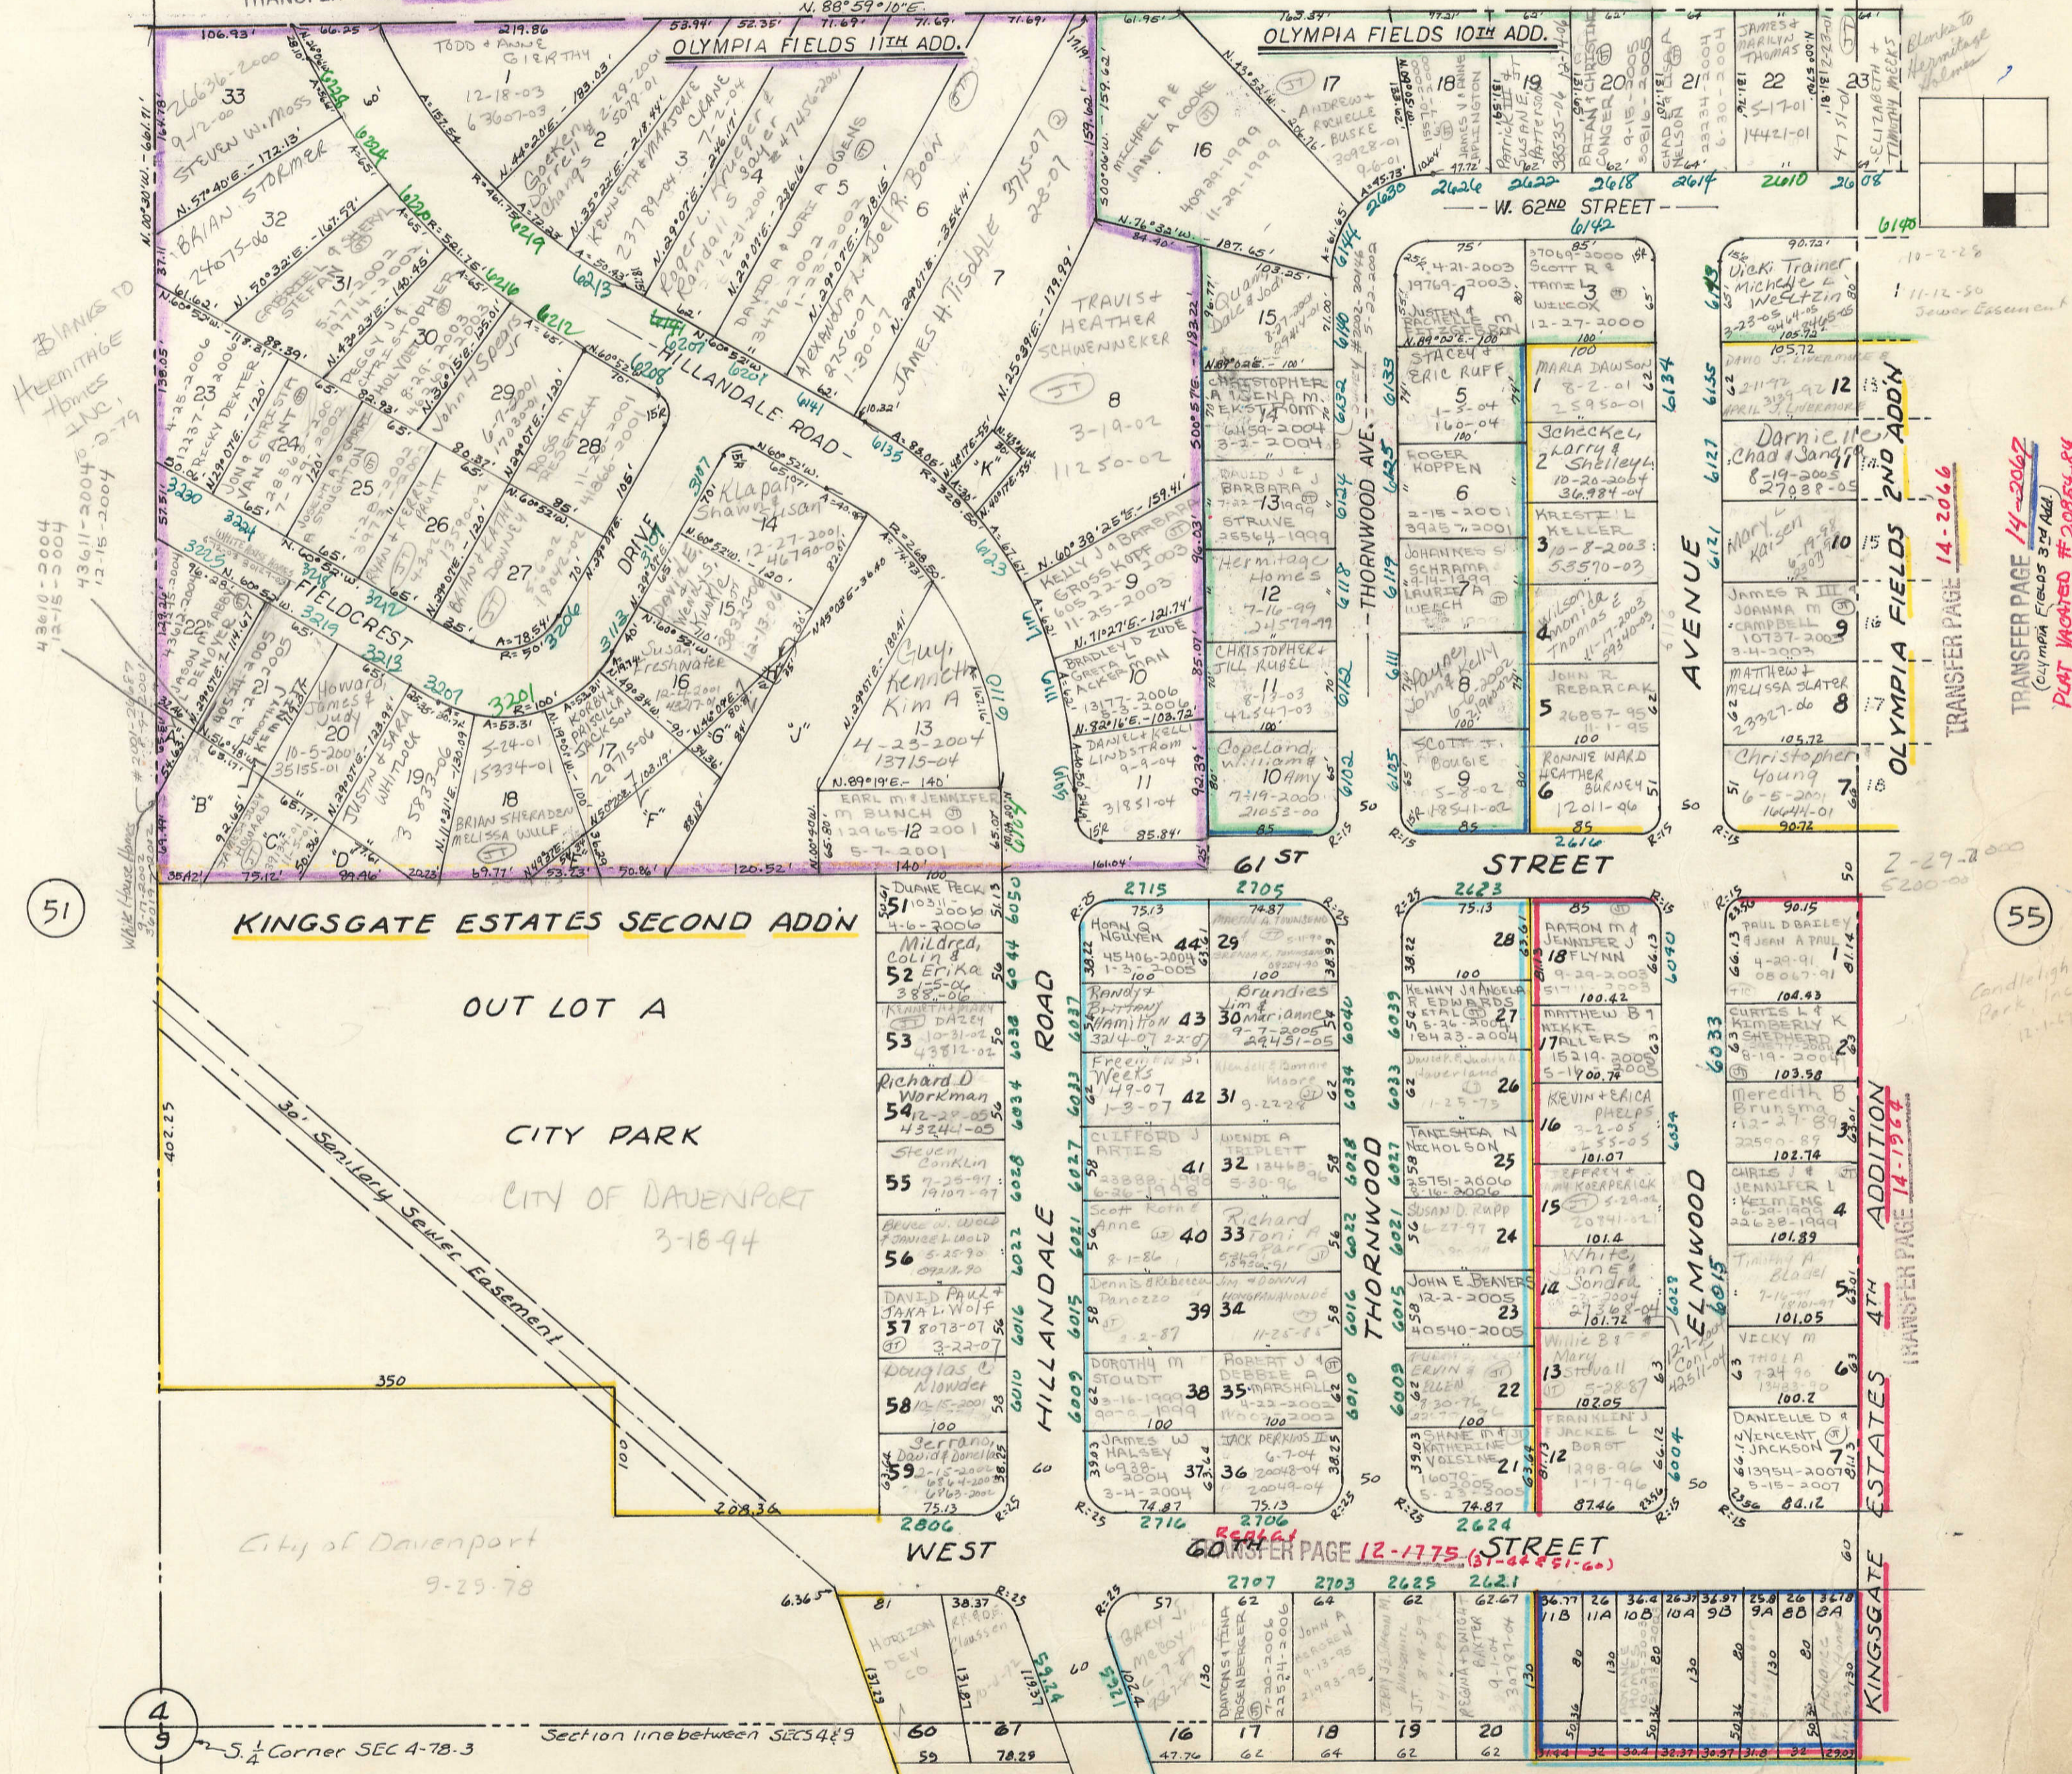

Blanks to Hermitage Home Inc. 43610-2004 12-15-2004 43611-2004 12-15-2004


51

55

4
5

5

TRANSFER PAGE 14-1964
KINGSGATE ESTATES 2ND ADDN

TRANSFER PAGE 14-2067

TRANSFER PAGE 14-2066
OLYMPIA FIELDS 2ND ADDN

KINGSGATE ESTATES 4TH ADDITION