
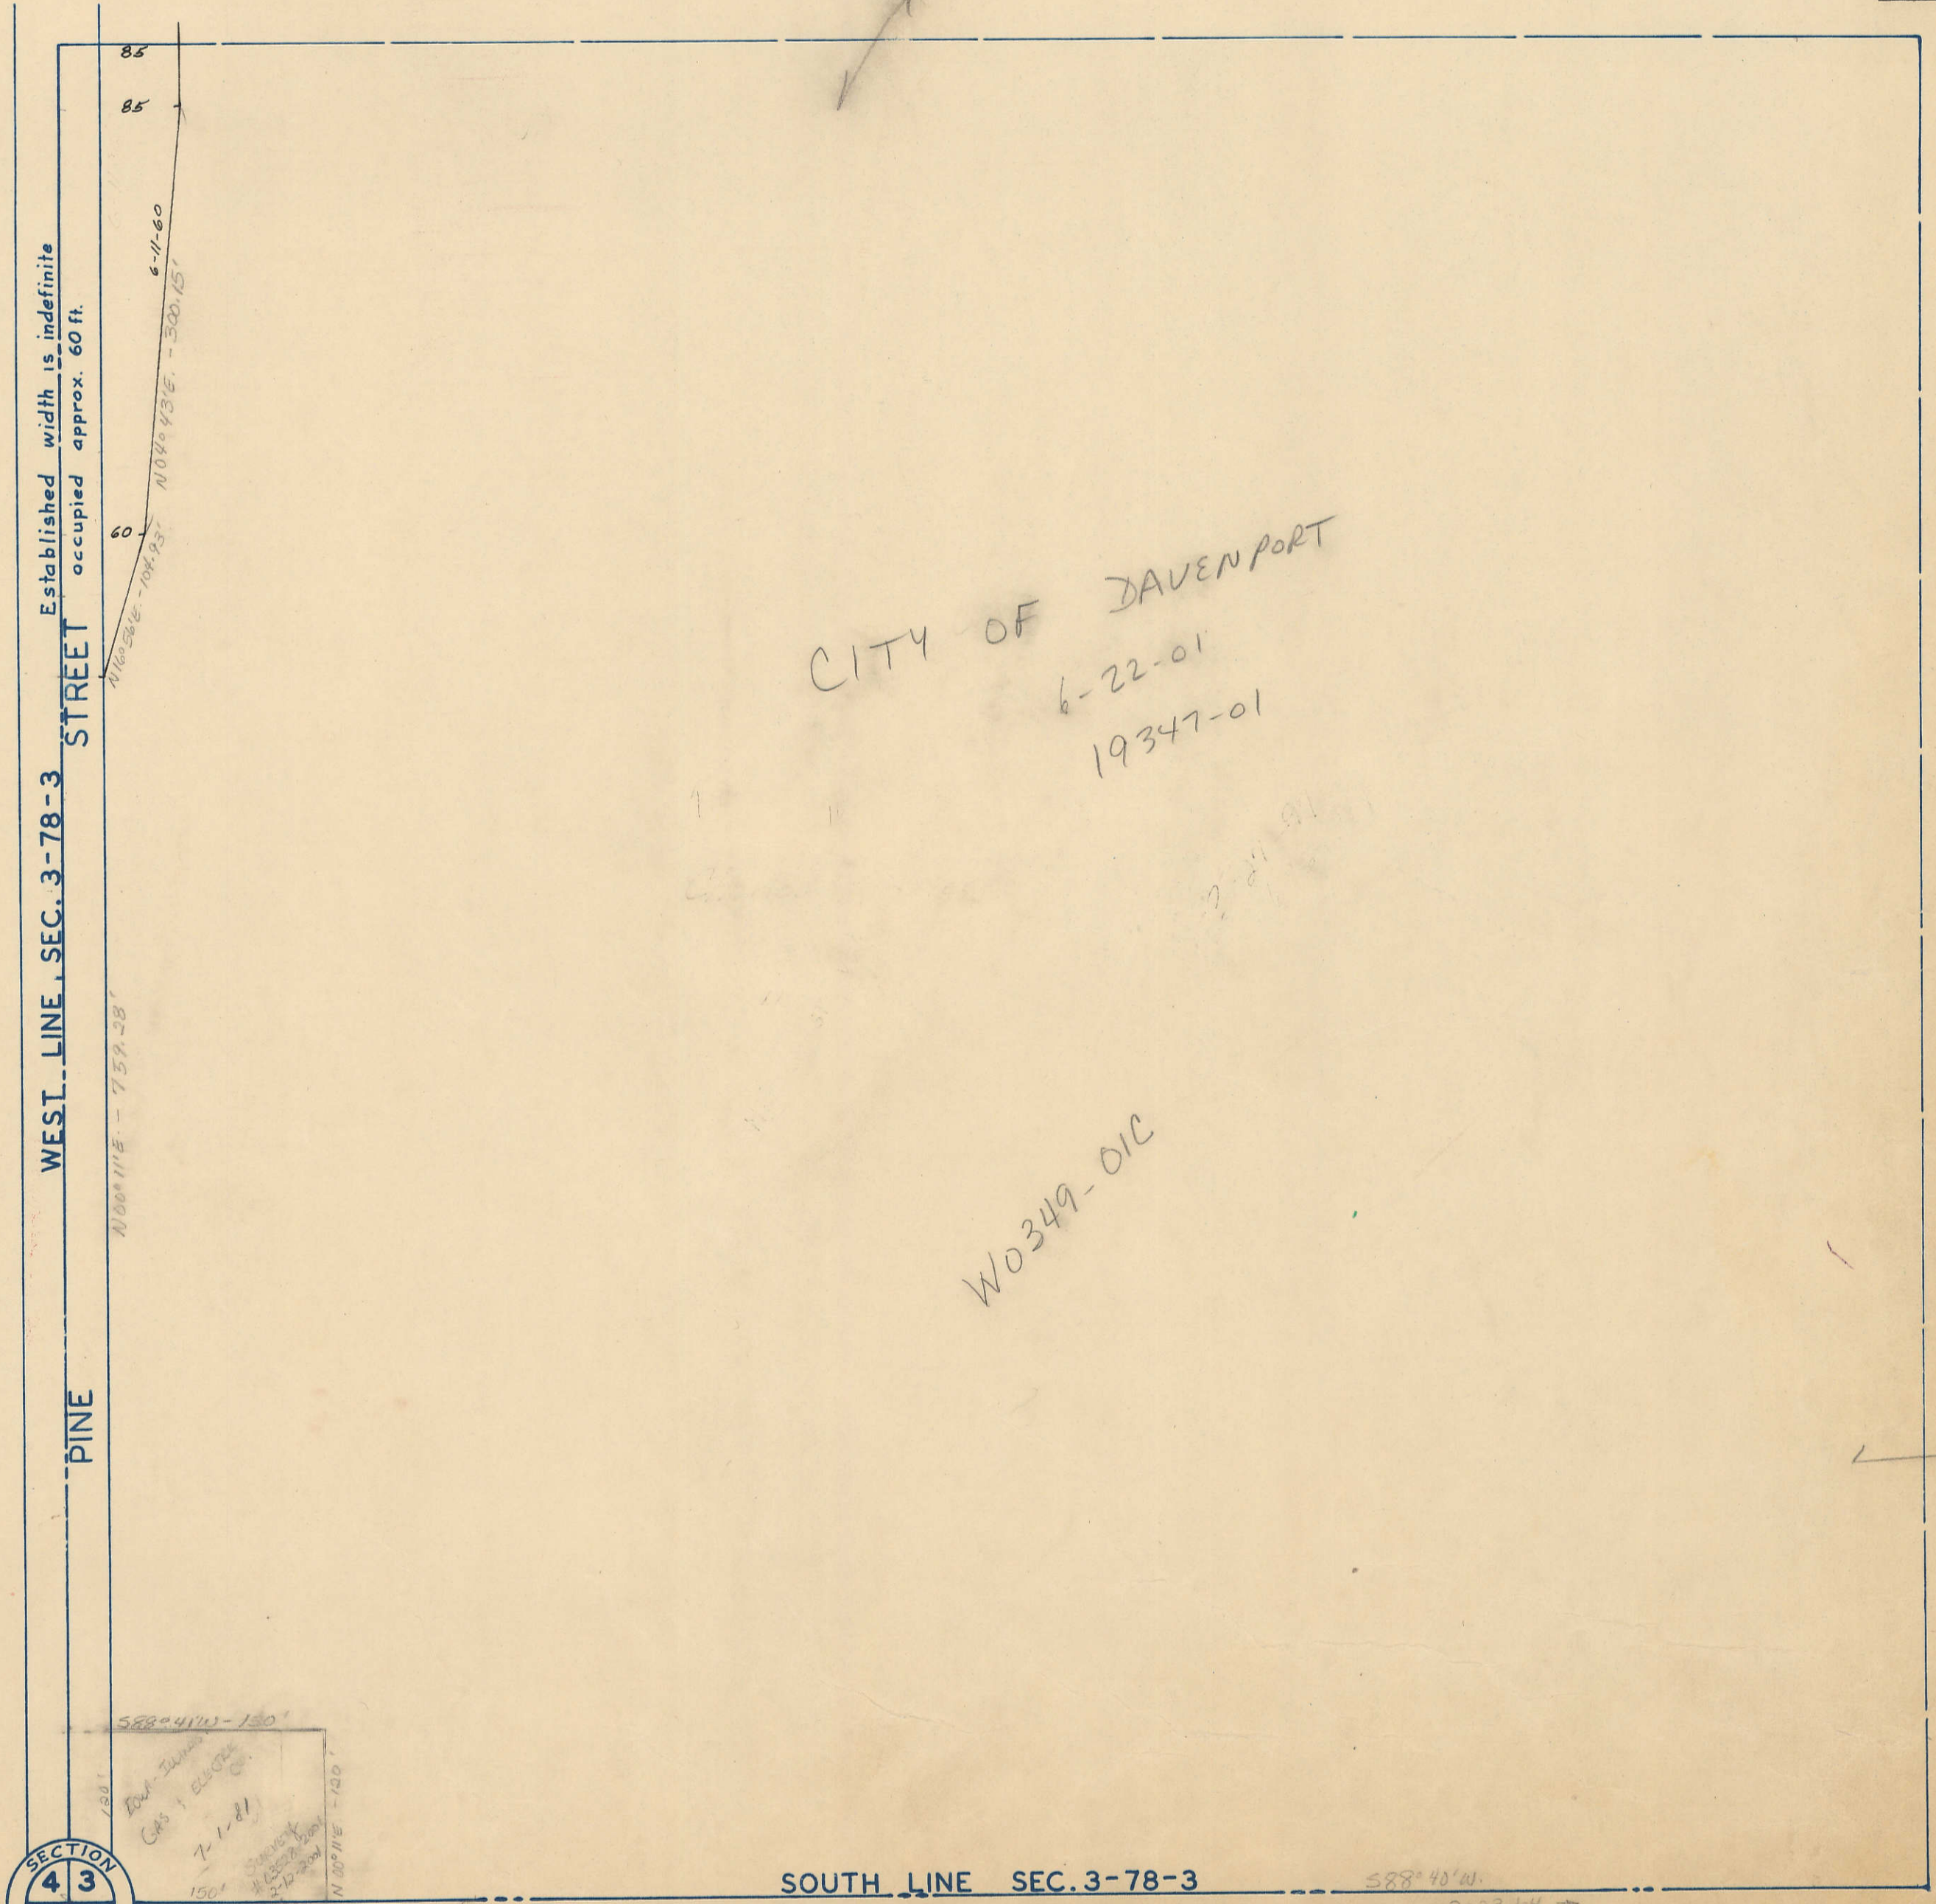


33

Transfer Page 61d-172

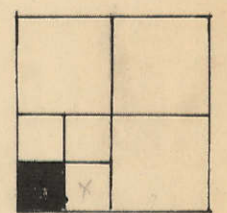

CITY OF DAVENPORT
6-22-01
19347-01

W0349-01C

W-4

55

51

SECTION
4 3
9 10
CORNER

SOUTH LINE SEC. 3-78-3

W-10

1

588°40'W
120'
Survey
N 100°11'E - 759.28'
2-12-2000

588°40'W
2003.44 →