
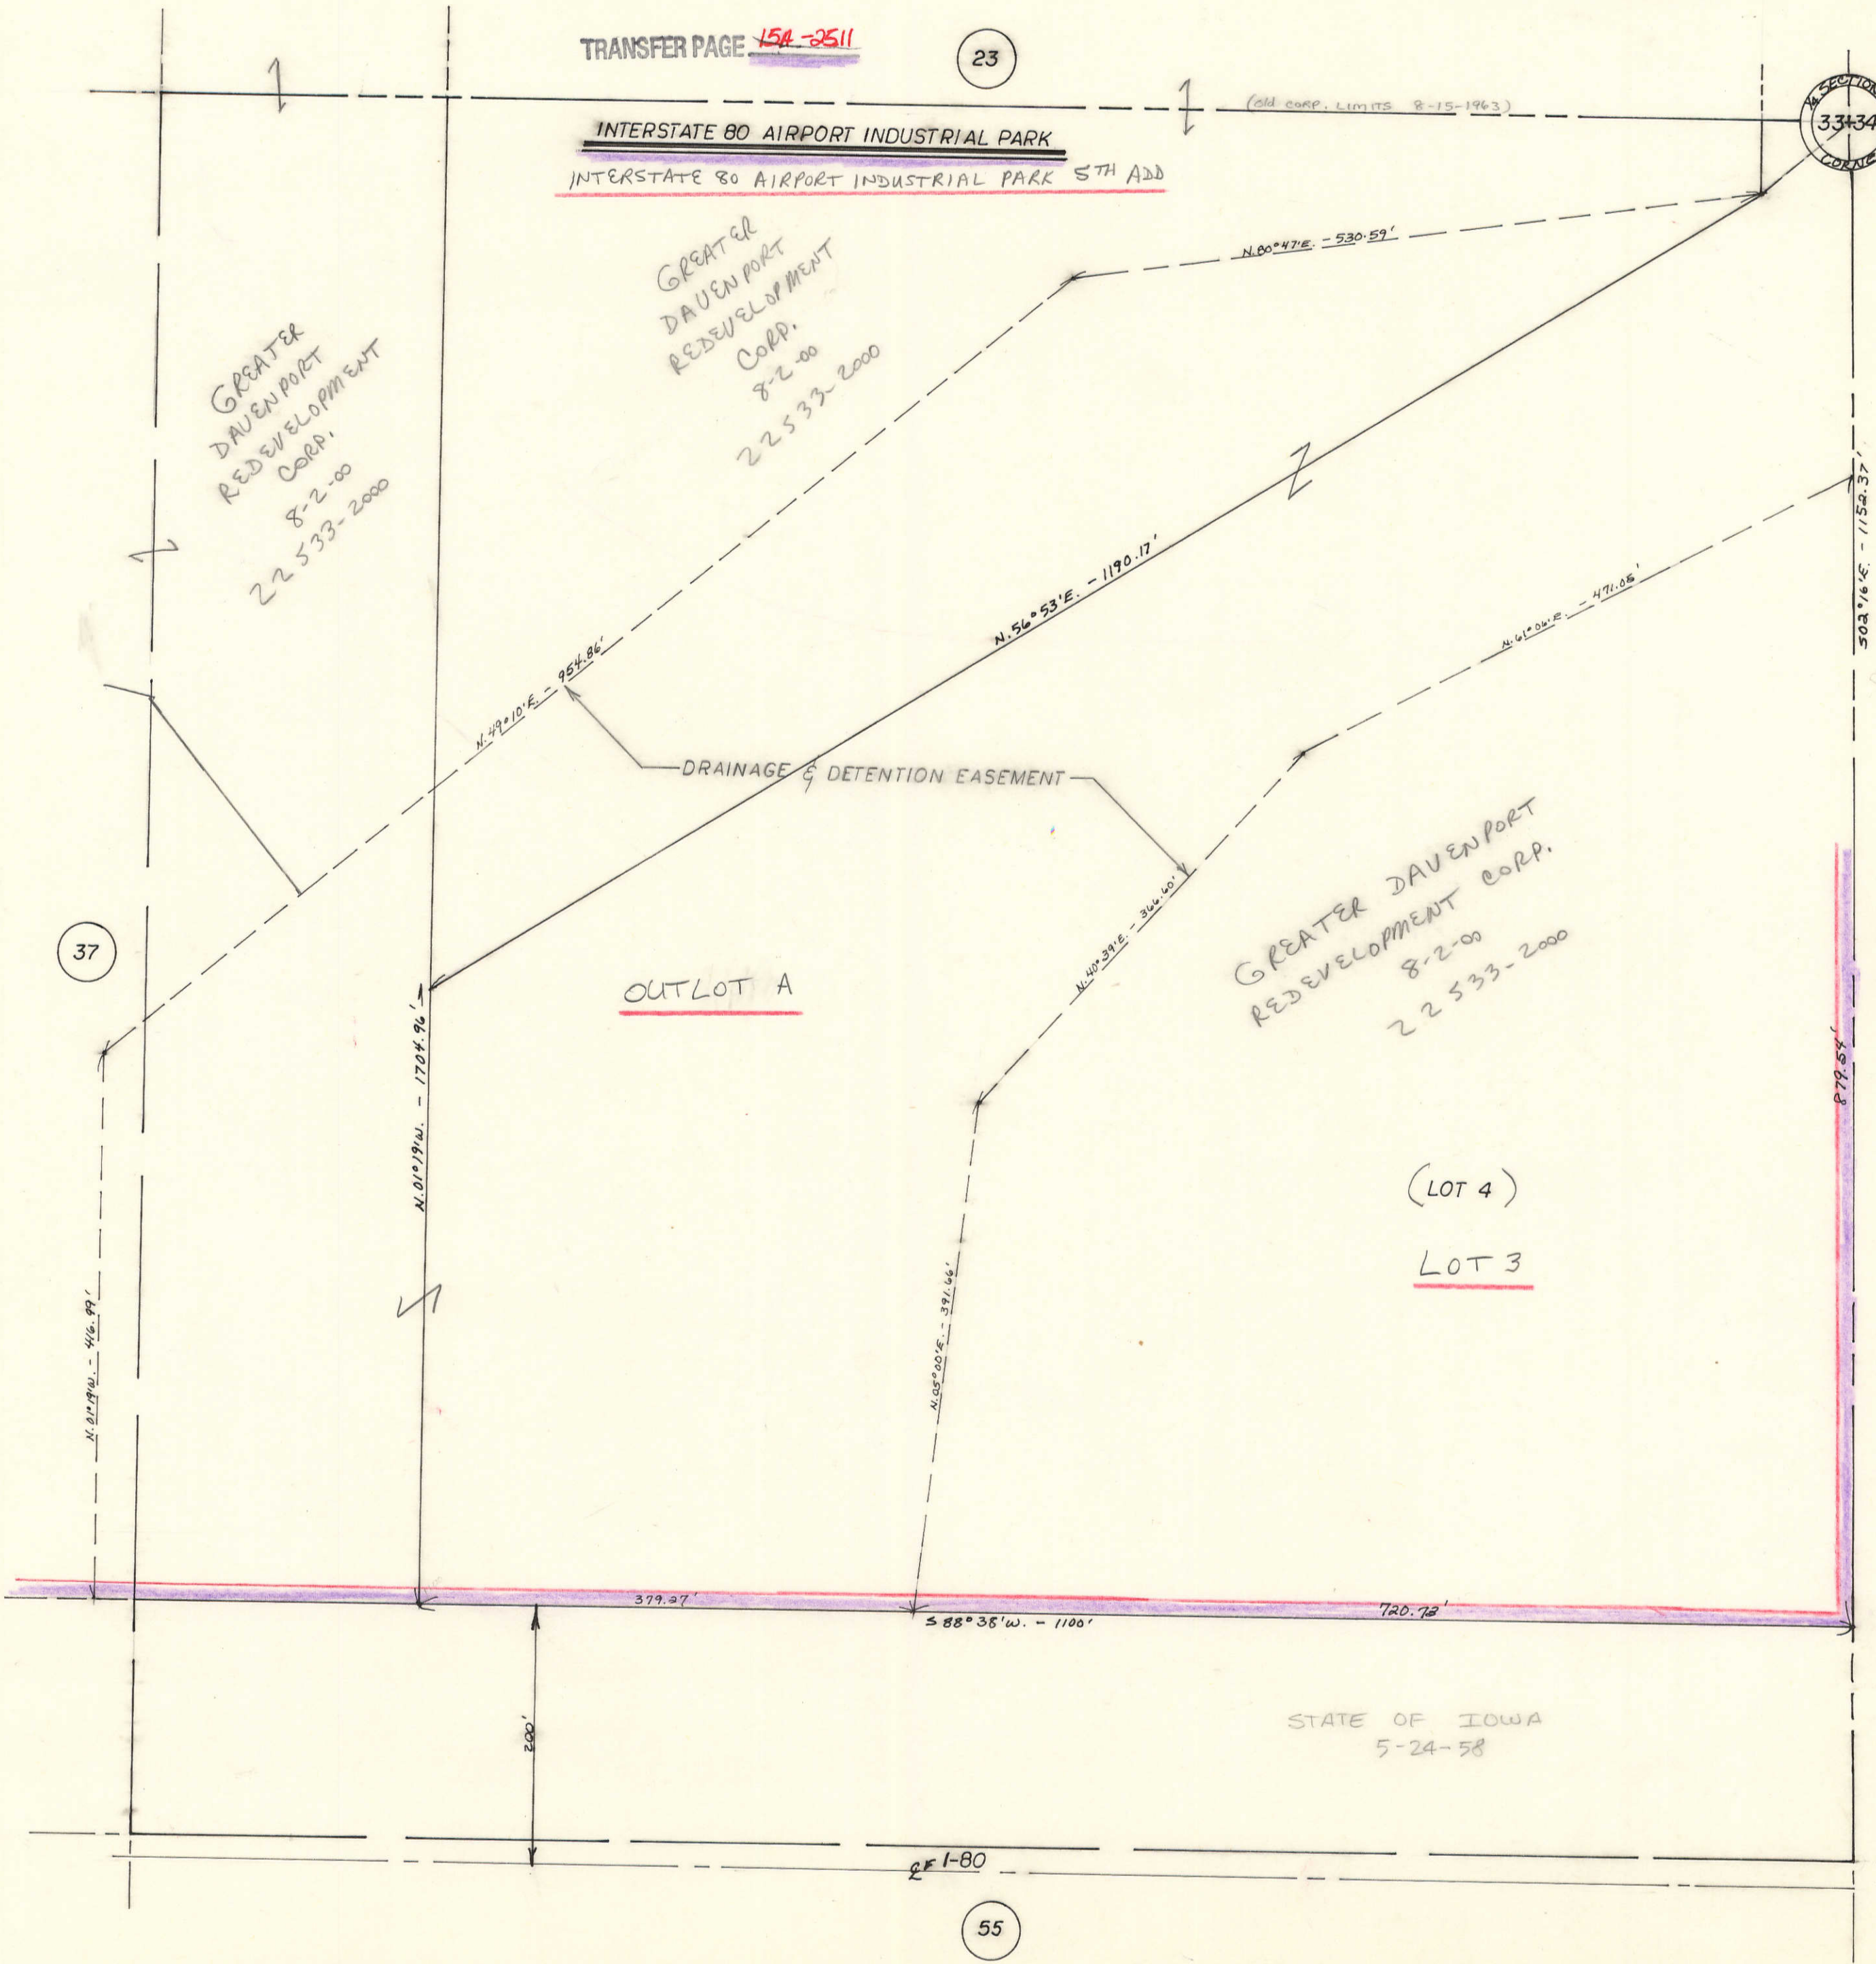


TRANSFER PAGE 81ds-457

TRANSFER PAGE 15A-2511

23

33+34
SECTION
TOWNSHIP

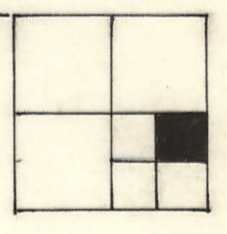

37

OUTLOT A

GREATER DAVENPORT
REDEVELOPMENT CORP.
8-2-00
22533-2000

(LOT 4)

LOT 3

W-1

34-33

STATE OF IOWA
5-24-58

RF 1-80

55