



3

Transfer Page 66d-173

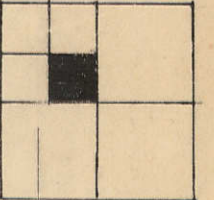

High Point 9th
Blaine to
Sheffield Source
6-22-01

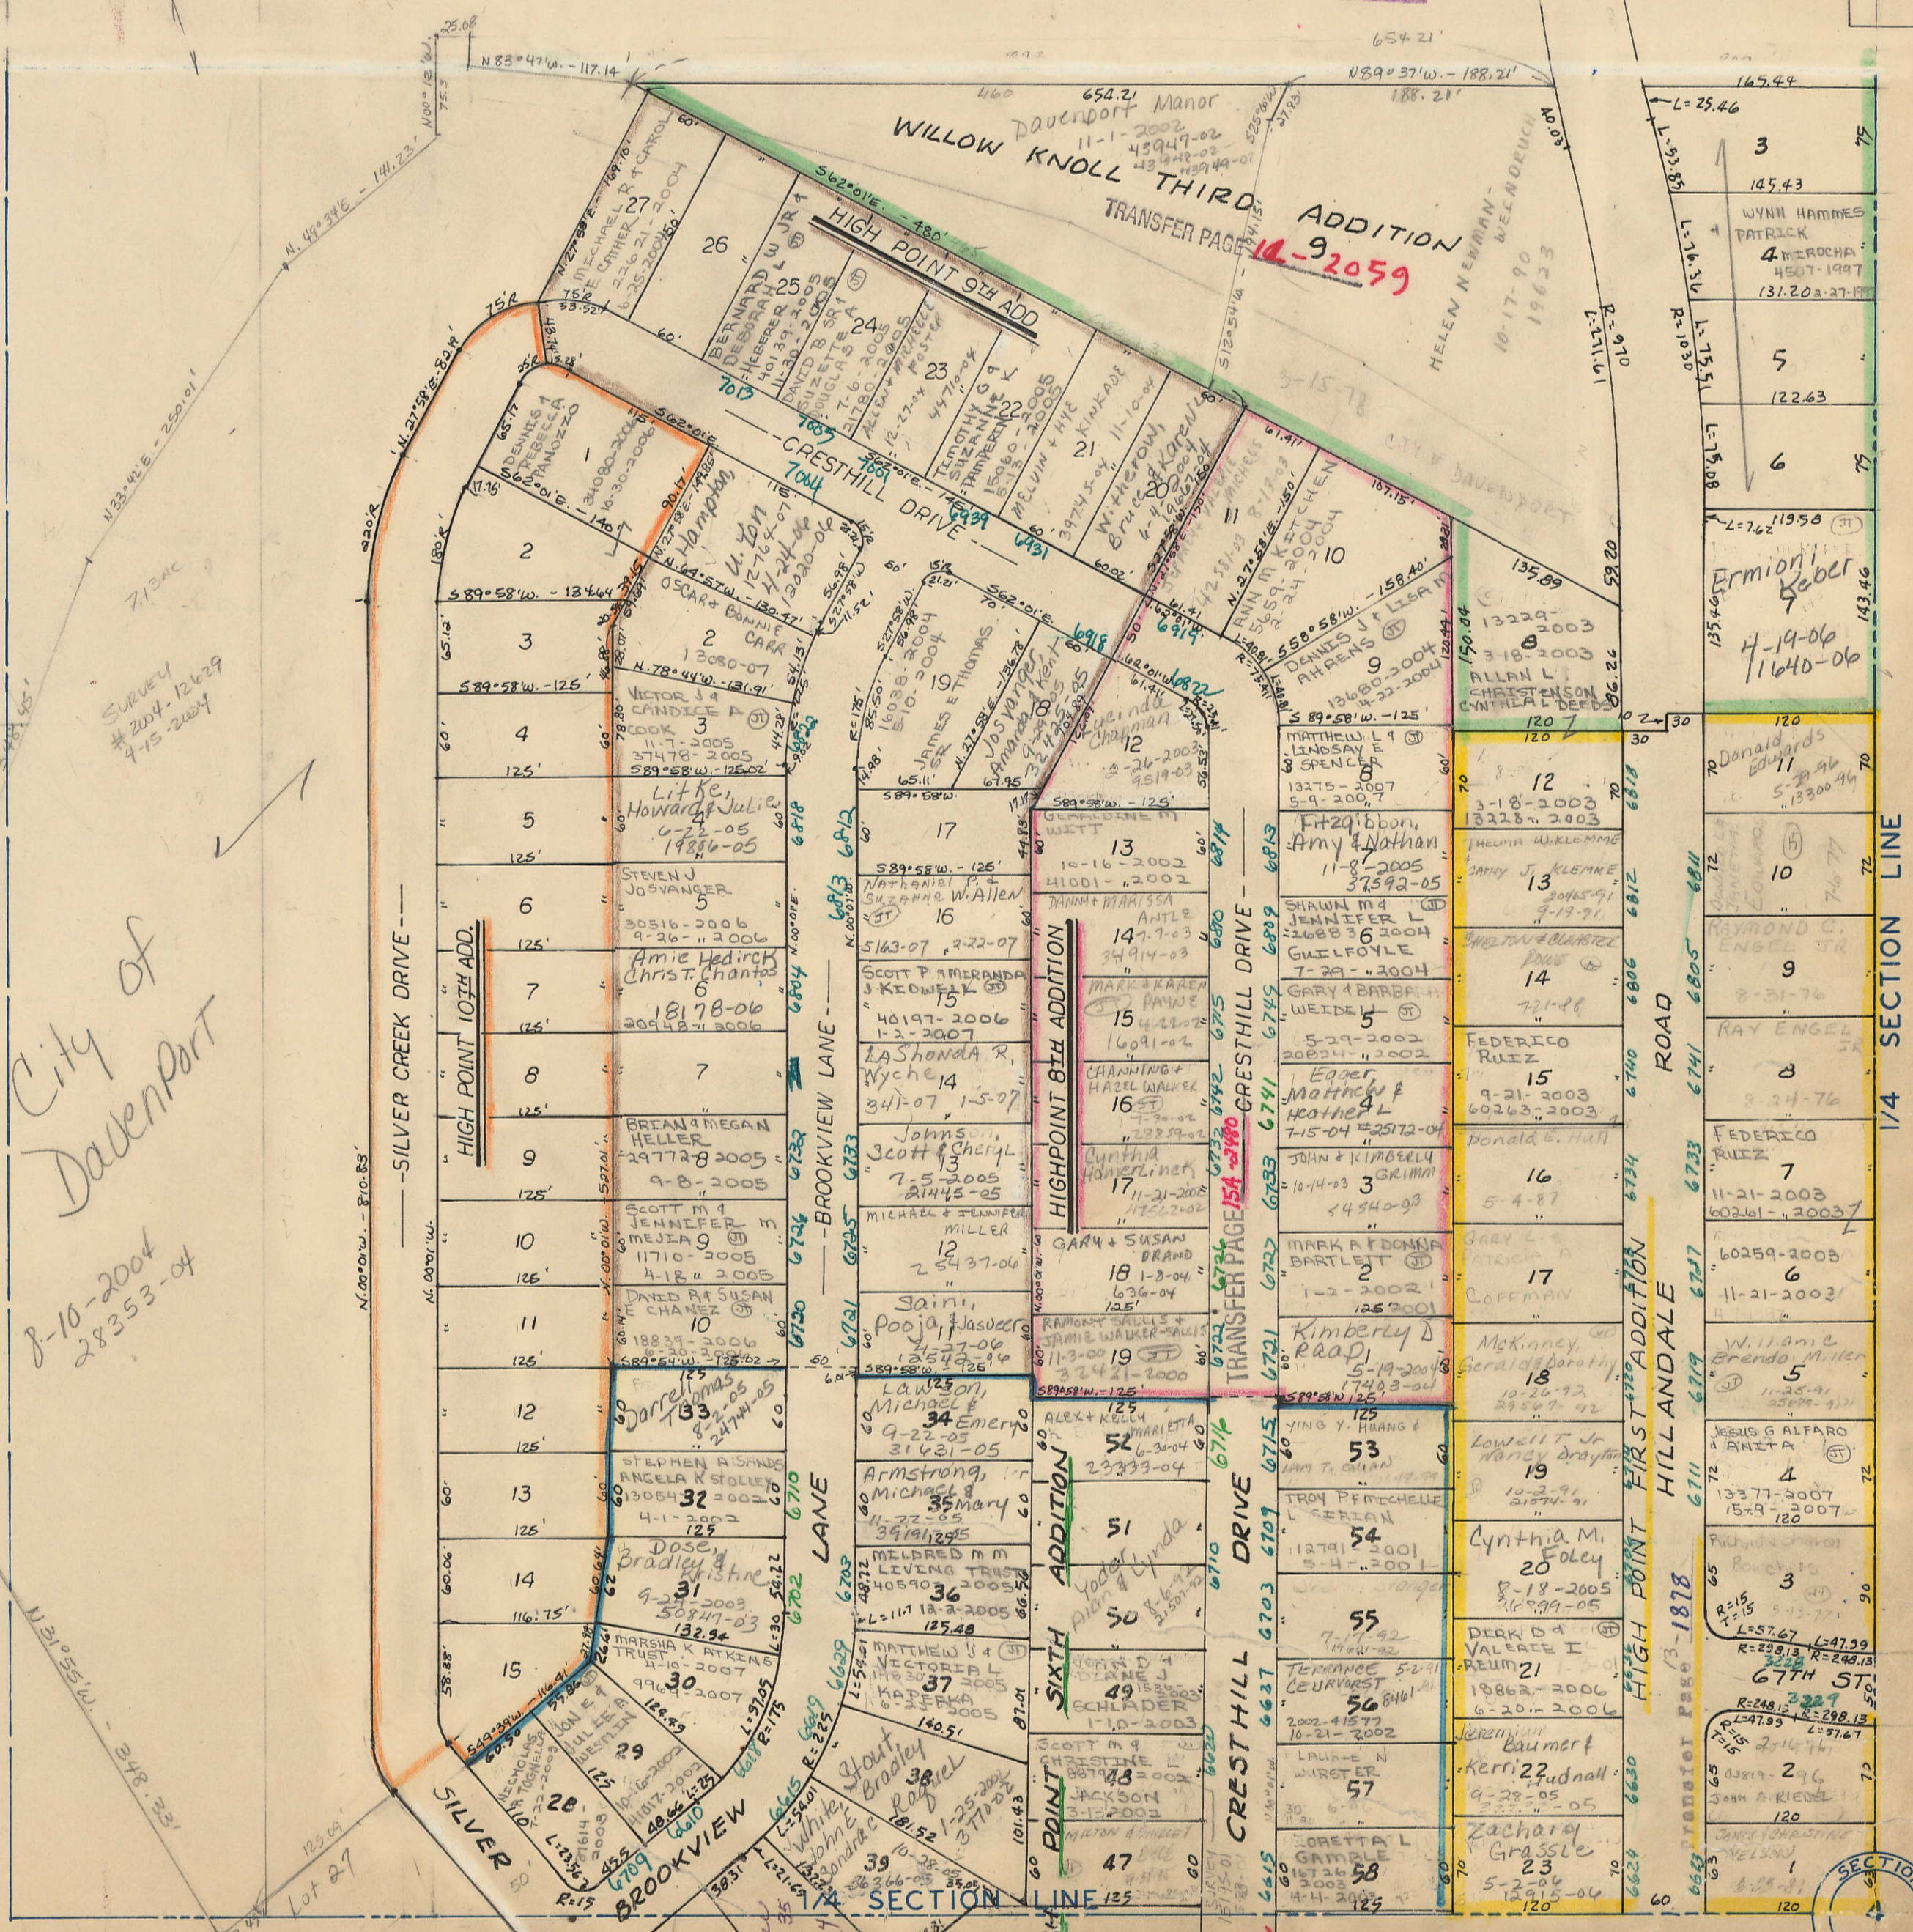

17

City of
Davenport

8-10-2004
28353-04

21

1/4 SECTION LINE

SECTION CENTER

35

2034 (1-30)
2034-A (31-60)
2034-B (61-80)

LOT 5
1st Federal Survey
& Loan 2-2-83