


37

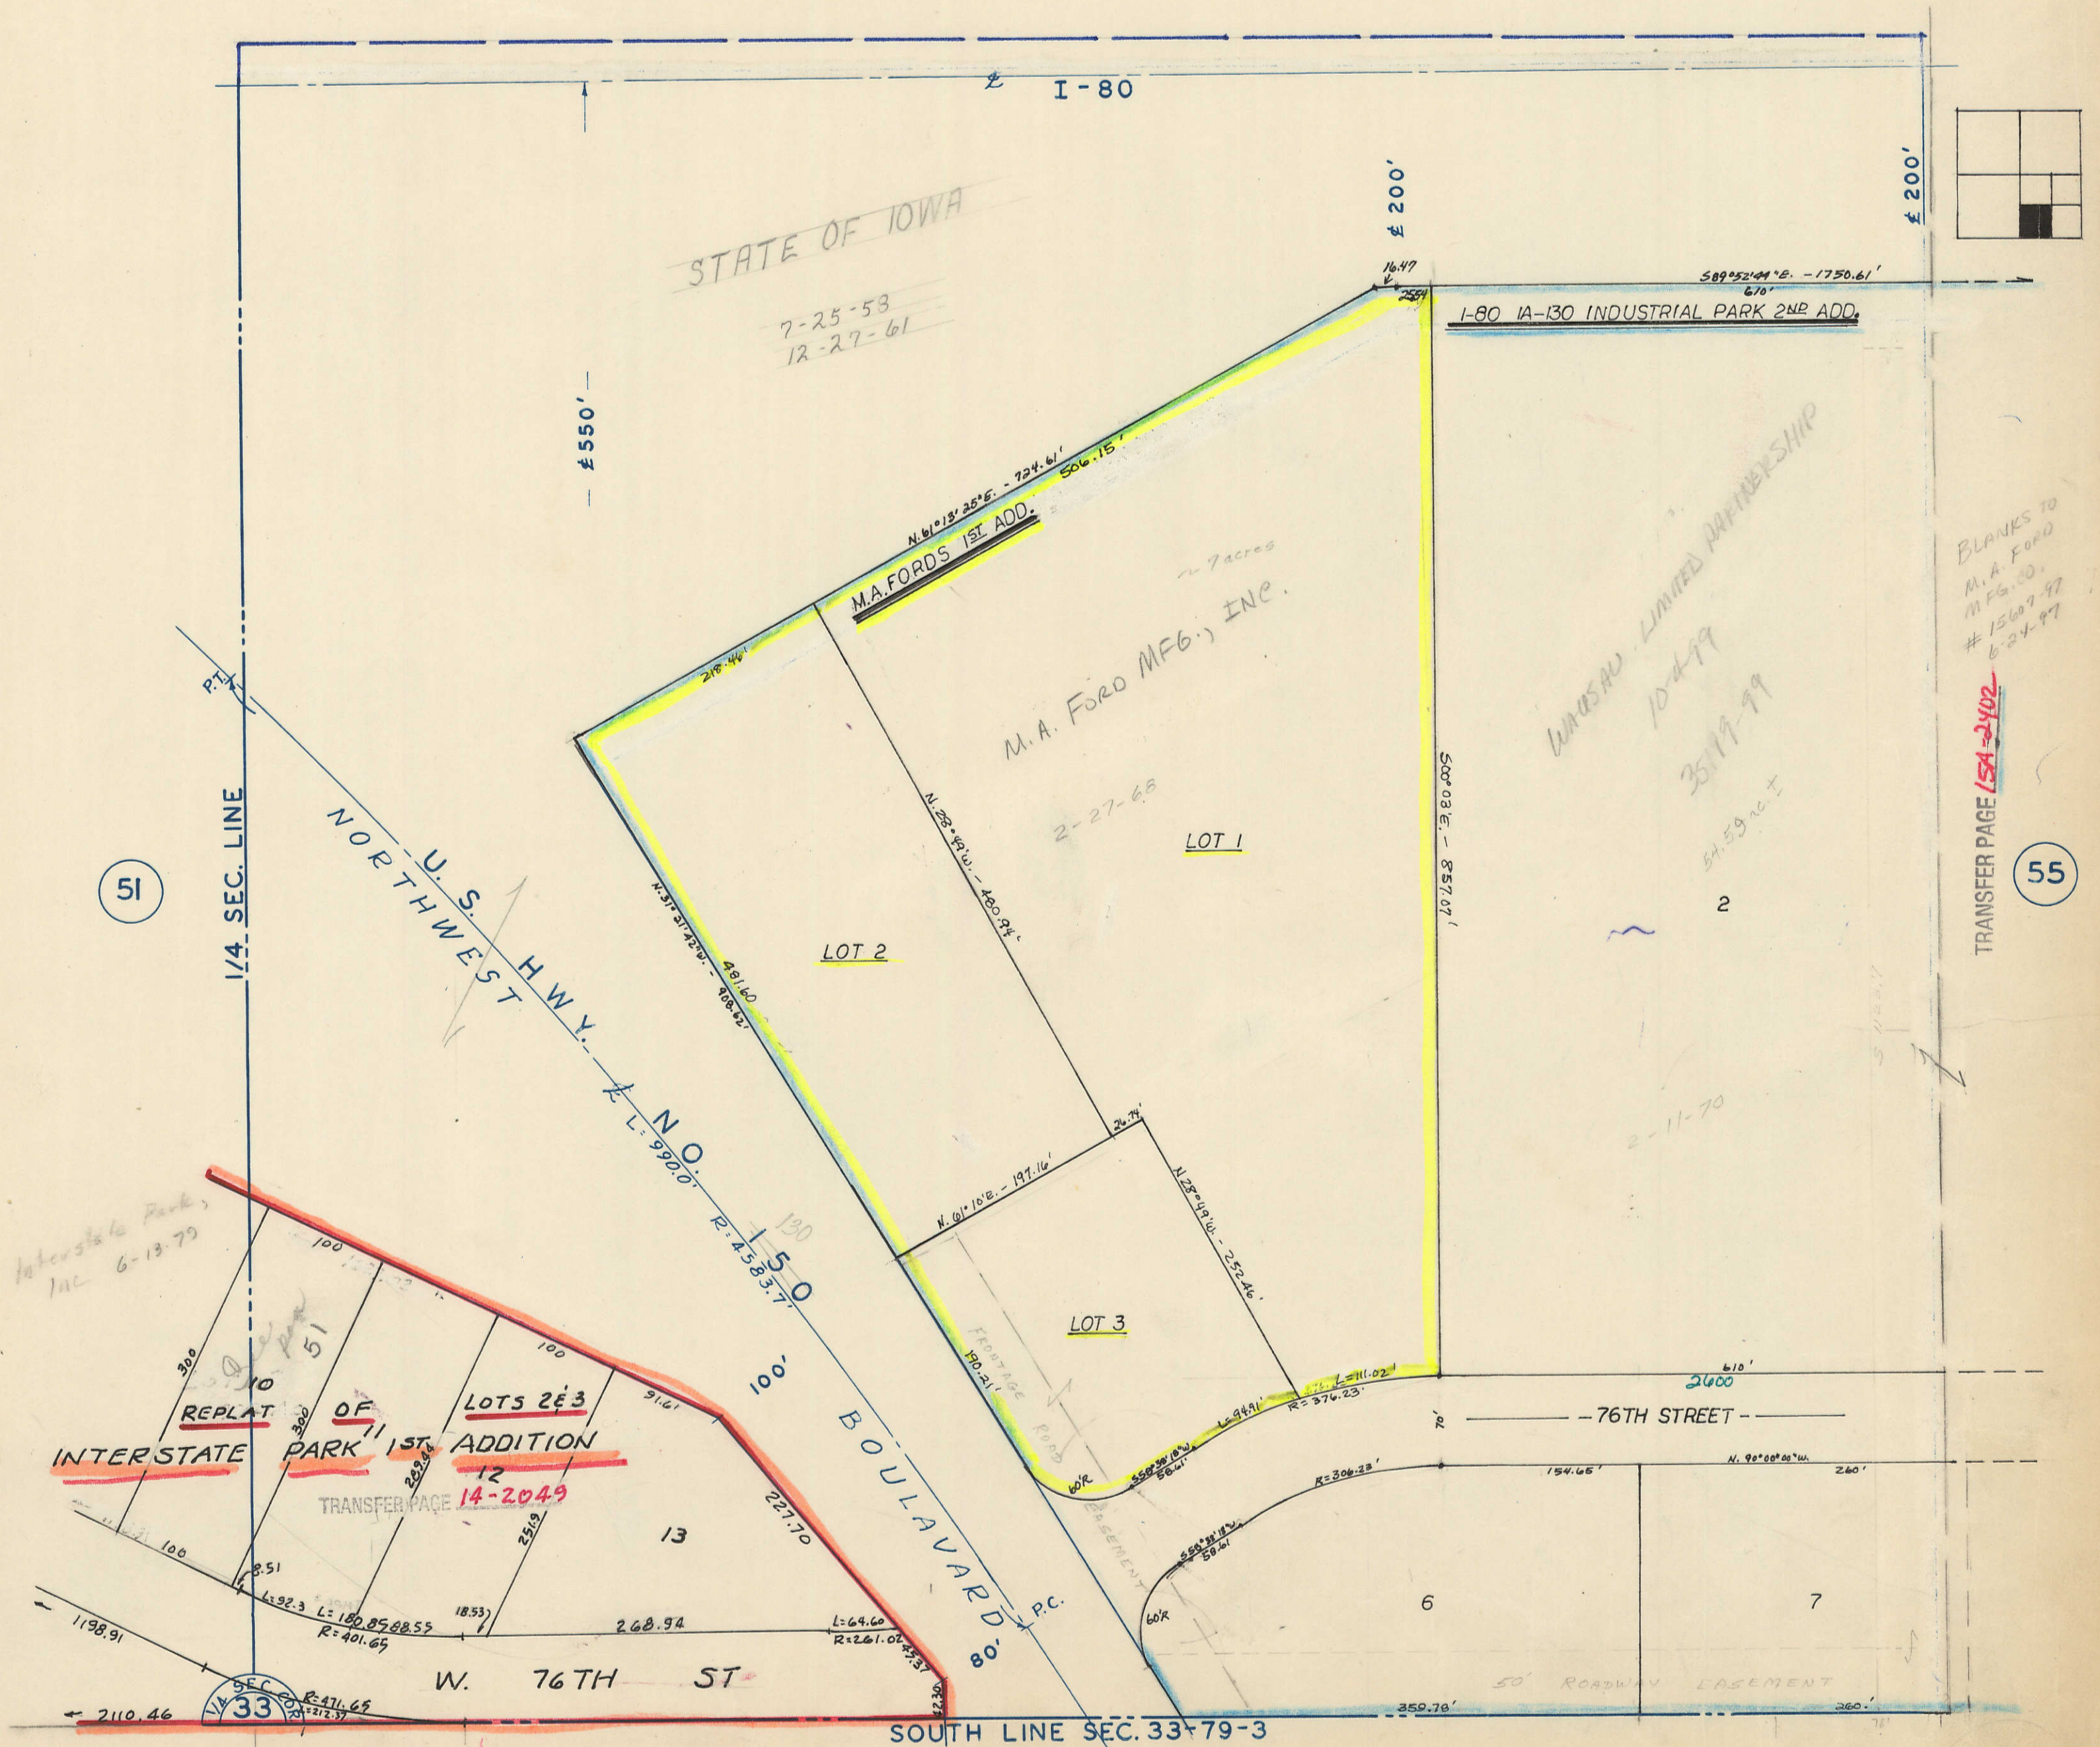

BLANKS TO
M.A. FORD
MFG. CO.
15607-97
6-24-97

10-4-99
35119-99
54.59 ac. ±

Interstate Park,
Inc. 6-13-79

REPLAT OF
INTERSTATE PARK 1ST ADDITION
LOTS 12
13
TRANSFER PAGE 14-2049


TRANSFER PAGE 15A-2402

51

55

5

W-4

7