


37

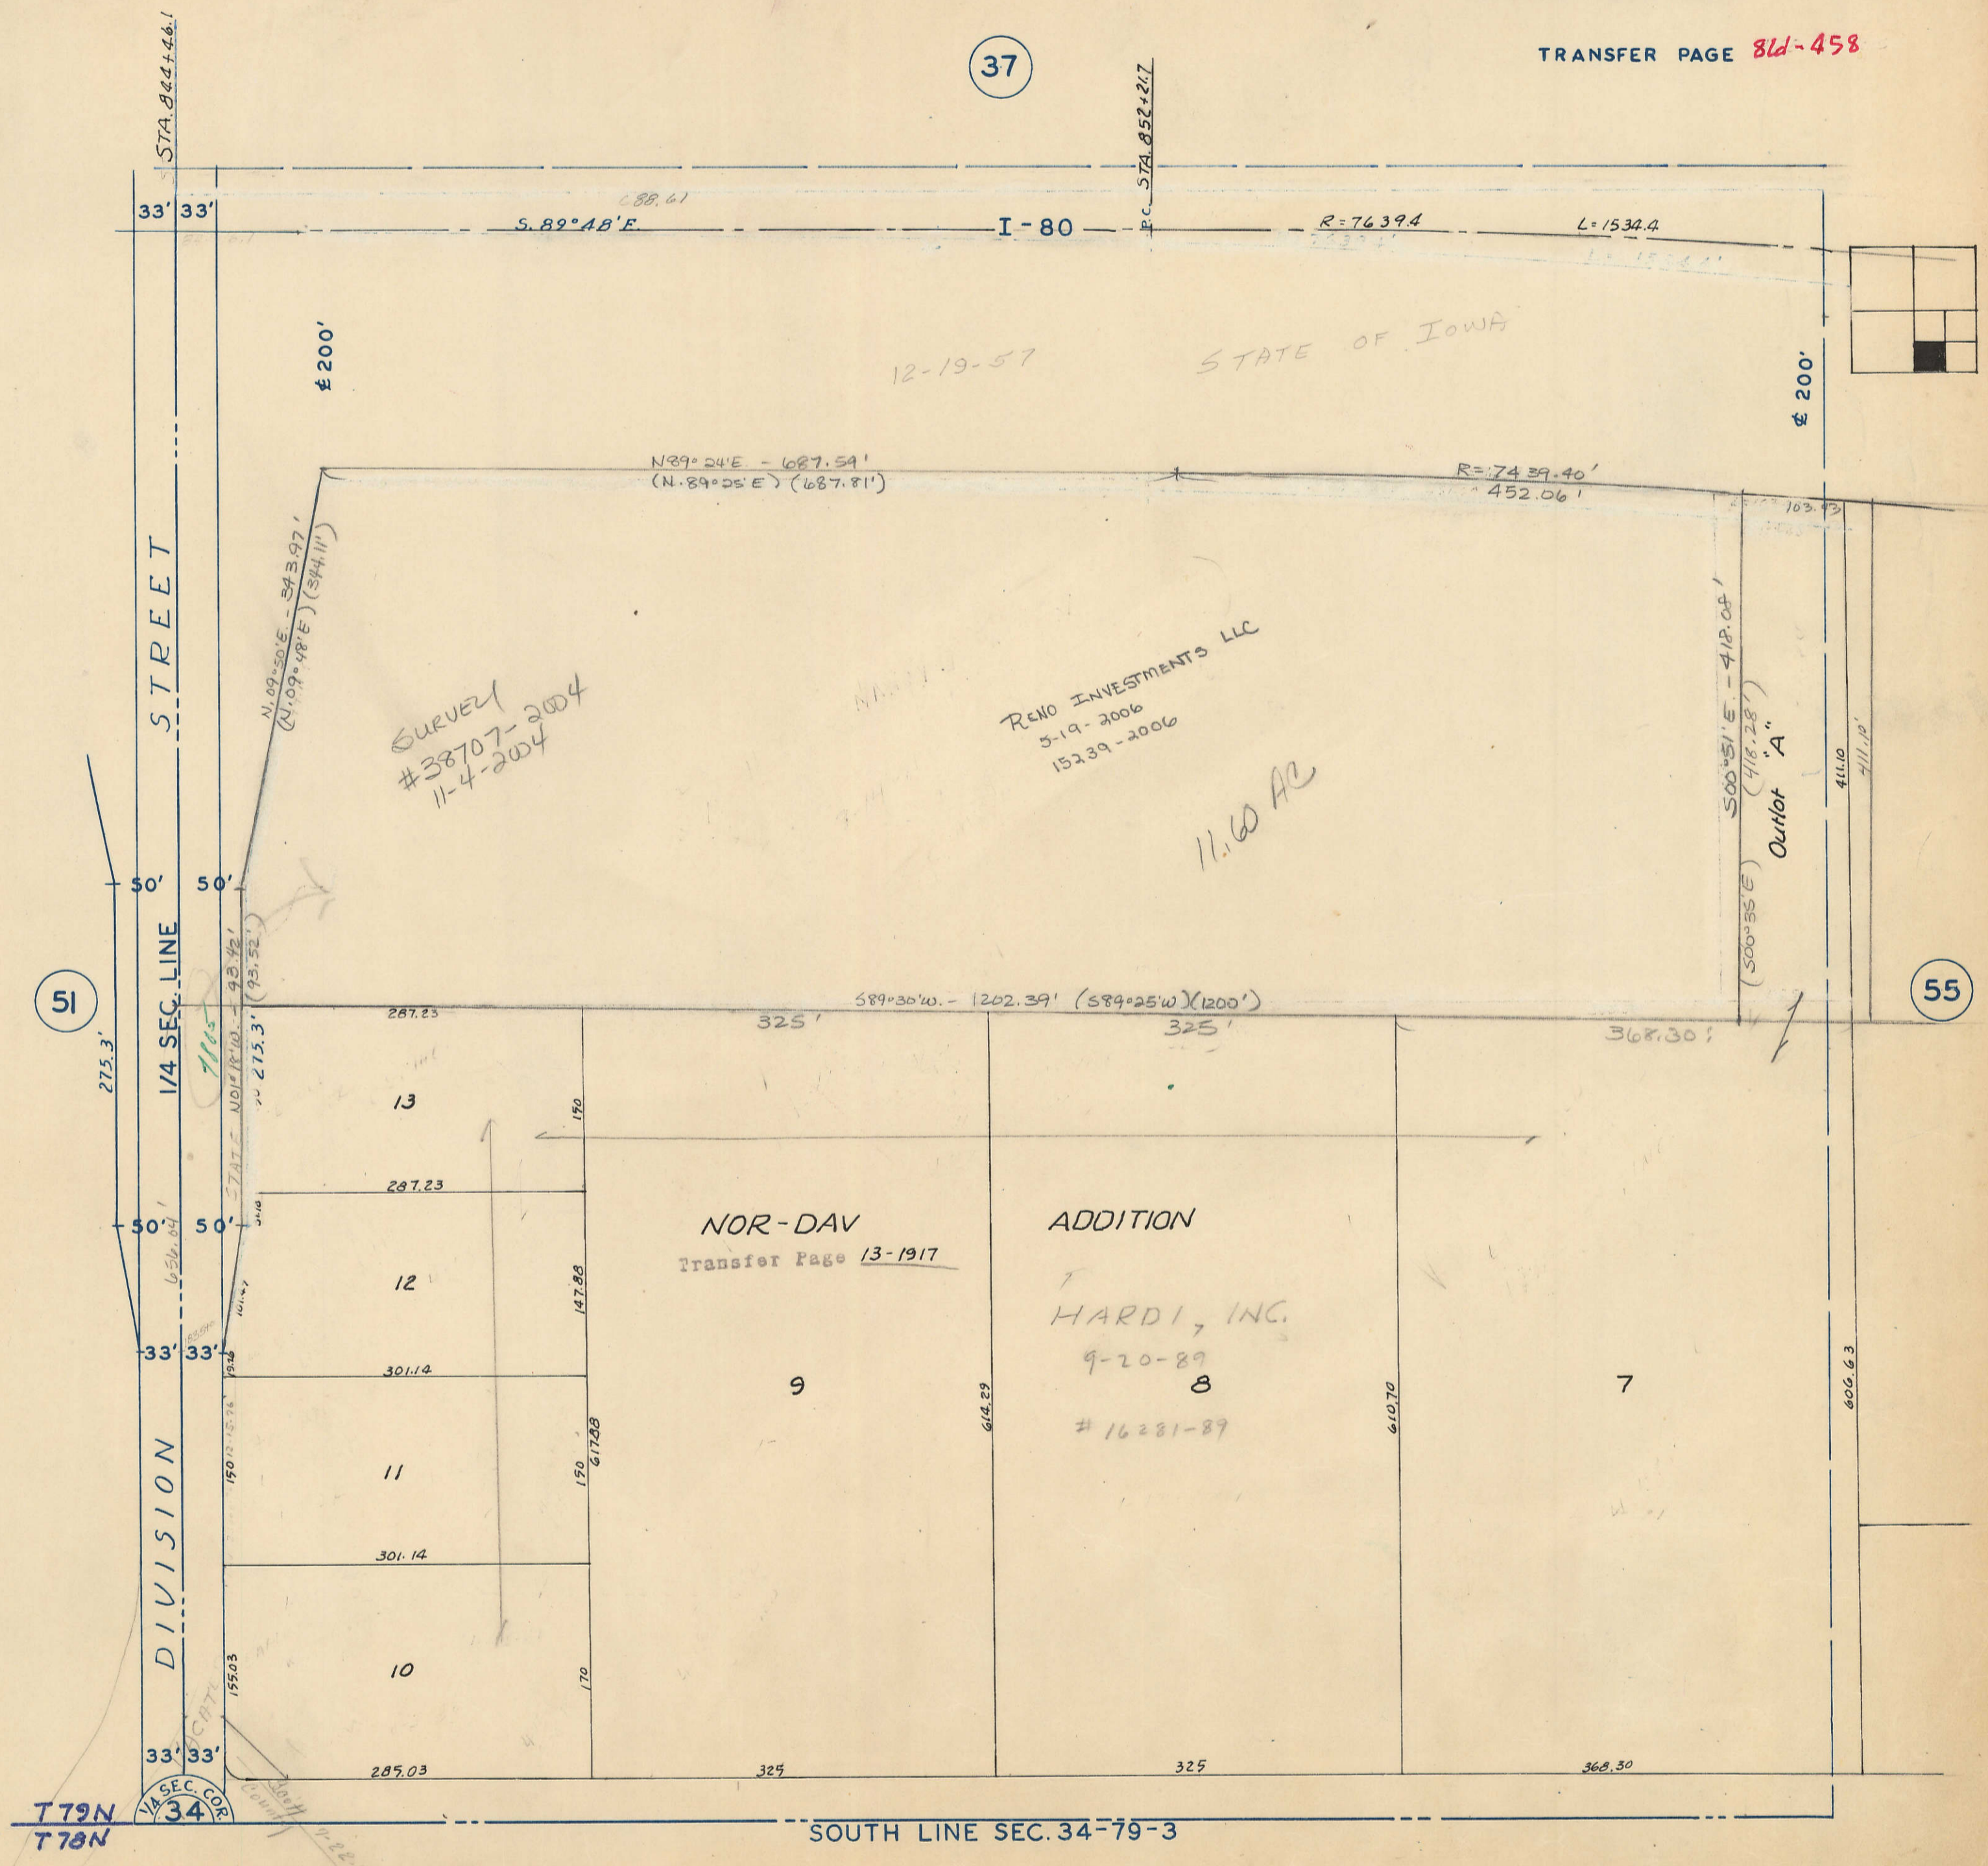

51

55

T79N
T78N
1/4 SEC. COR
34

SOUTH LINE SEC. 34-79-3

5

W-3

7