


23


62ds-171

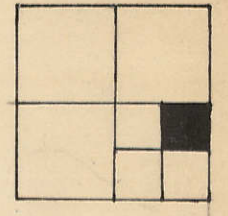

157L-800

37

Survey Error
7-5-80

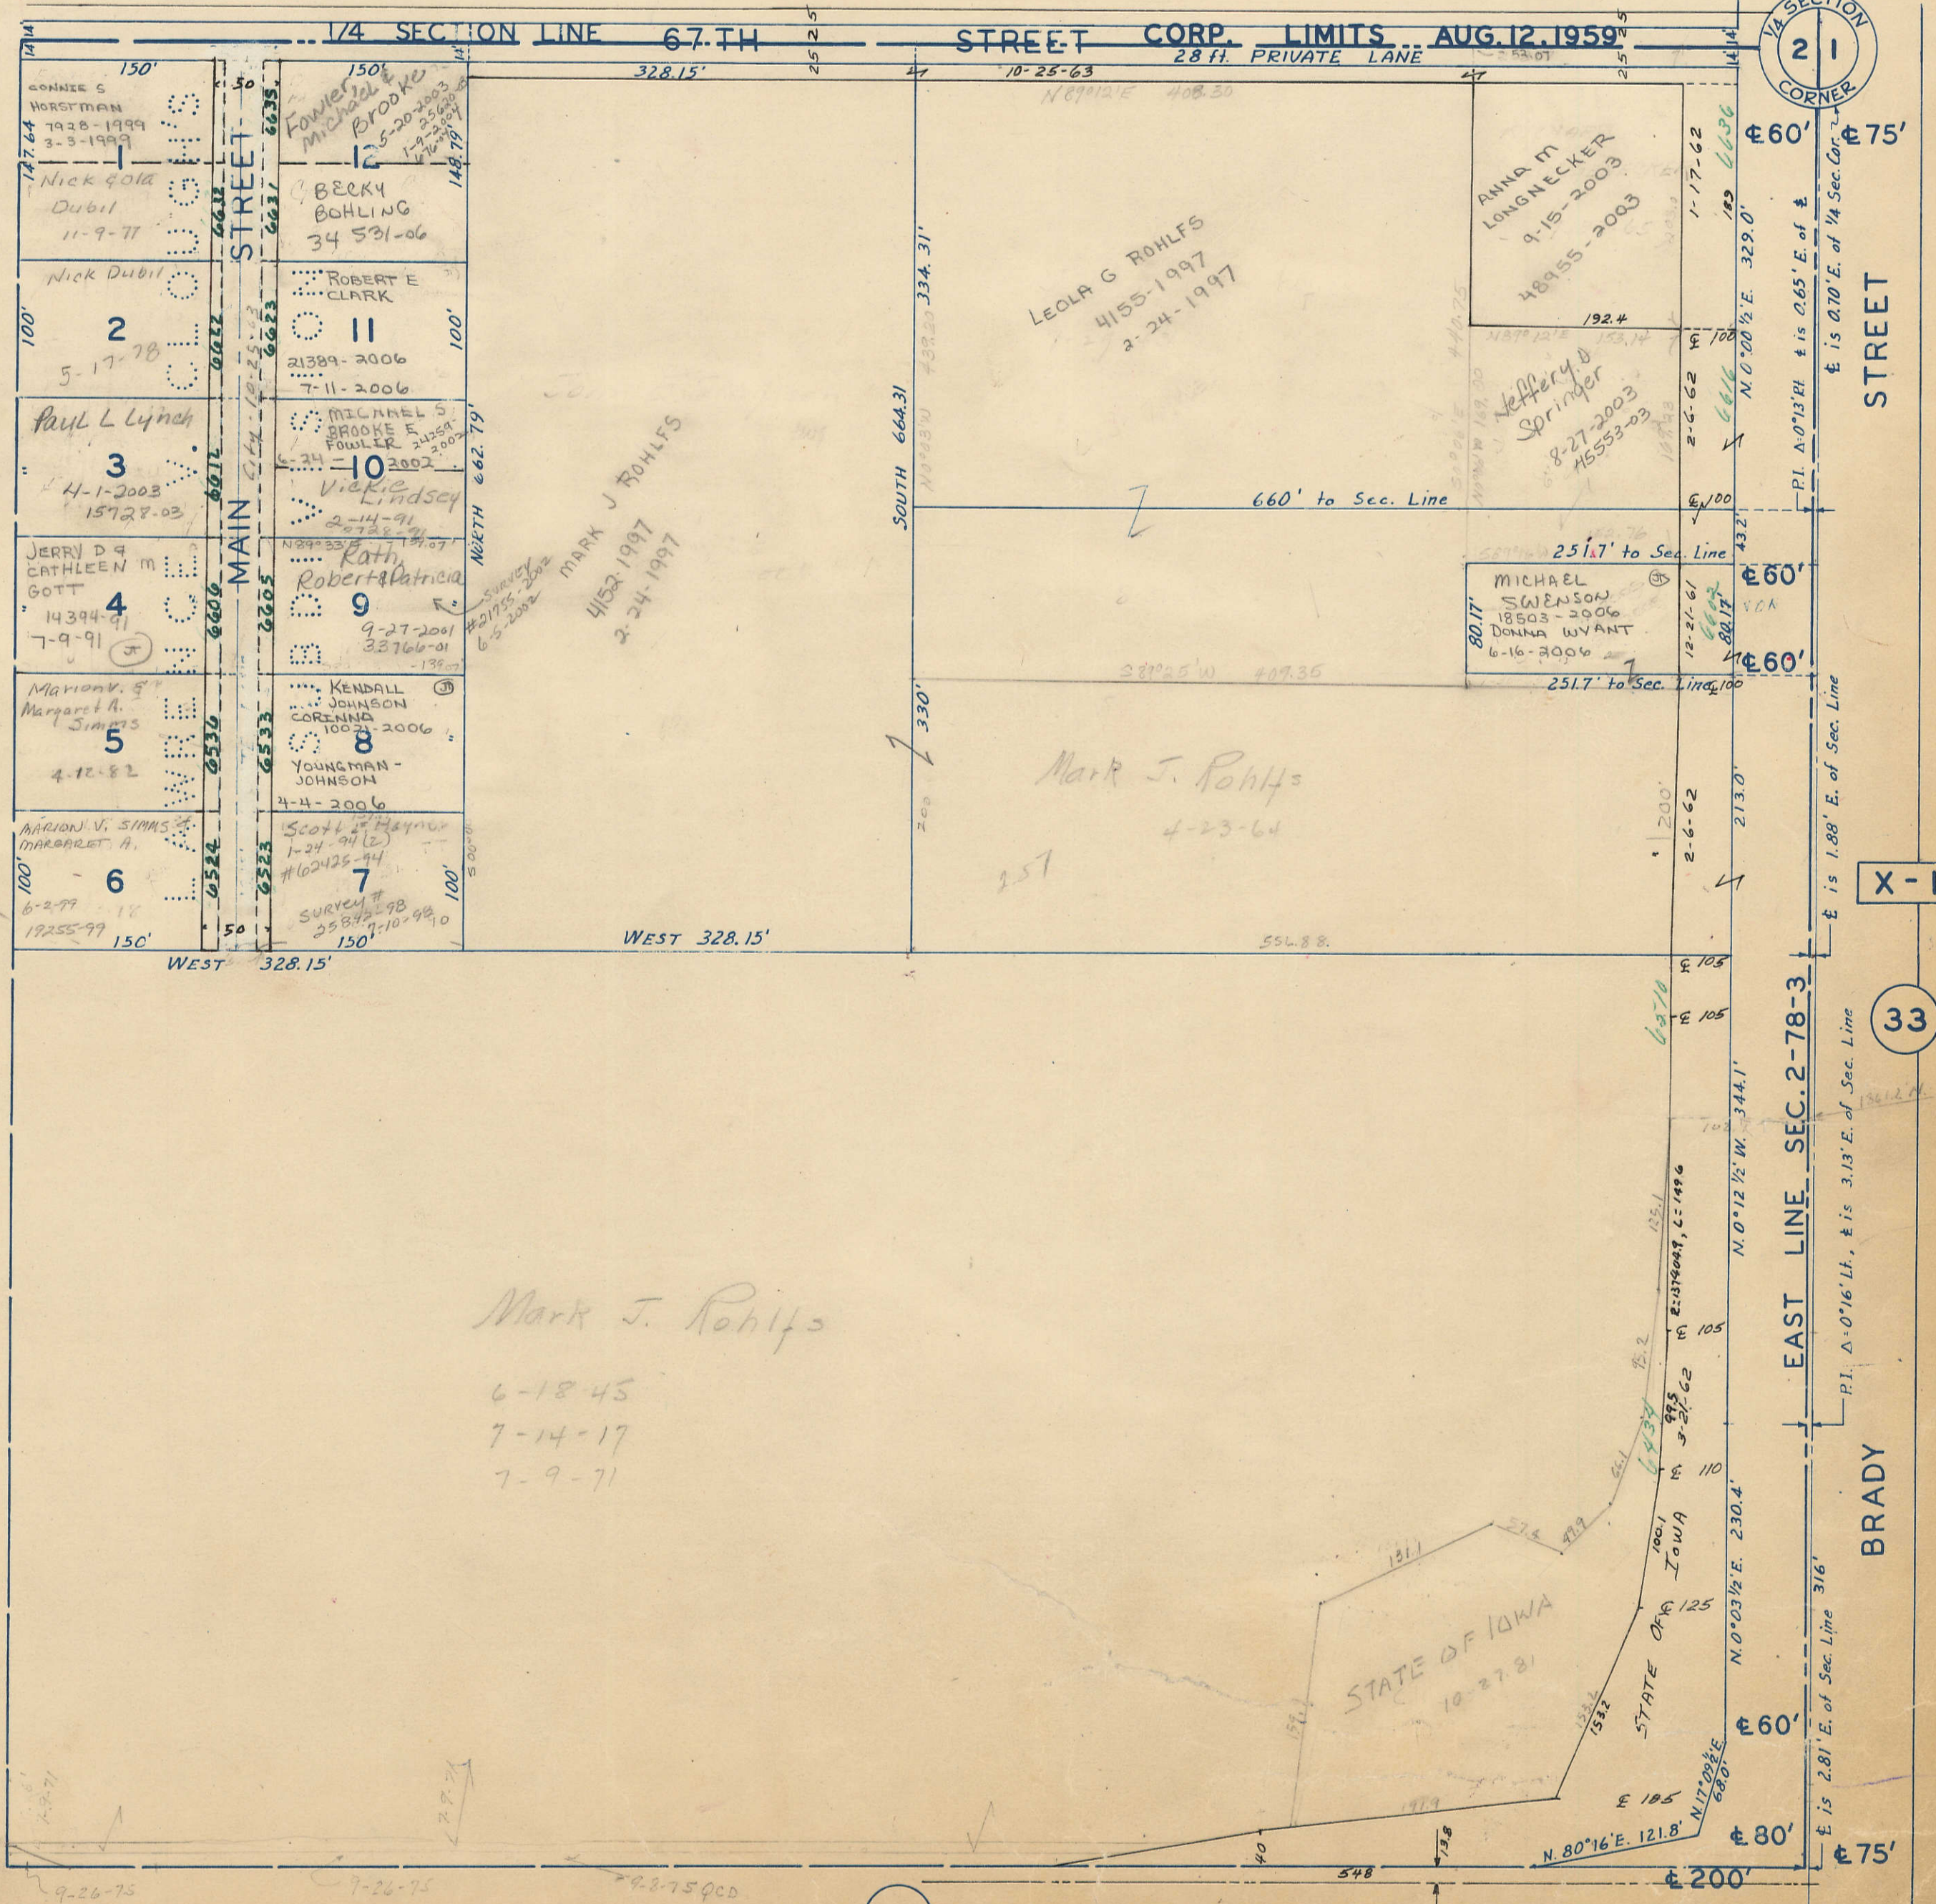

VIA SECTION
CORNER
21

EAST LINE SEC. 2-78-3
PI. Δ=0°16' Lt., & is 3.13' E. of Sec. Line

BRADY

X-1

33

55