


(19)

SEC. 1-78-3


SCALE: 1 IN. = 100 FT.

Transfer Page 62ds-170

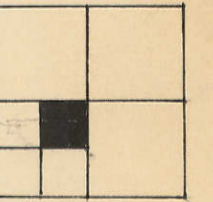

CORP. LIMITS AUG. 12, 1959
1/4 SECTION LINE

SECTION
I
CENTER

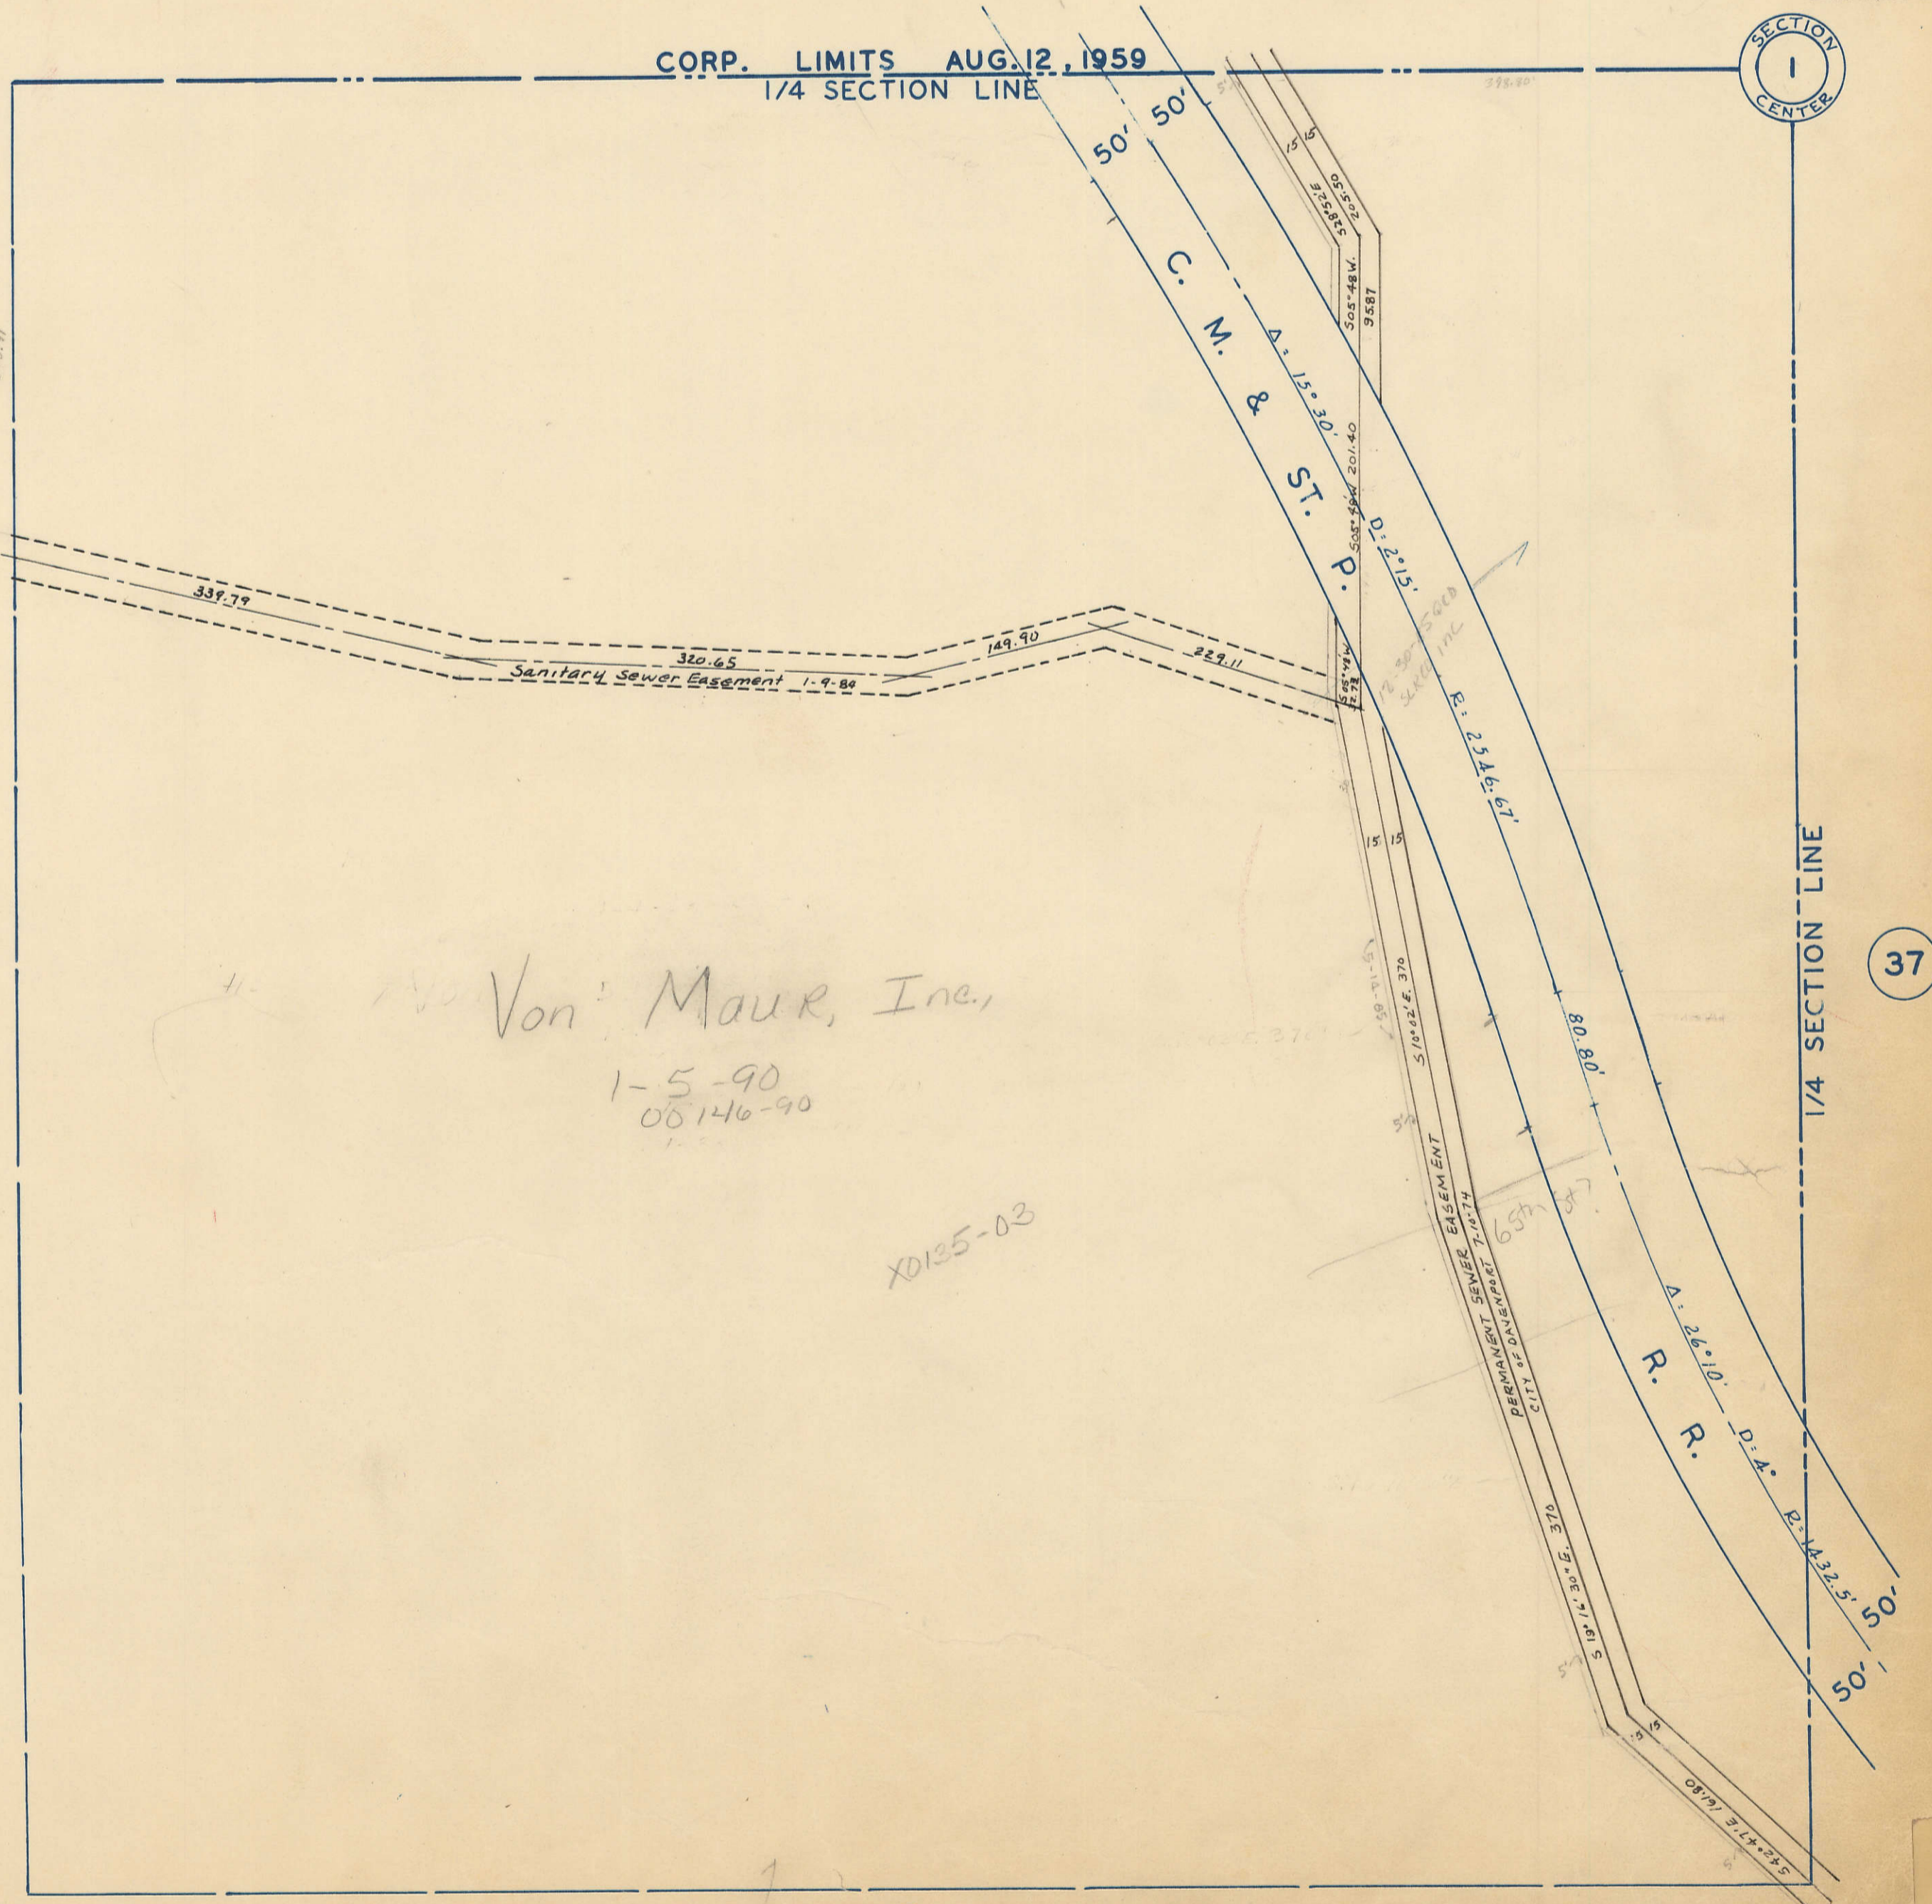

33

37

Von Maur, Inc.,

1-5-90
00146-90

X0135-03

51