



TRANSFER PAGE 61ds-181

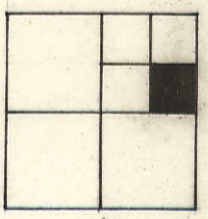

7

N 88° 03' E. - 535'

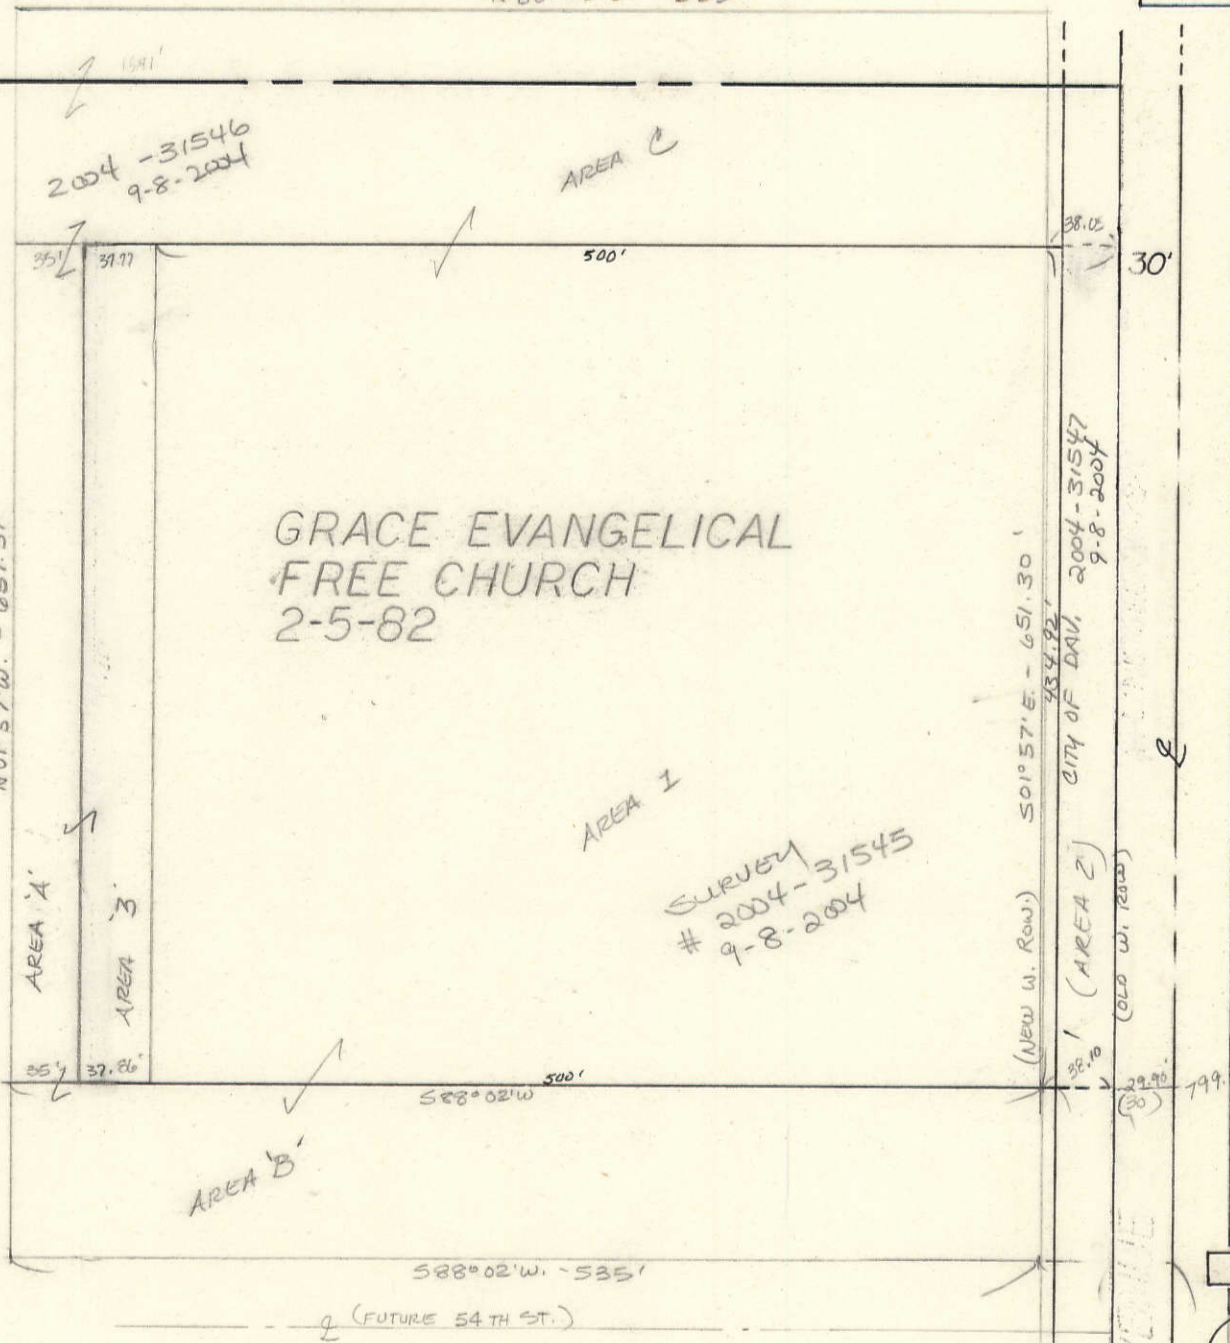

City of Davenport

11-10-97  
30793-97

92.74 AC

21

Y-7

17

CORP LIMITS 1-22-1959

CITY OF DAV. 1-26-79

53<sup>RD</sup> STREET

1/4 SEC. LINE

12-7

NOTE: S. LINE OF NE 1/4 SEC. 12-78-3 MEASURES 2882.63'

P-12

12