

LEXINGTON GREEN
CONDOMINIUMS

515 Douglas L. & Diane L. Peyton JT 36499-06
11-22-06

517 City of Davenport 18969-2006


12686-2007
(CONT)
5-3-2007 9-7-93

519 ADAMS (AKA MC COY) NOLAN 25962-93

521 Condon, John & Dorothea 4-25-95
8410-95
8411-95


3-9-01
6419-01

SCALE: - 1" = 100'
5.33° 57' E, 32.00

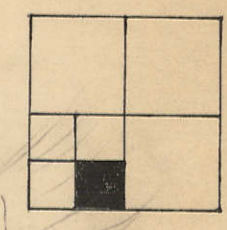

AMERICANA PARK THIRD ADDITION
REPLAT LOT 9 AMERICANA PARK THIRD

14-1971(1-26)
14-1971 1/2 (27-36)

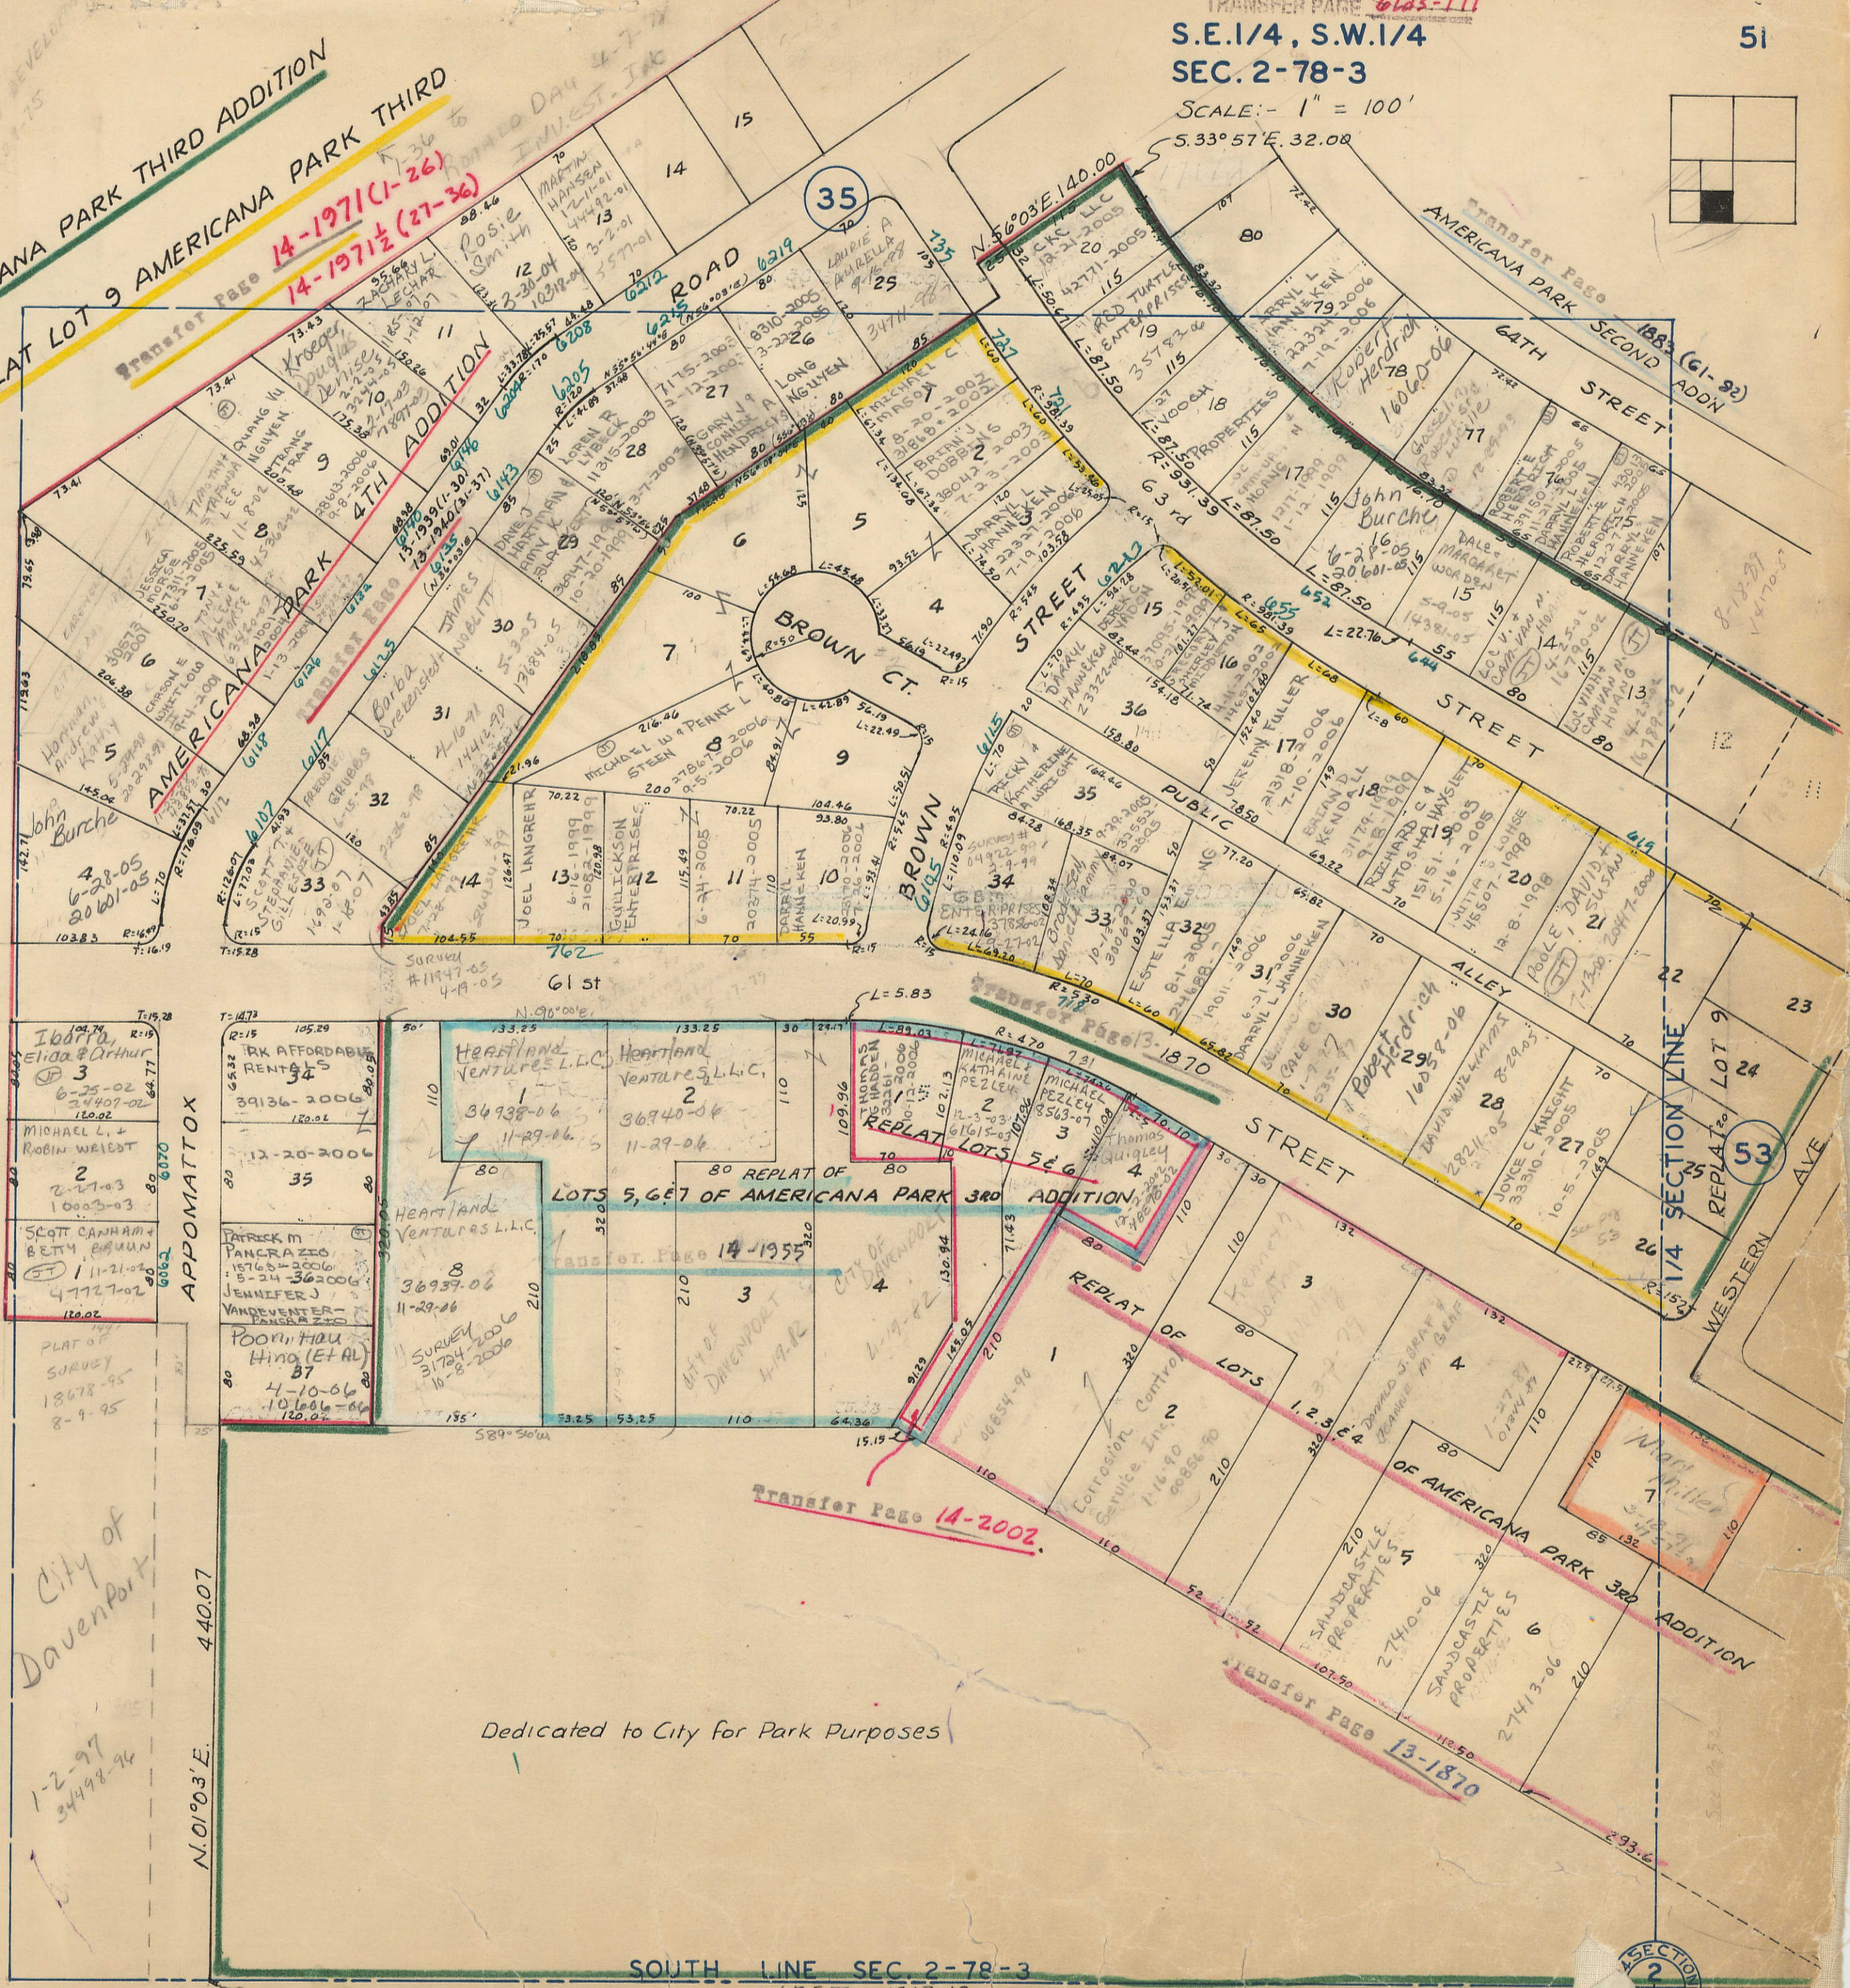

49

53

City of Davenport

Dedicated to City for Park Purposes

SOUTH LINE SEC 2-78-3
WEST 137.19

X-II

3

SECTION 2
CORNER