


SHERIDAN TOWNSHIP SE 1/4 NE 1/4 SEC. 36

TRANSFER PAGE 8lds-460

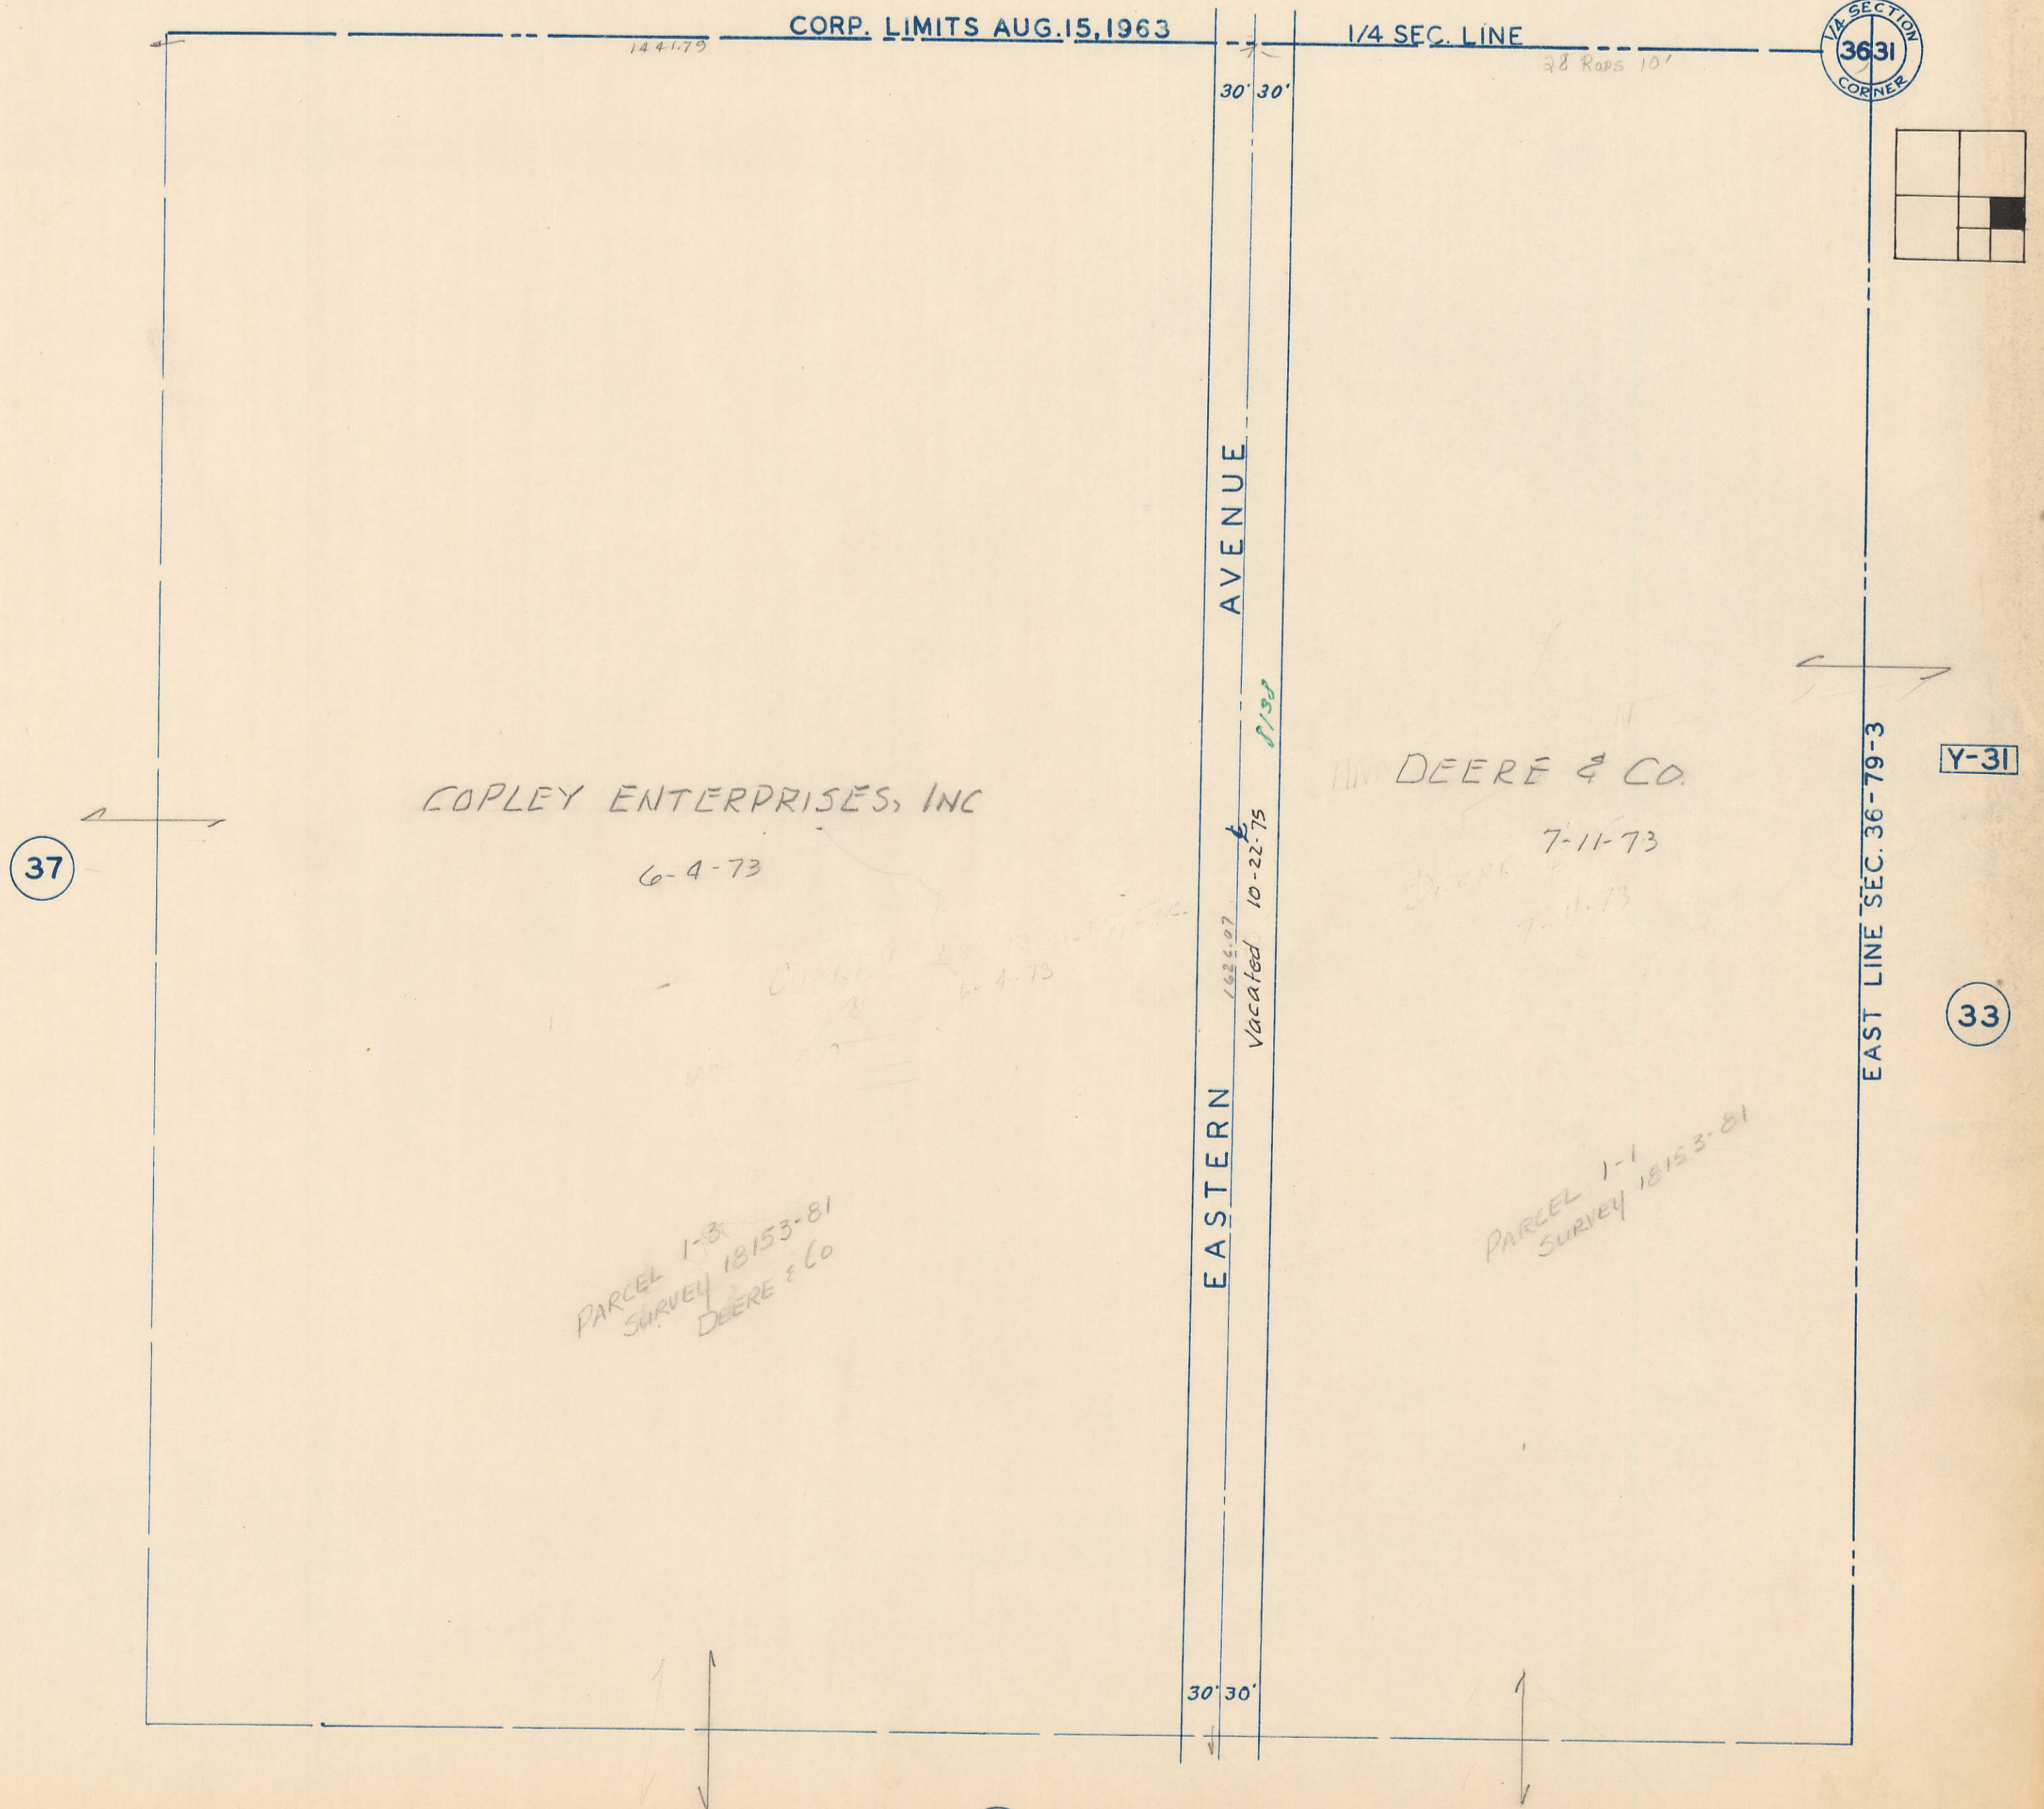

37

COPLEY ENTERPRISES, INC

6-4-73

PARCEL 1-1
SURVEY 18153-81
DEERE & CO

EASTERN AVENUE

EASTERN AVENUE

1/4 SEC. LINE

EAST LINE SEC. 36-79-3

1/4 SECTION
CORNER
3631

Y-31

33

55

38 Raps 10'

30' 30'

30' 30'

Vacated 10-22-75

8/98

1624-97

7-11-73

PARCEL 1-1
SURVEY 18153-81

