S.E.1/4, S.E.1/4
SEC. 35-79-3
SCALE: 1 IN. = 100 FT.
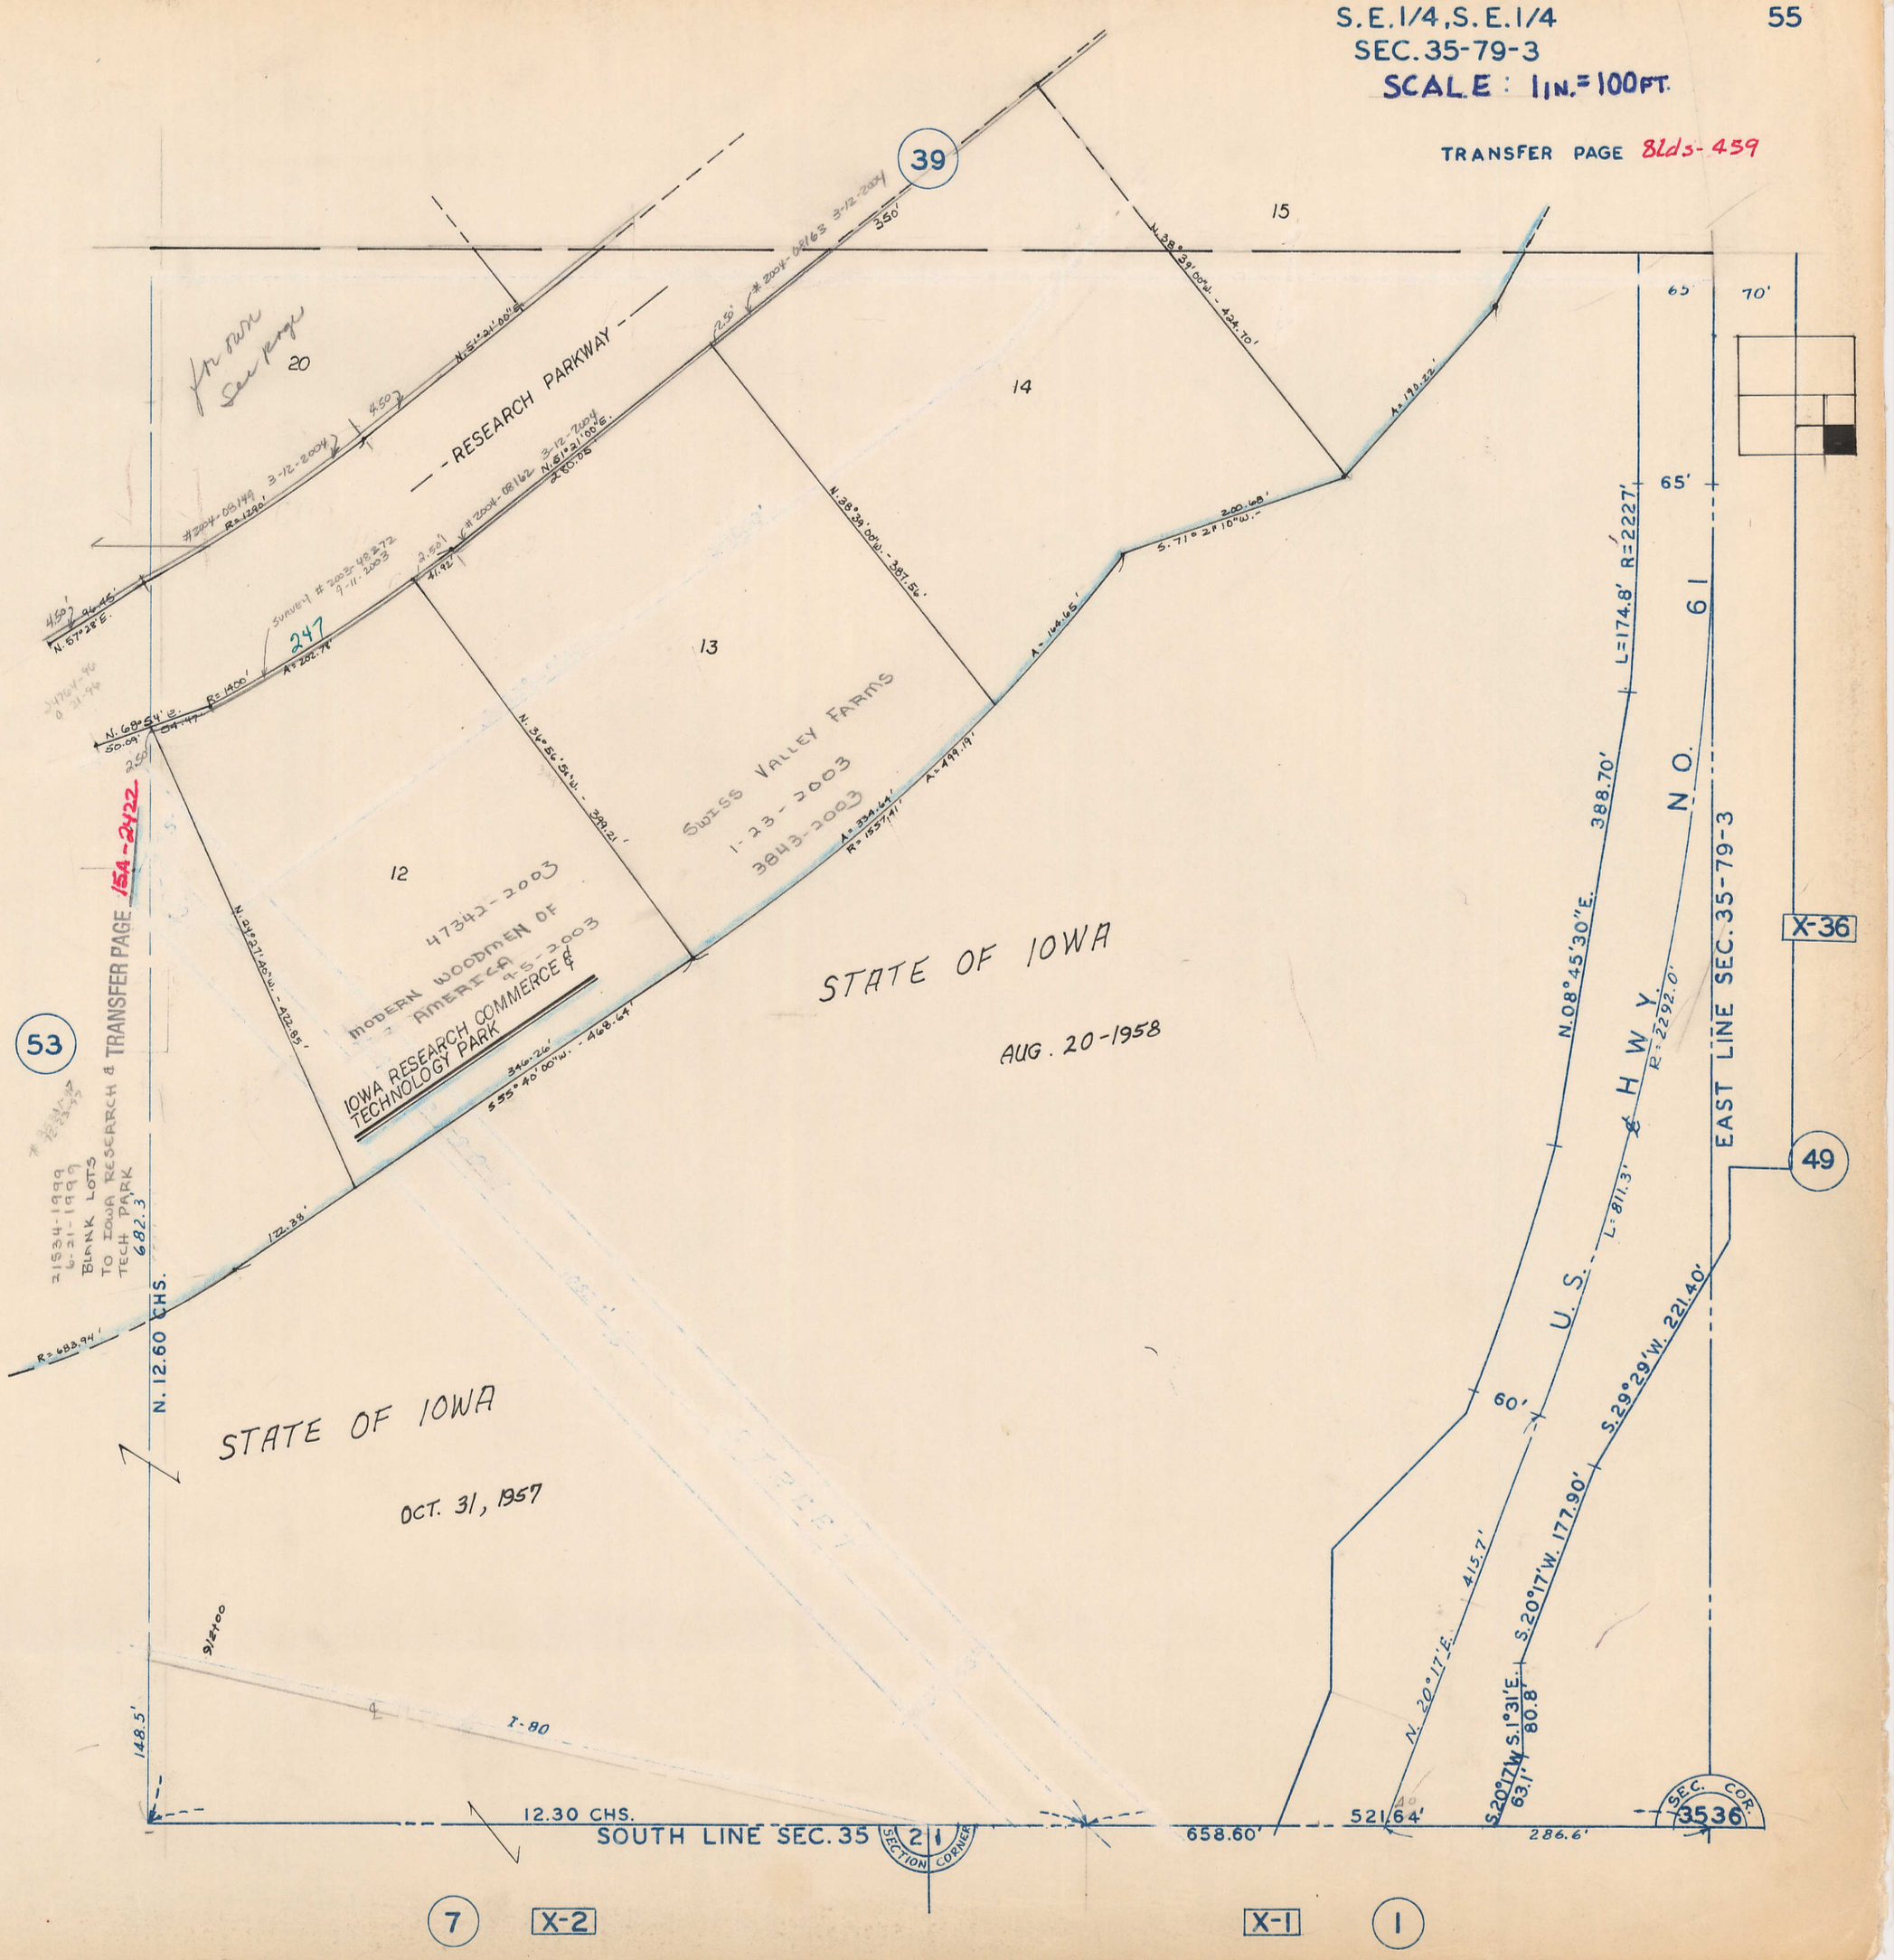
TRANSFER PAGE 8lds-459