
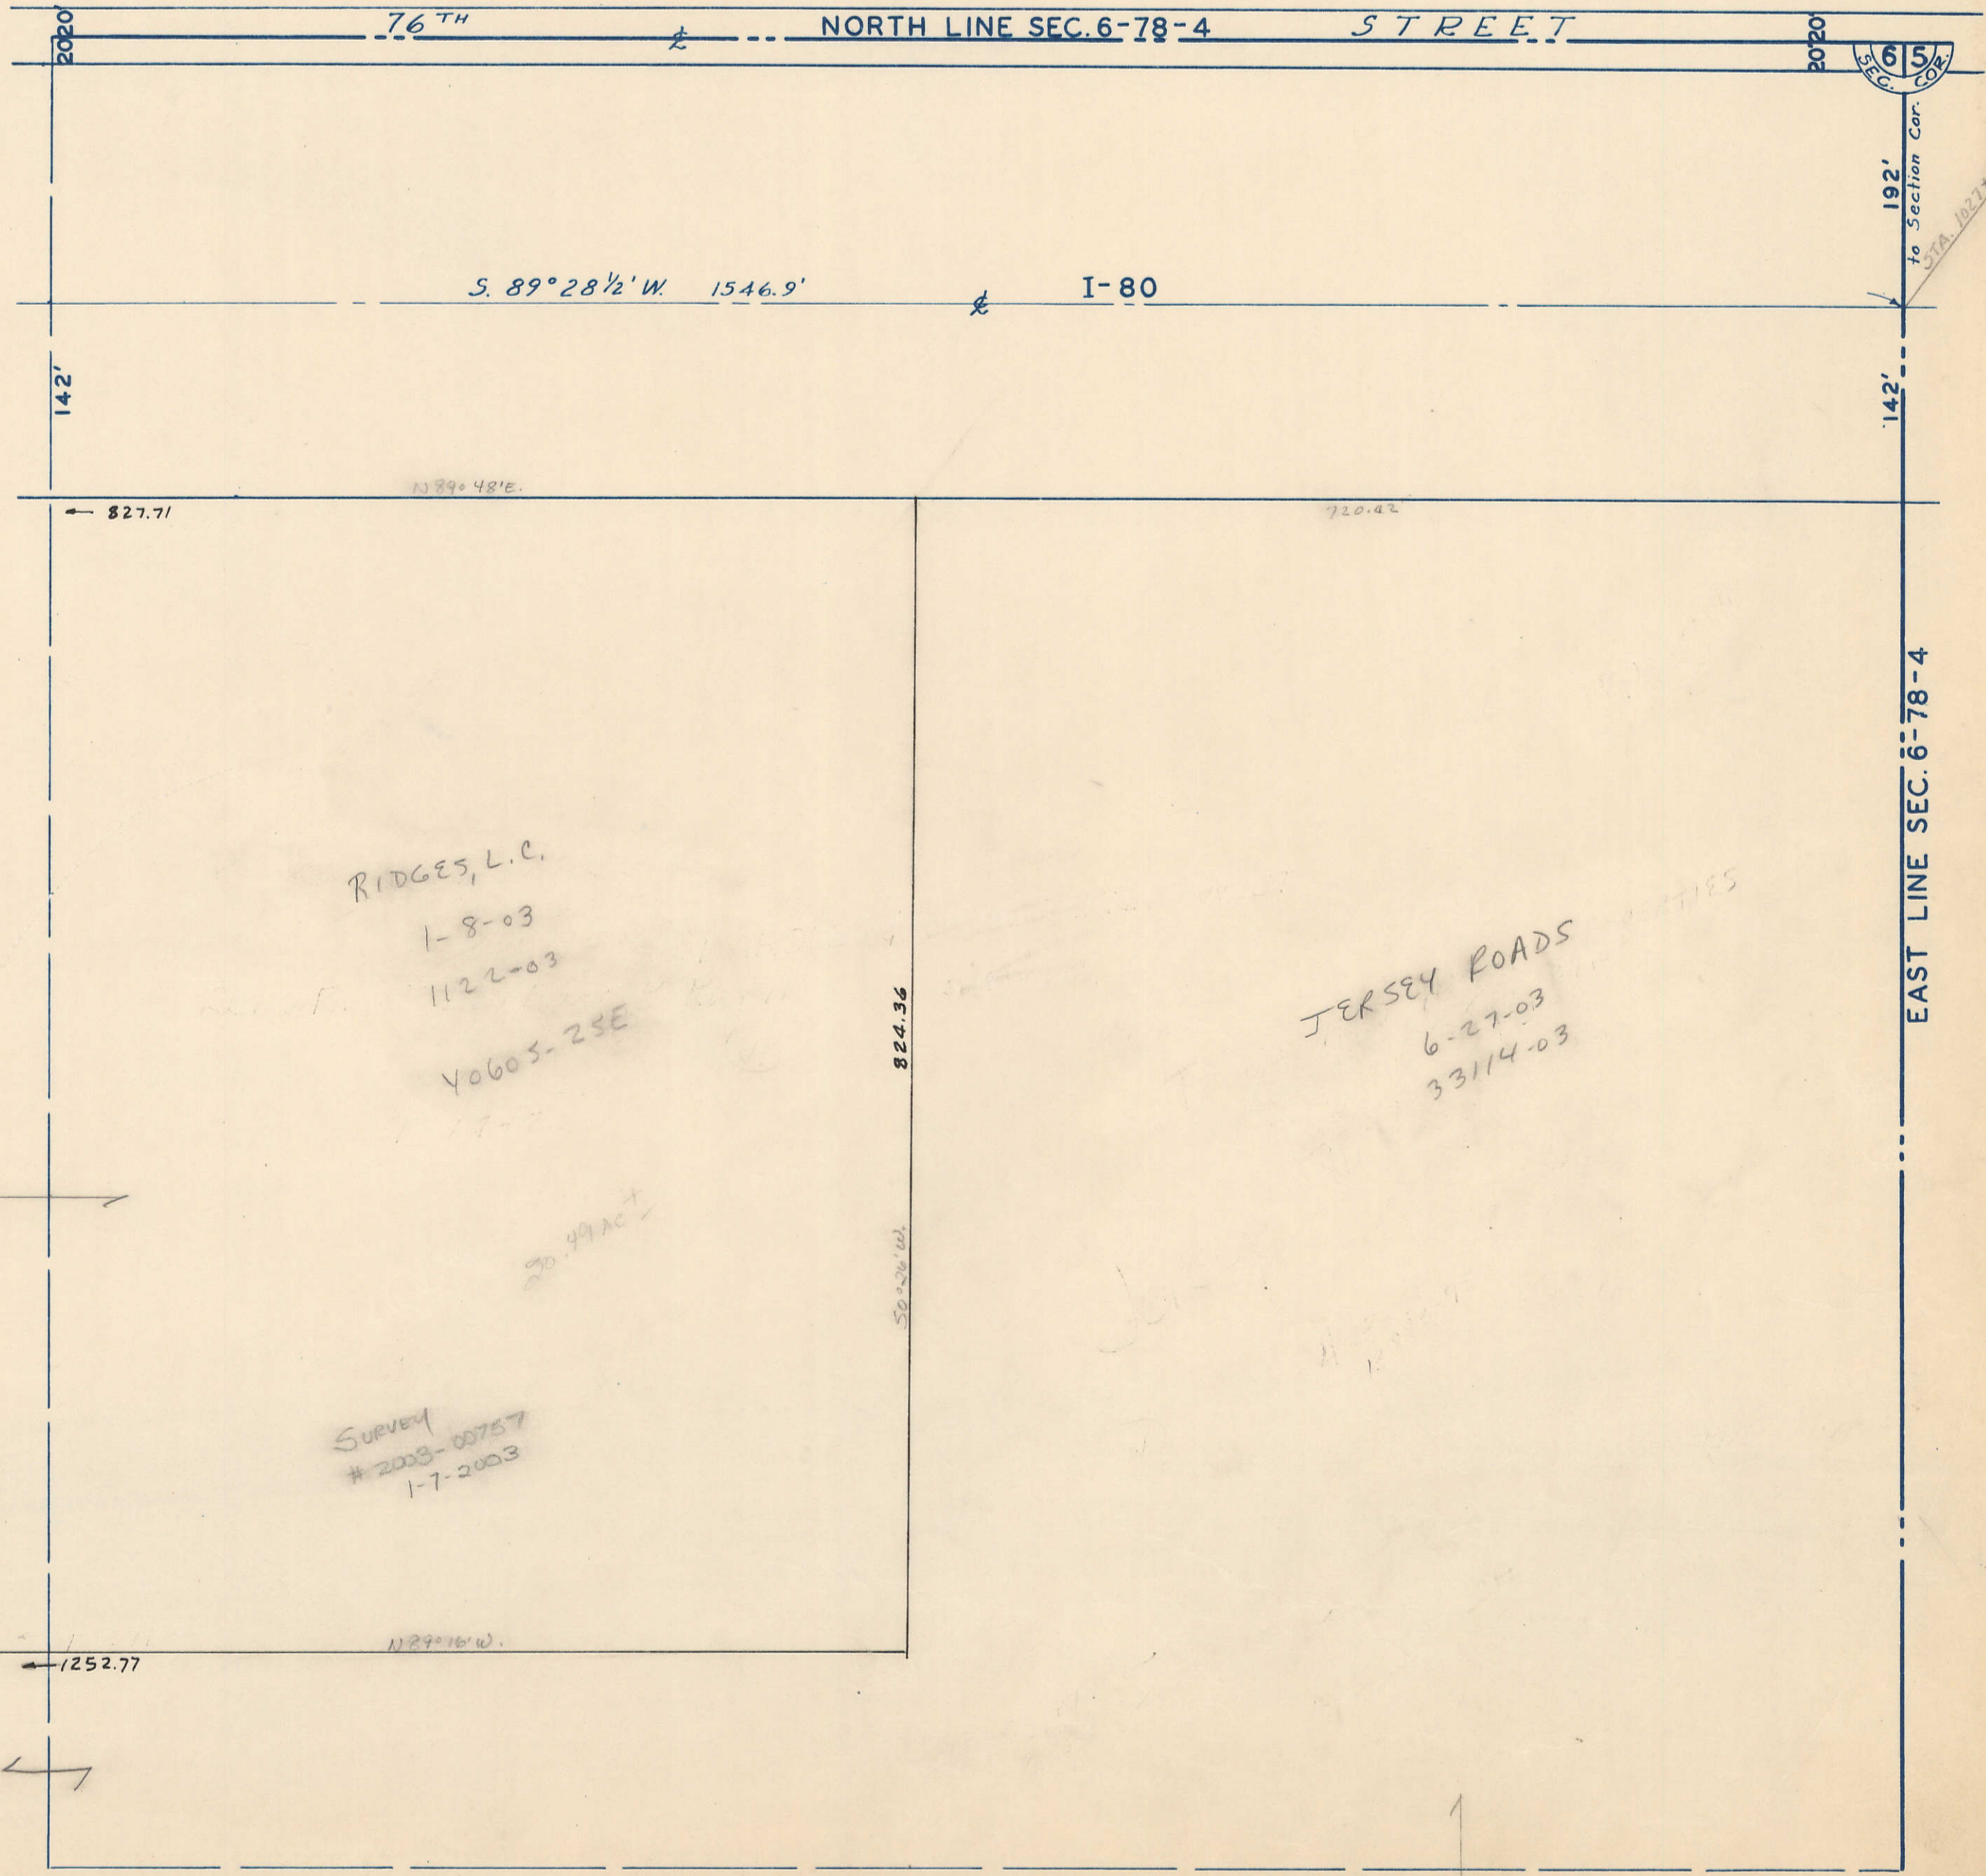


53

Y-31

55

TRANSFER PAGE 661s-207

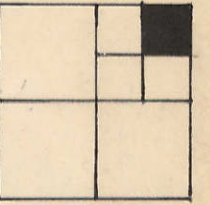

5

Y-5

1

23