


55

Y-31

49

Y-32

TRANSFER PAGE 64ds-206

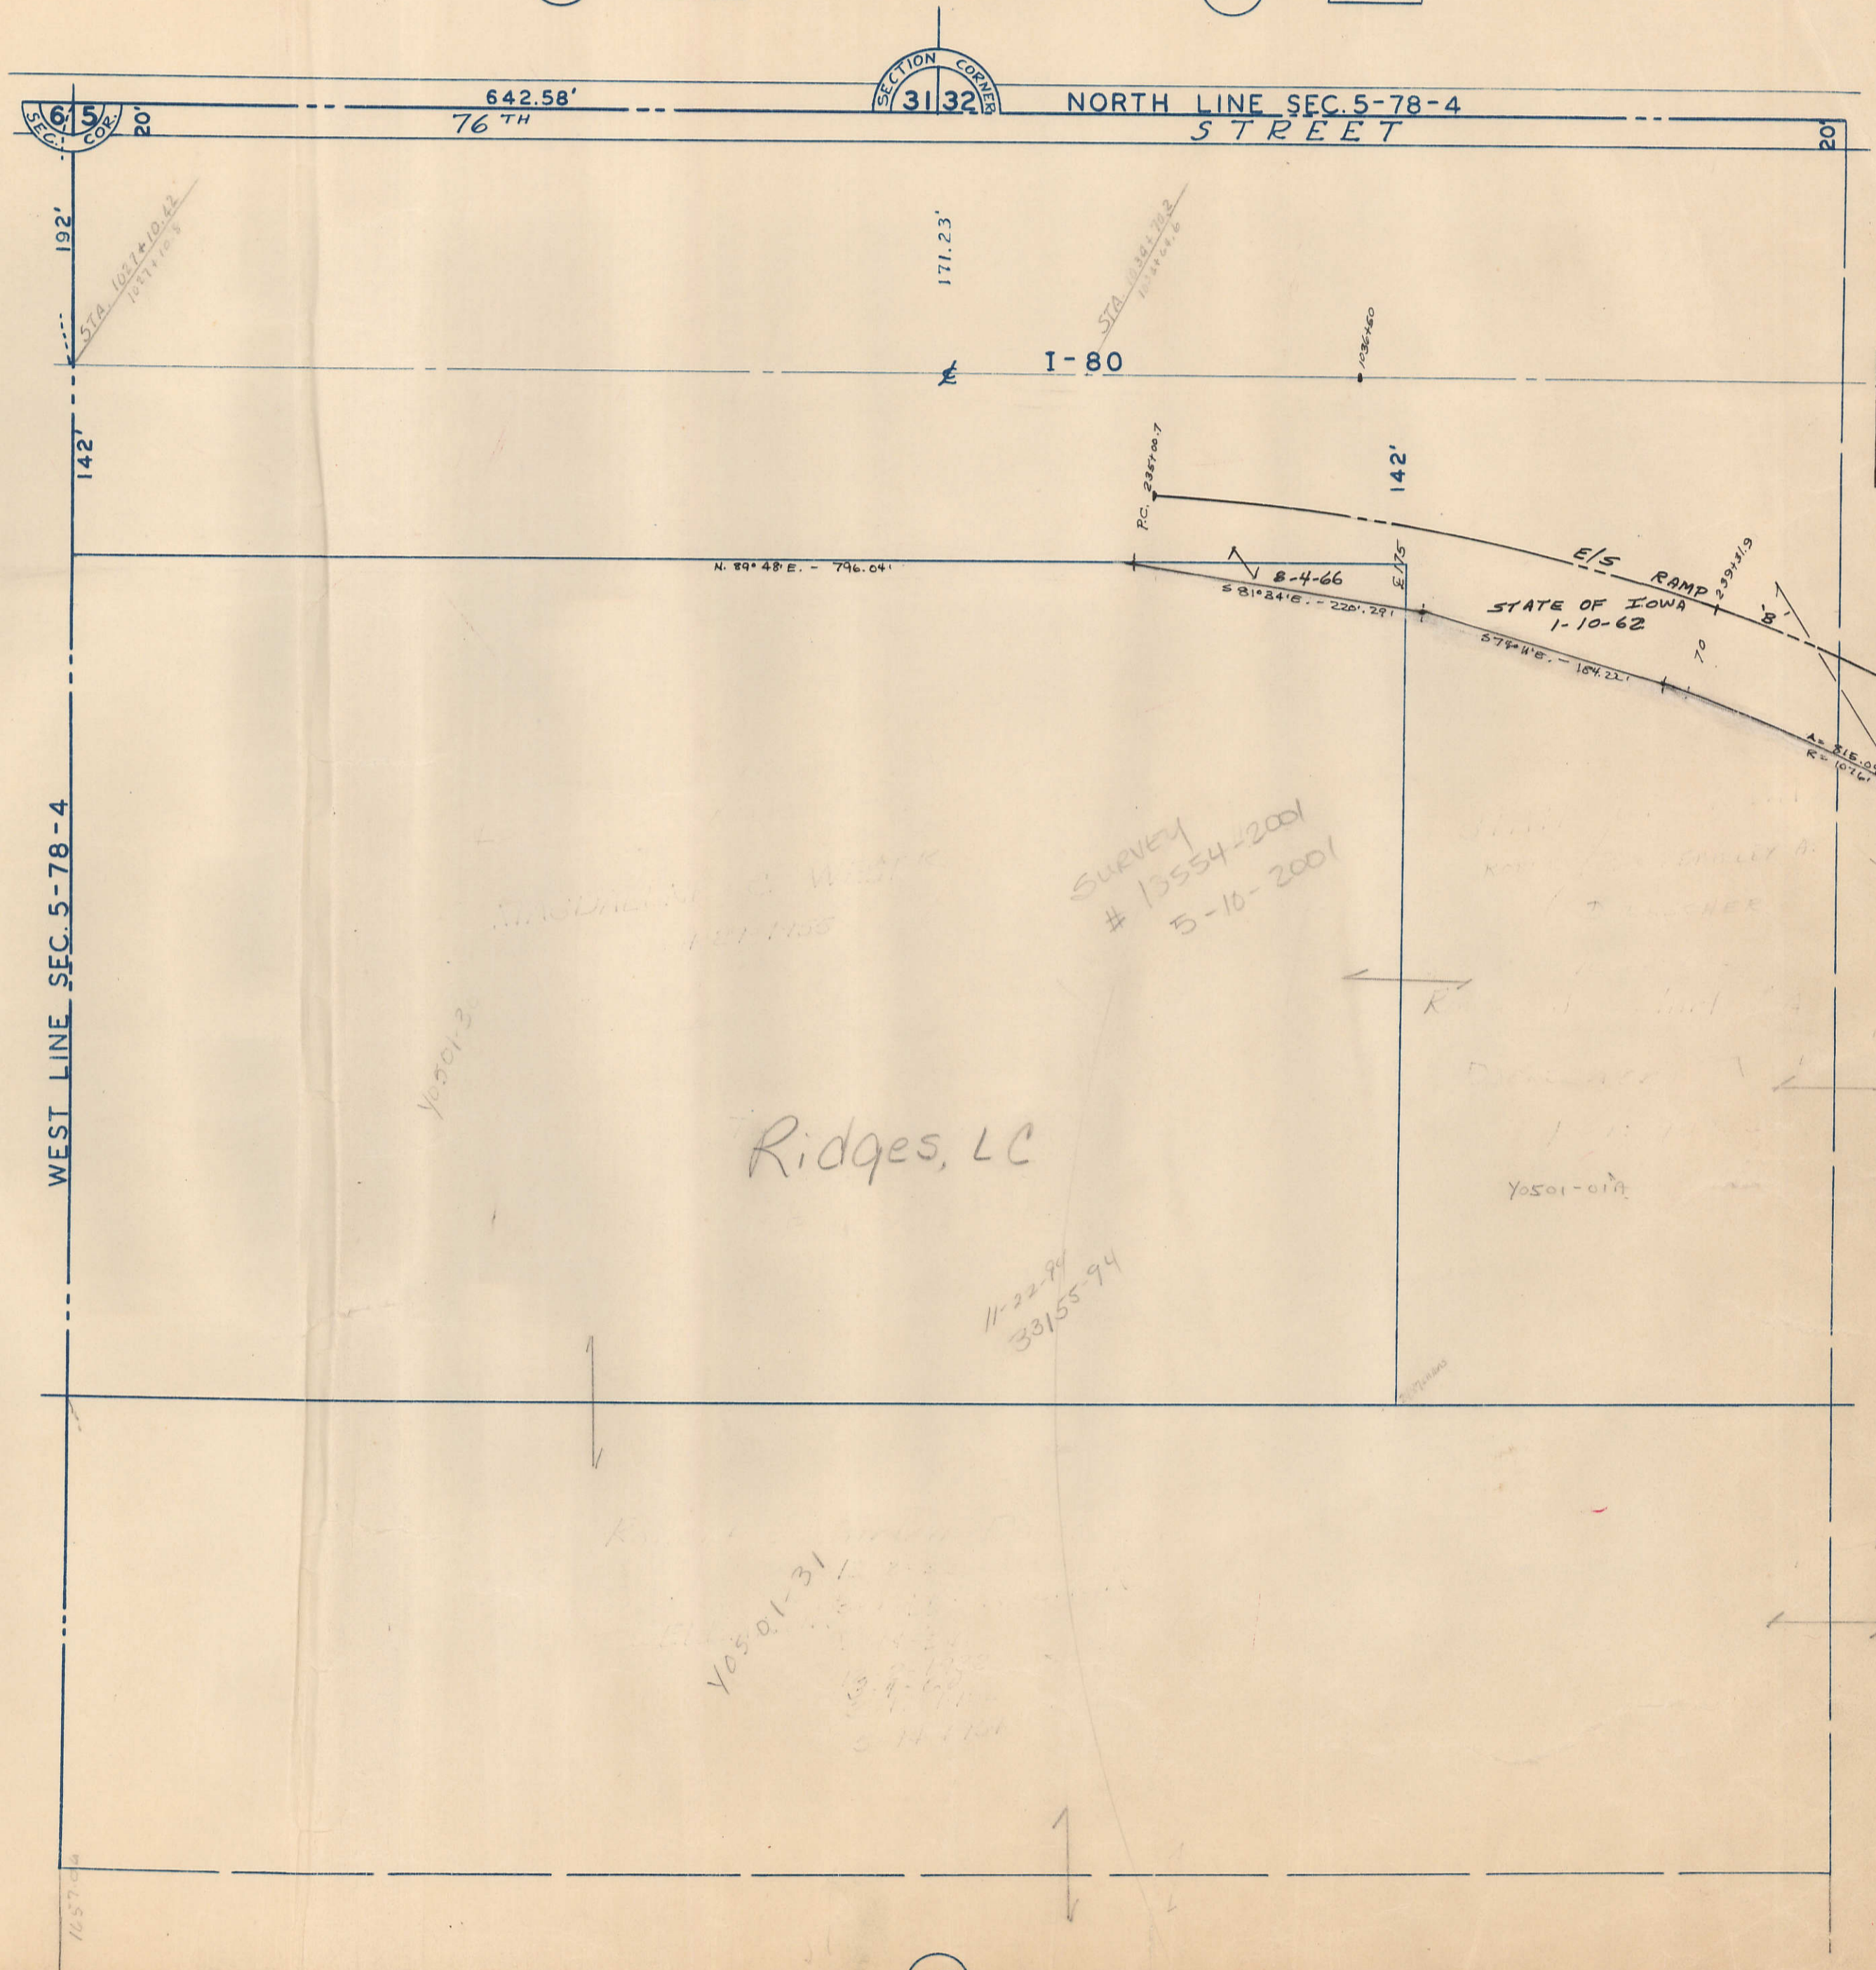

Y-6

7

3

17