


Y-5

49

Transfer Page 6Ld-209

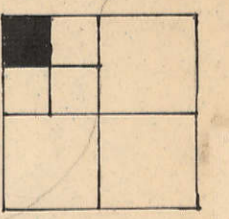

S 89° 55' E. - 731.83' NORTH LINE SEC. 8-78-4

SURVEY #2001-37358
8-23-2001

SURVEY #42213-2005
12-16-2005

TRACT "A"
15.43 AC

Schaefer Living Trust
2-15-2006
4757-06

VET. Schaefer Family
Partnership L.P.
#2001-40151
11-10-2001

5-12-2000 13027-00 JO801-01
27.71 AC

N. 00° 06' E. - 534.50'

WEST LINE
N. 00° 06' E. - 987.70'

N. 44° 59' W. - 1049.65'

TRACT "B"
SURVEY #2001-37358
8-23-2001

SECTION LINE

N. 00° 01' E. - 681.63'


ELMORE AVE.

A=176.78'
R=1560'

U3.41'
N. 00° 01' E.

N. 00° 01' E. - 624.69'

17

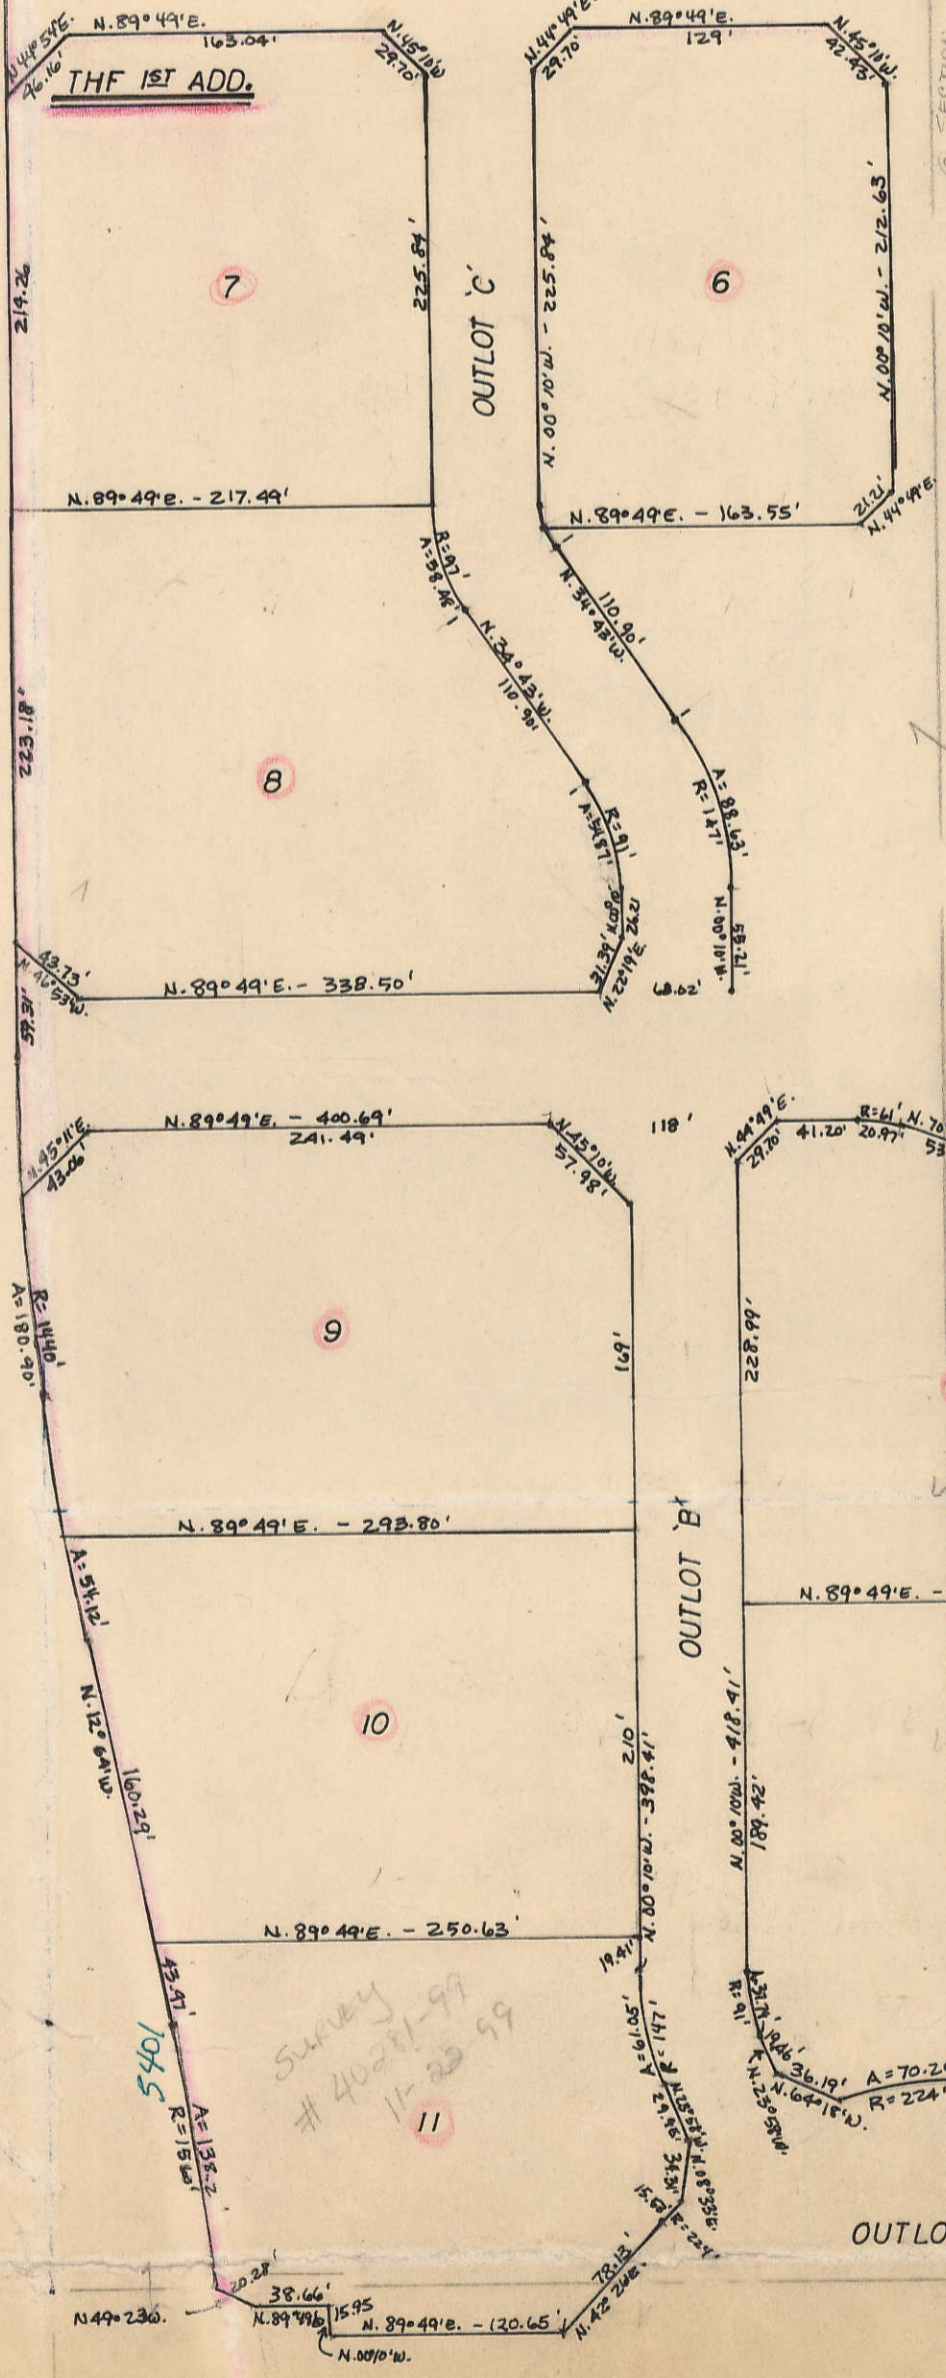

TRANSFER PAGE 15A-2577

BLANKS TO
THF
DAVENPORT
NORTH DEV.
7-18-01
#23437-01
7-17-02
#27410-02

Y0803-10

3

VOL. X SEC. 8