


PLAT OF KREITER ADDITION


Being part of the SE  $\frac{1}{4}$  SEC. 31 and the W.  $\frac{1}{2}$  of the SW  $\frac{1}{4}$  SEC. 32, T-79-N, R-4-E of the 5<sup>TH</sup> P.M.

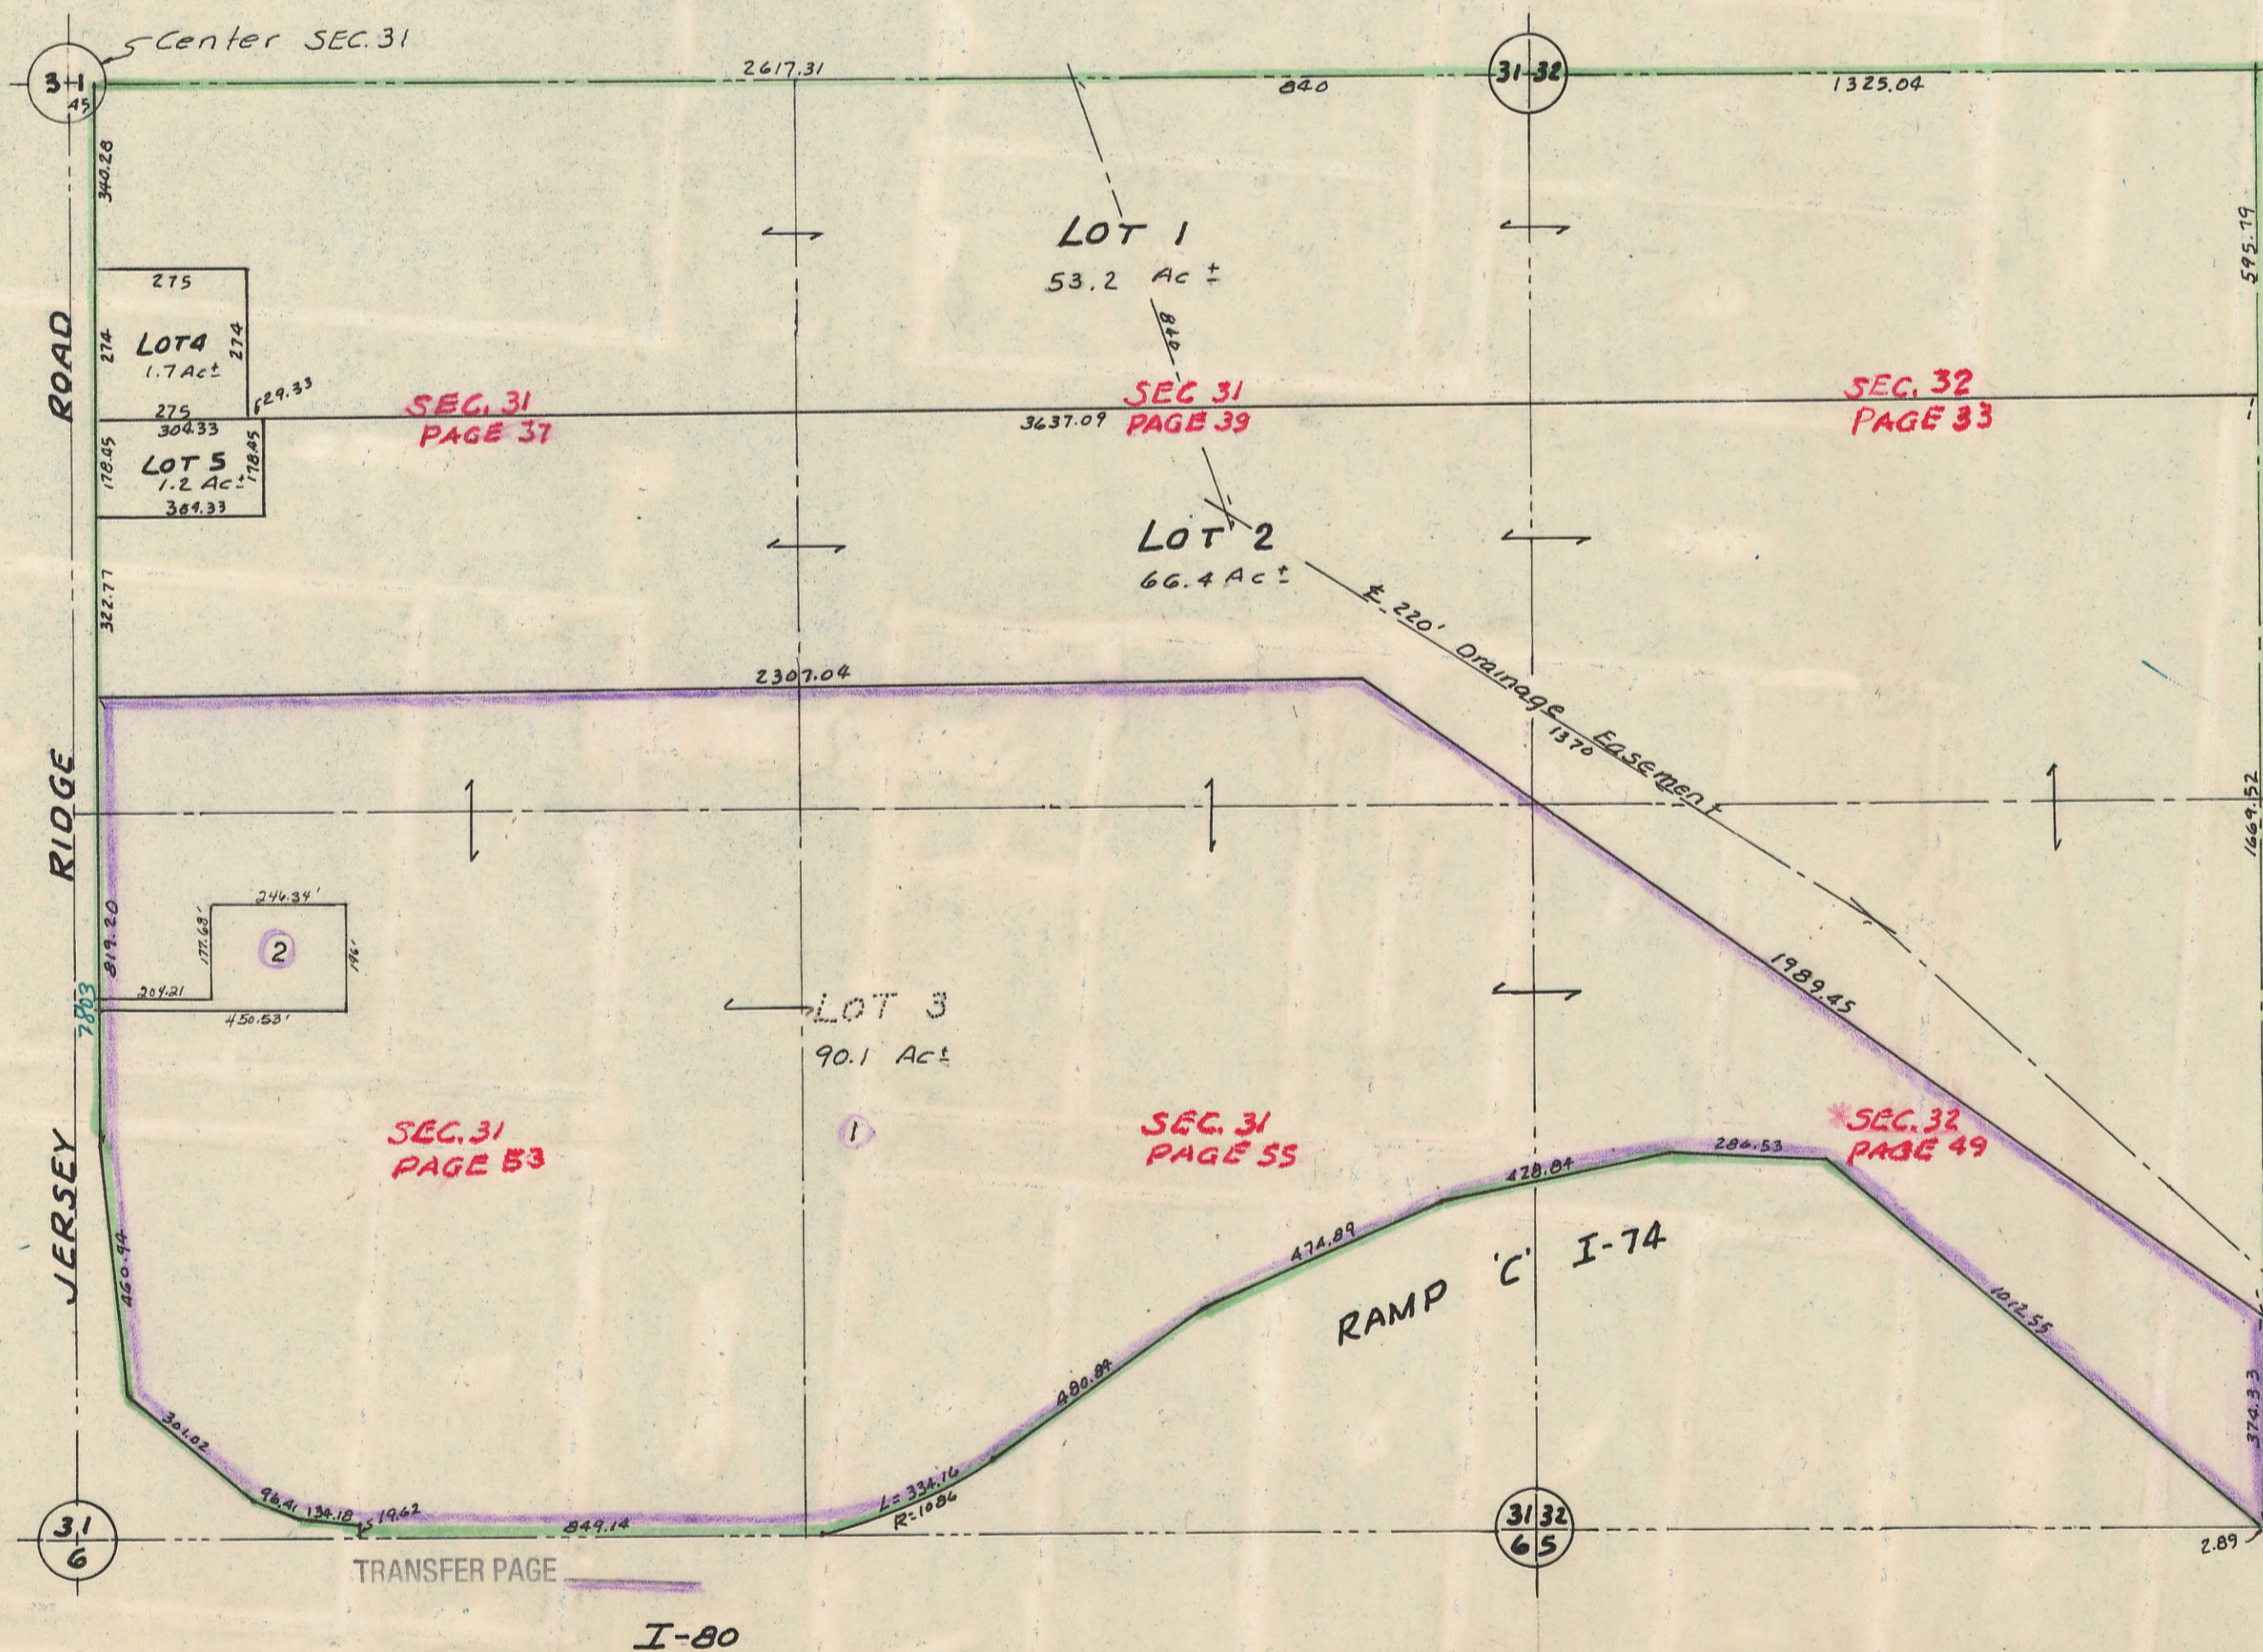

LINCOLN TOWNSHIP SW 1/4 NE 1/4 SEC. 31

CORP. LIMITS AUG. 15, 1963

1/4 SEC. LINE

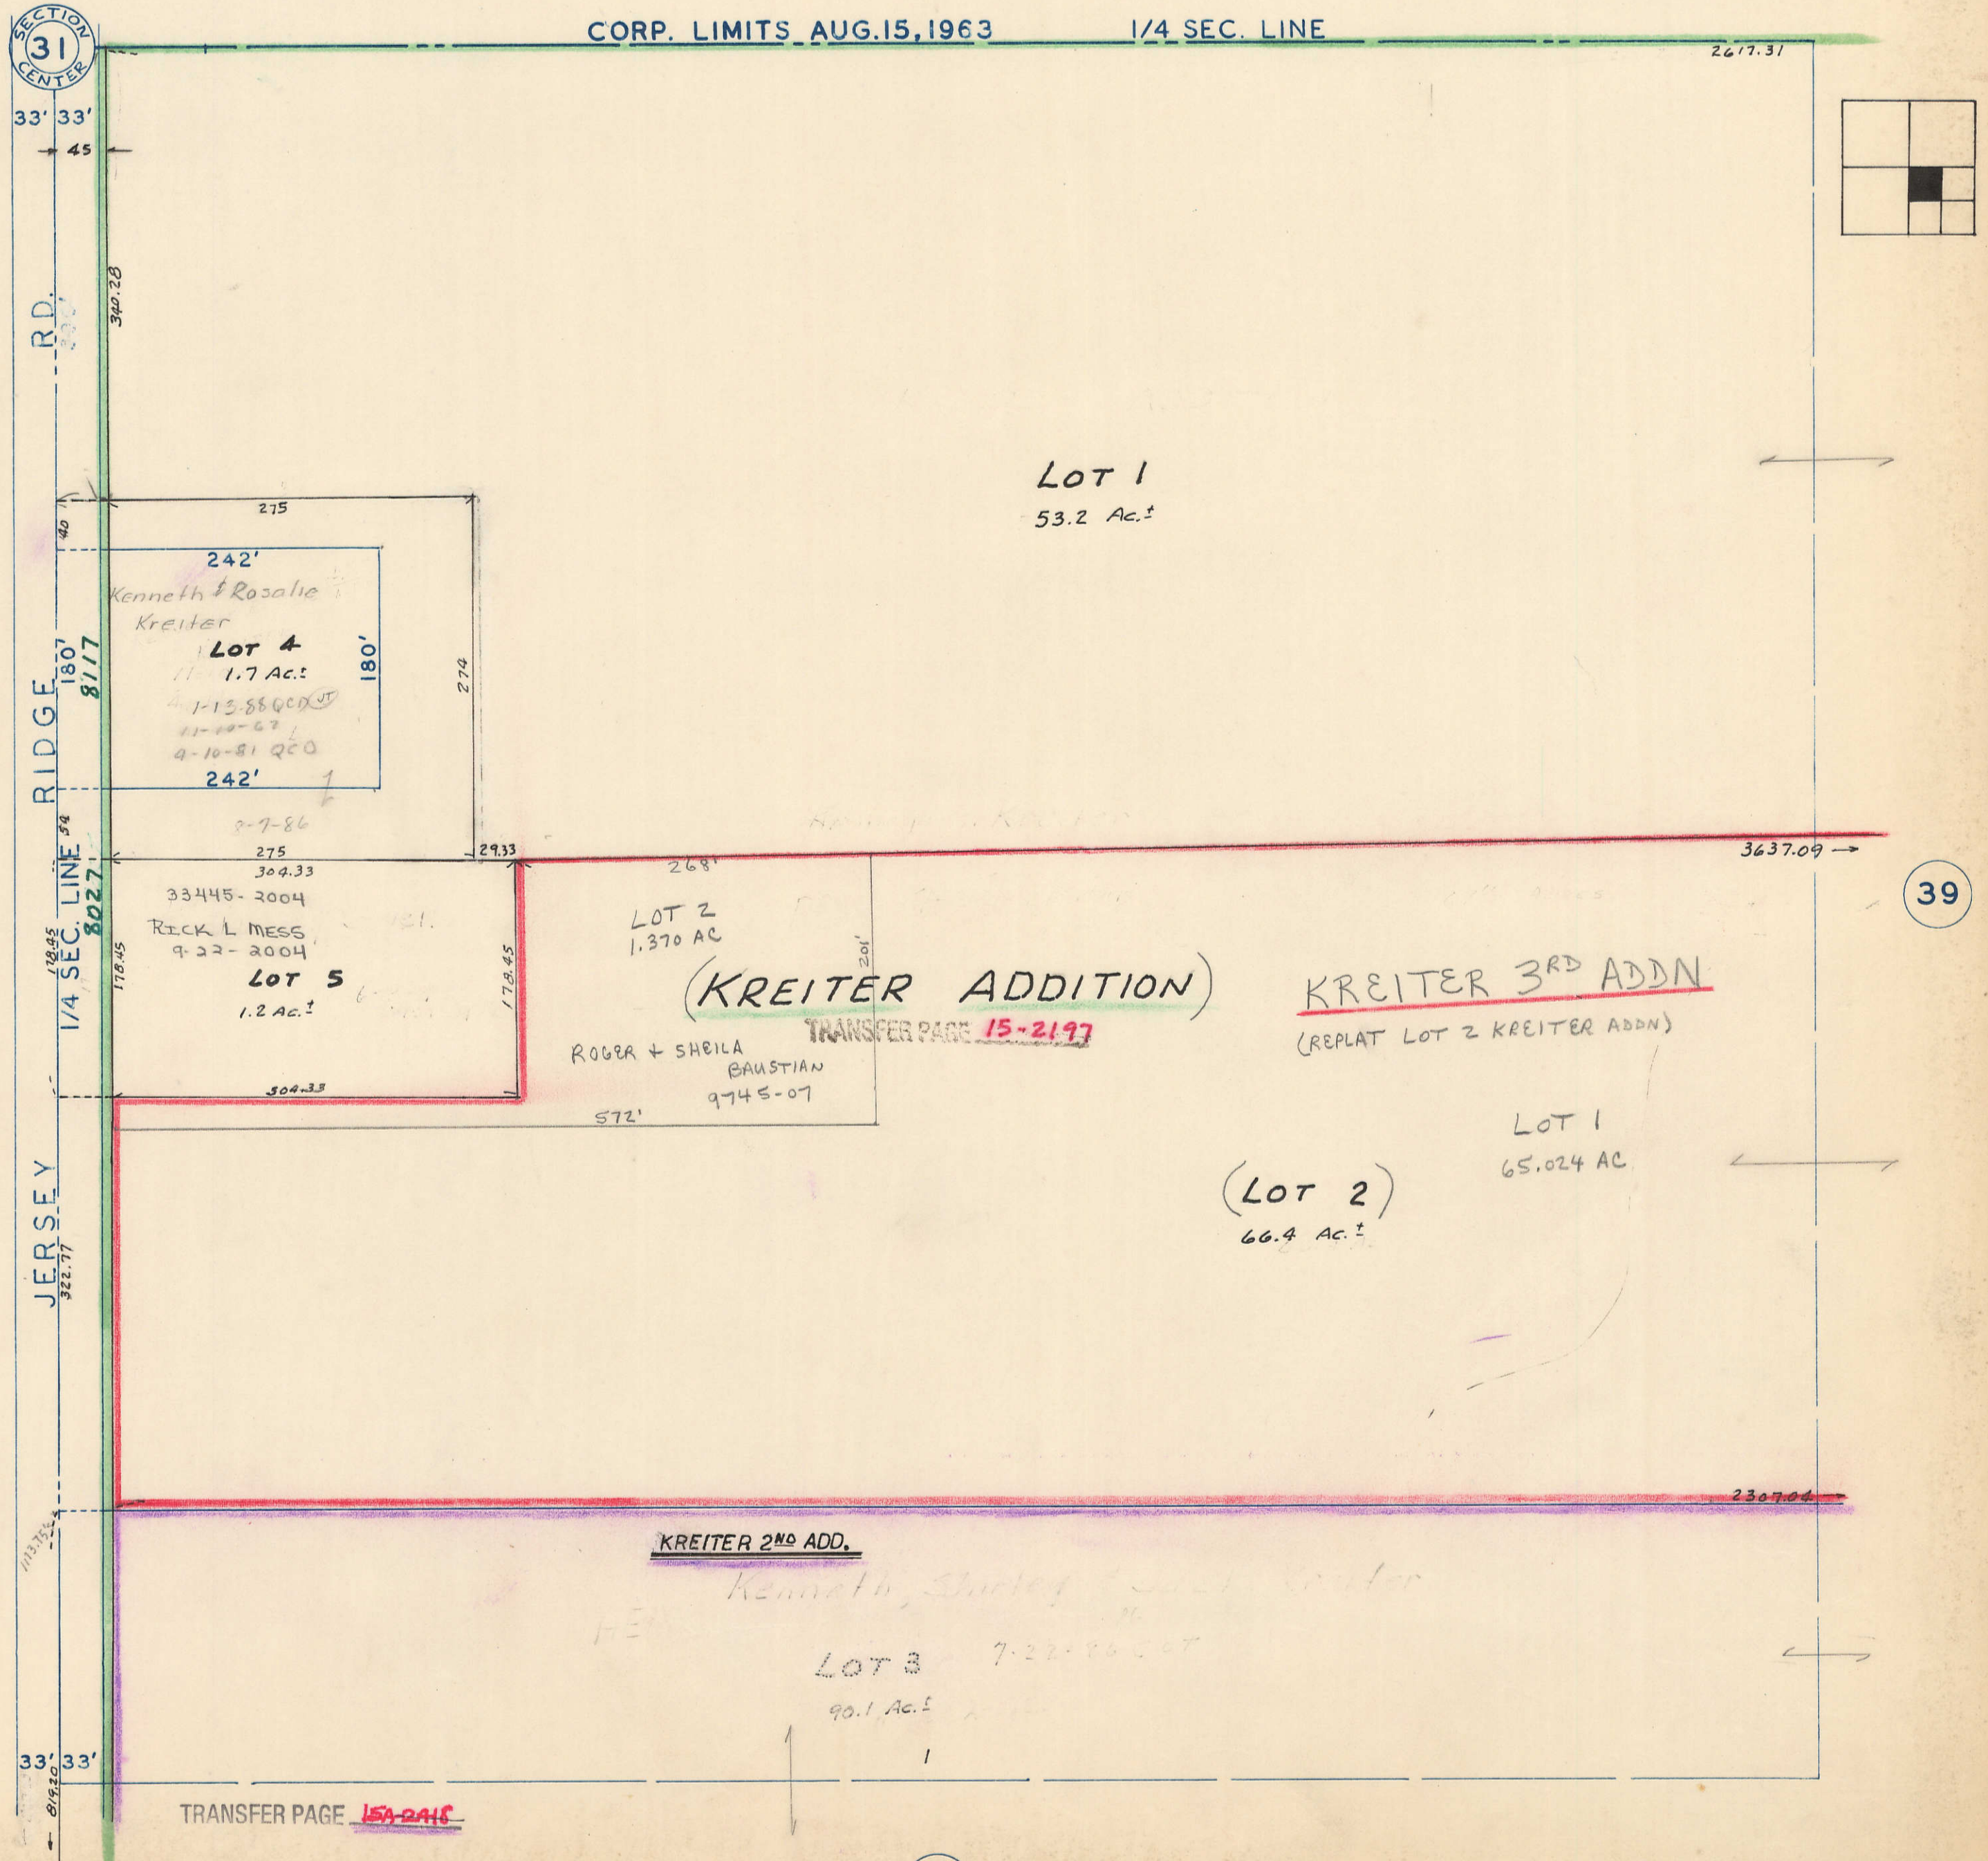

35

39

53

TRANSFER PAGE 150-2415

KREITER 2ND ADD.

(KREITER ADDITION)

KREITER 3RD ADDN

(LOT 2)

LOT 2  
1.370 AC

LOT 5  
1.2 AC.

LOT 4  
1.7 AC.

LOT 1  
53.2 AC.

LOT 1  
65.024 AC

LOT 3  
90.1 AC.

Kenneth, Shirley & Jack Kreiter

Kenneth & Rosalie Kreiter

RICK L MESS  
9-22-2004

ROGER & SHEILA BAUSTIAN  
9-7-85-07

4-1-86 QCO  
11-10-87 L  
4-10-81 QCO

TRANSFER PAGE 15-2197

(REPLAT LOT 2 KREITER ADDN)

SECTION CENTER  
31

RIDGE RD.  
JERSEY

33' 33'

45

340.28

180

8117

180

178.45

178.45

