



TRANSFER PAGE 15A-2437

TRANSFER PAGE 15A-2332

SECTION 6

E. 67TH STREET

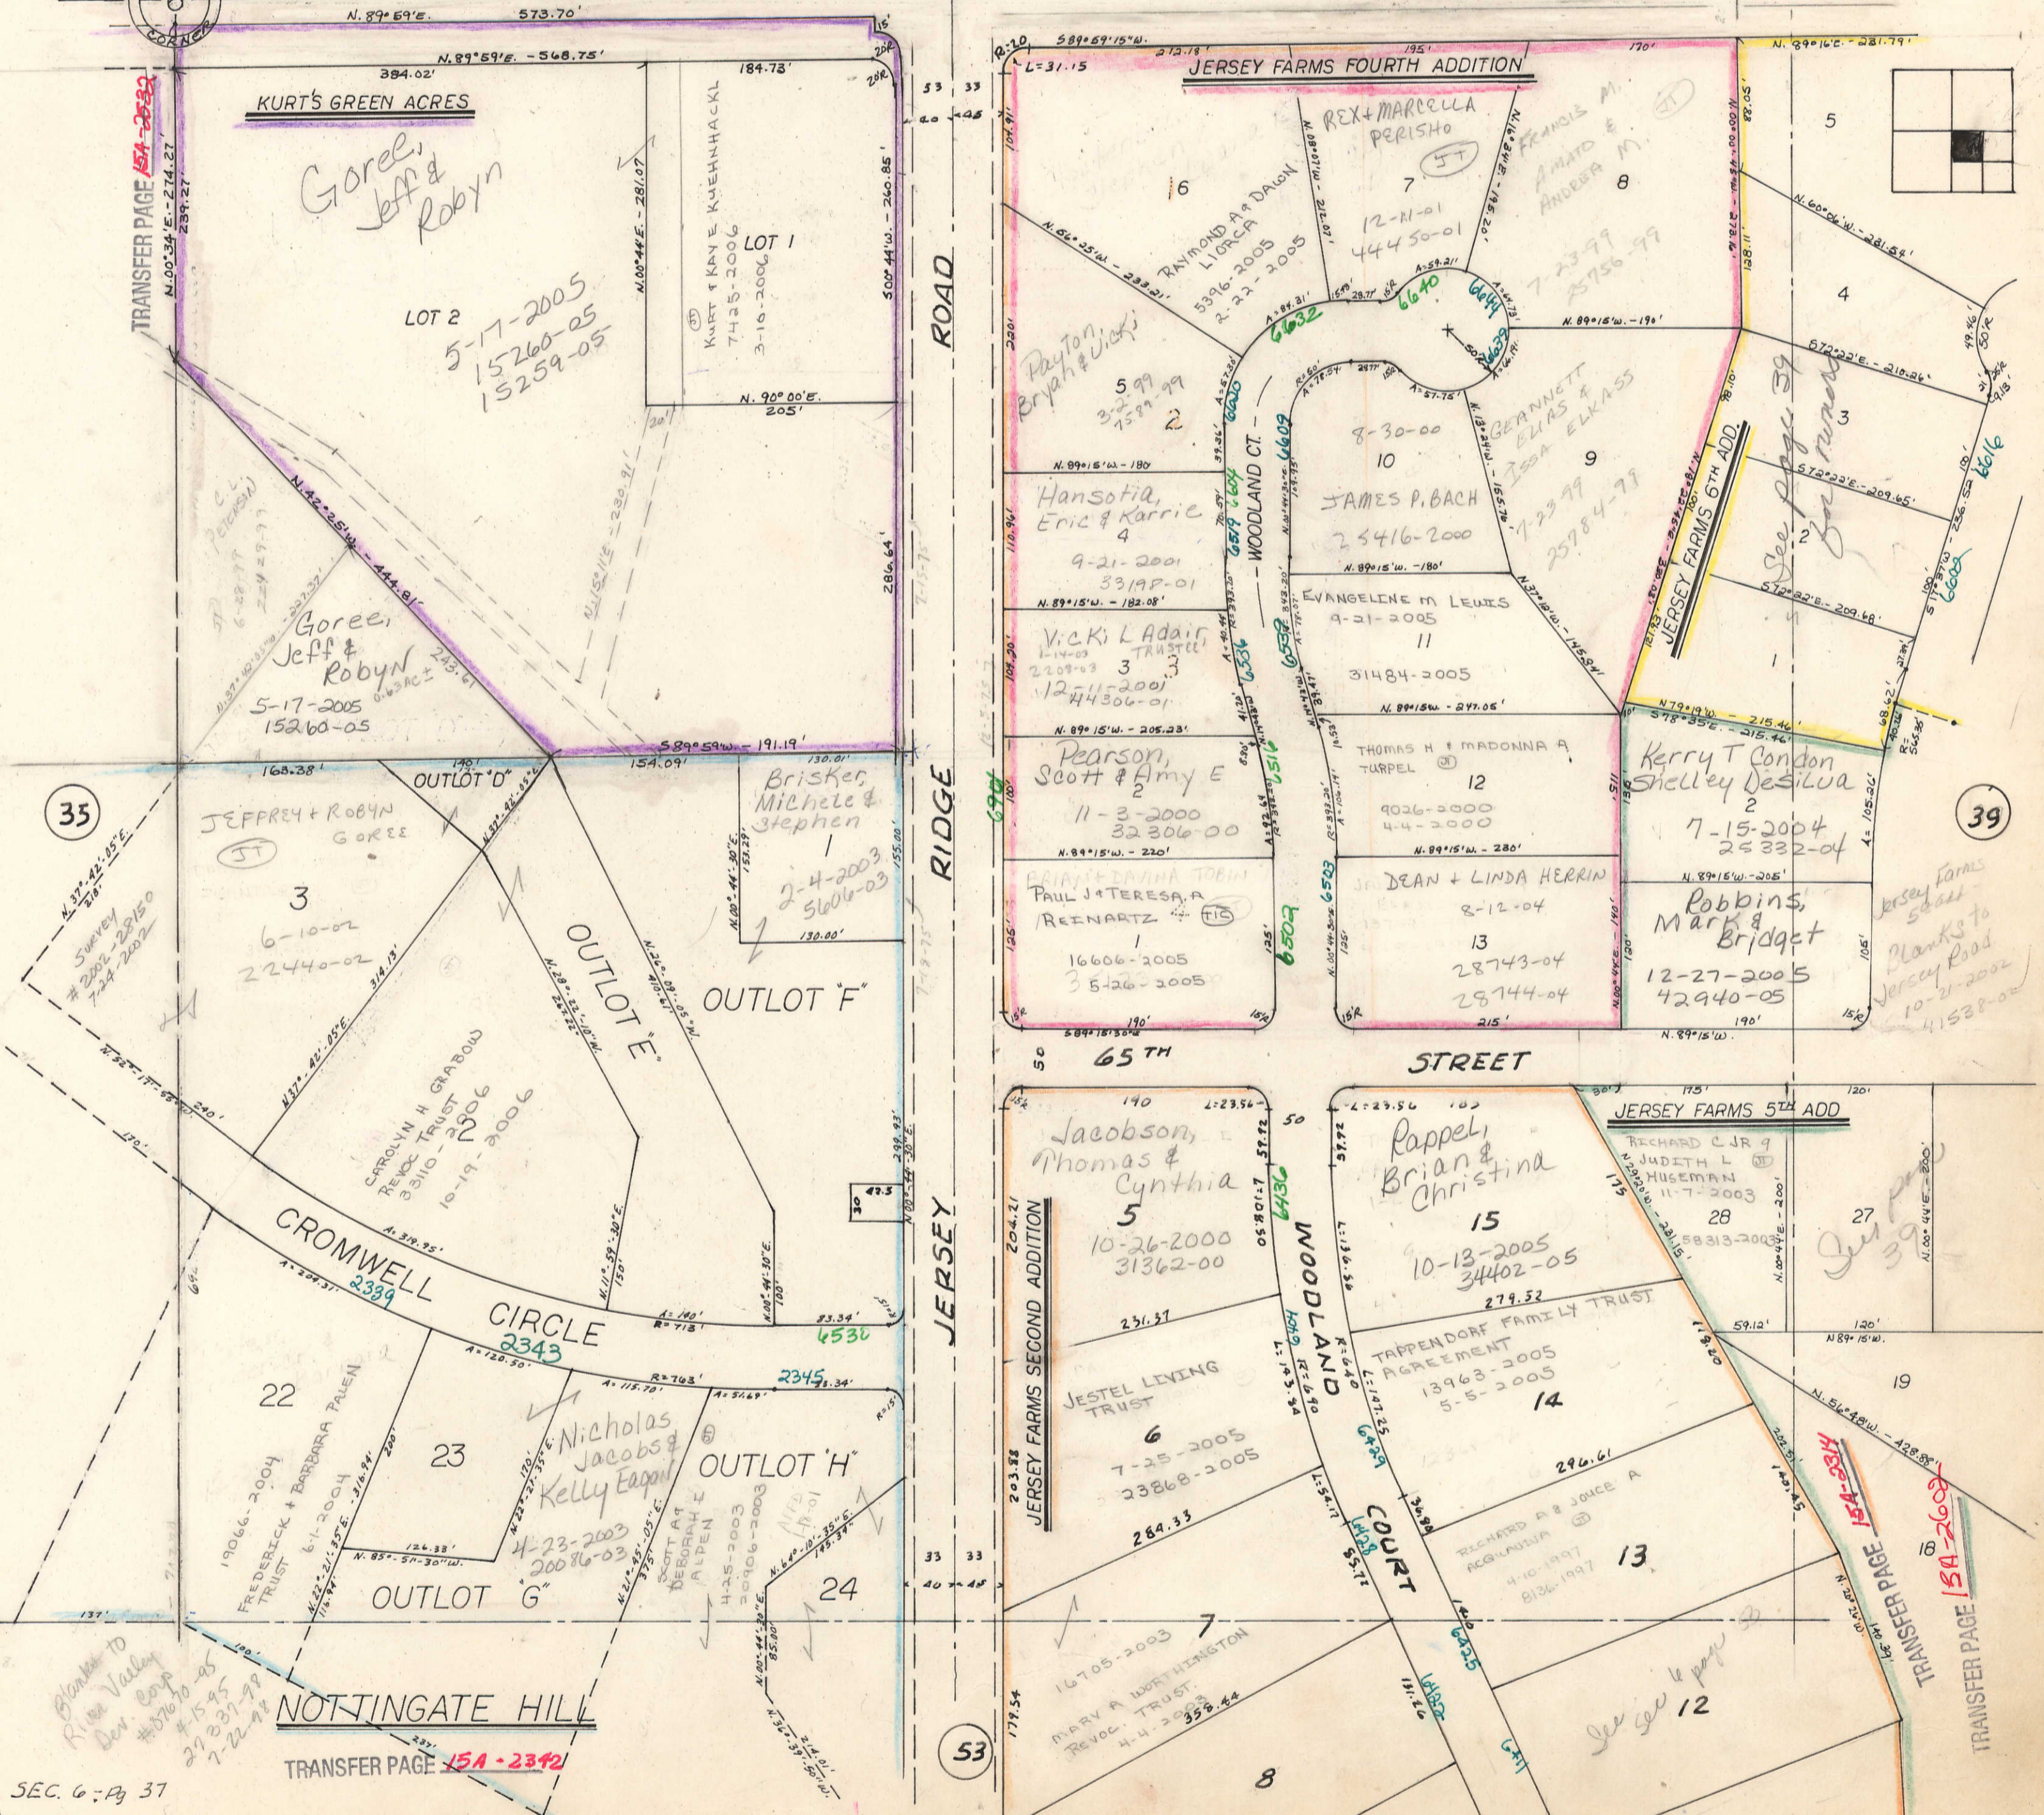

35

39

53

TRANSFER PAGE 15A-2342



Blanks to River Valley Dev Corp #07670-05 #1595 27 231-99 7-22-98

See page 39 for road

Jersey Farms 5th add Blanks to Jersey Road 10-21-2002 41538-02

See page 12