



33

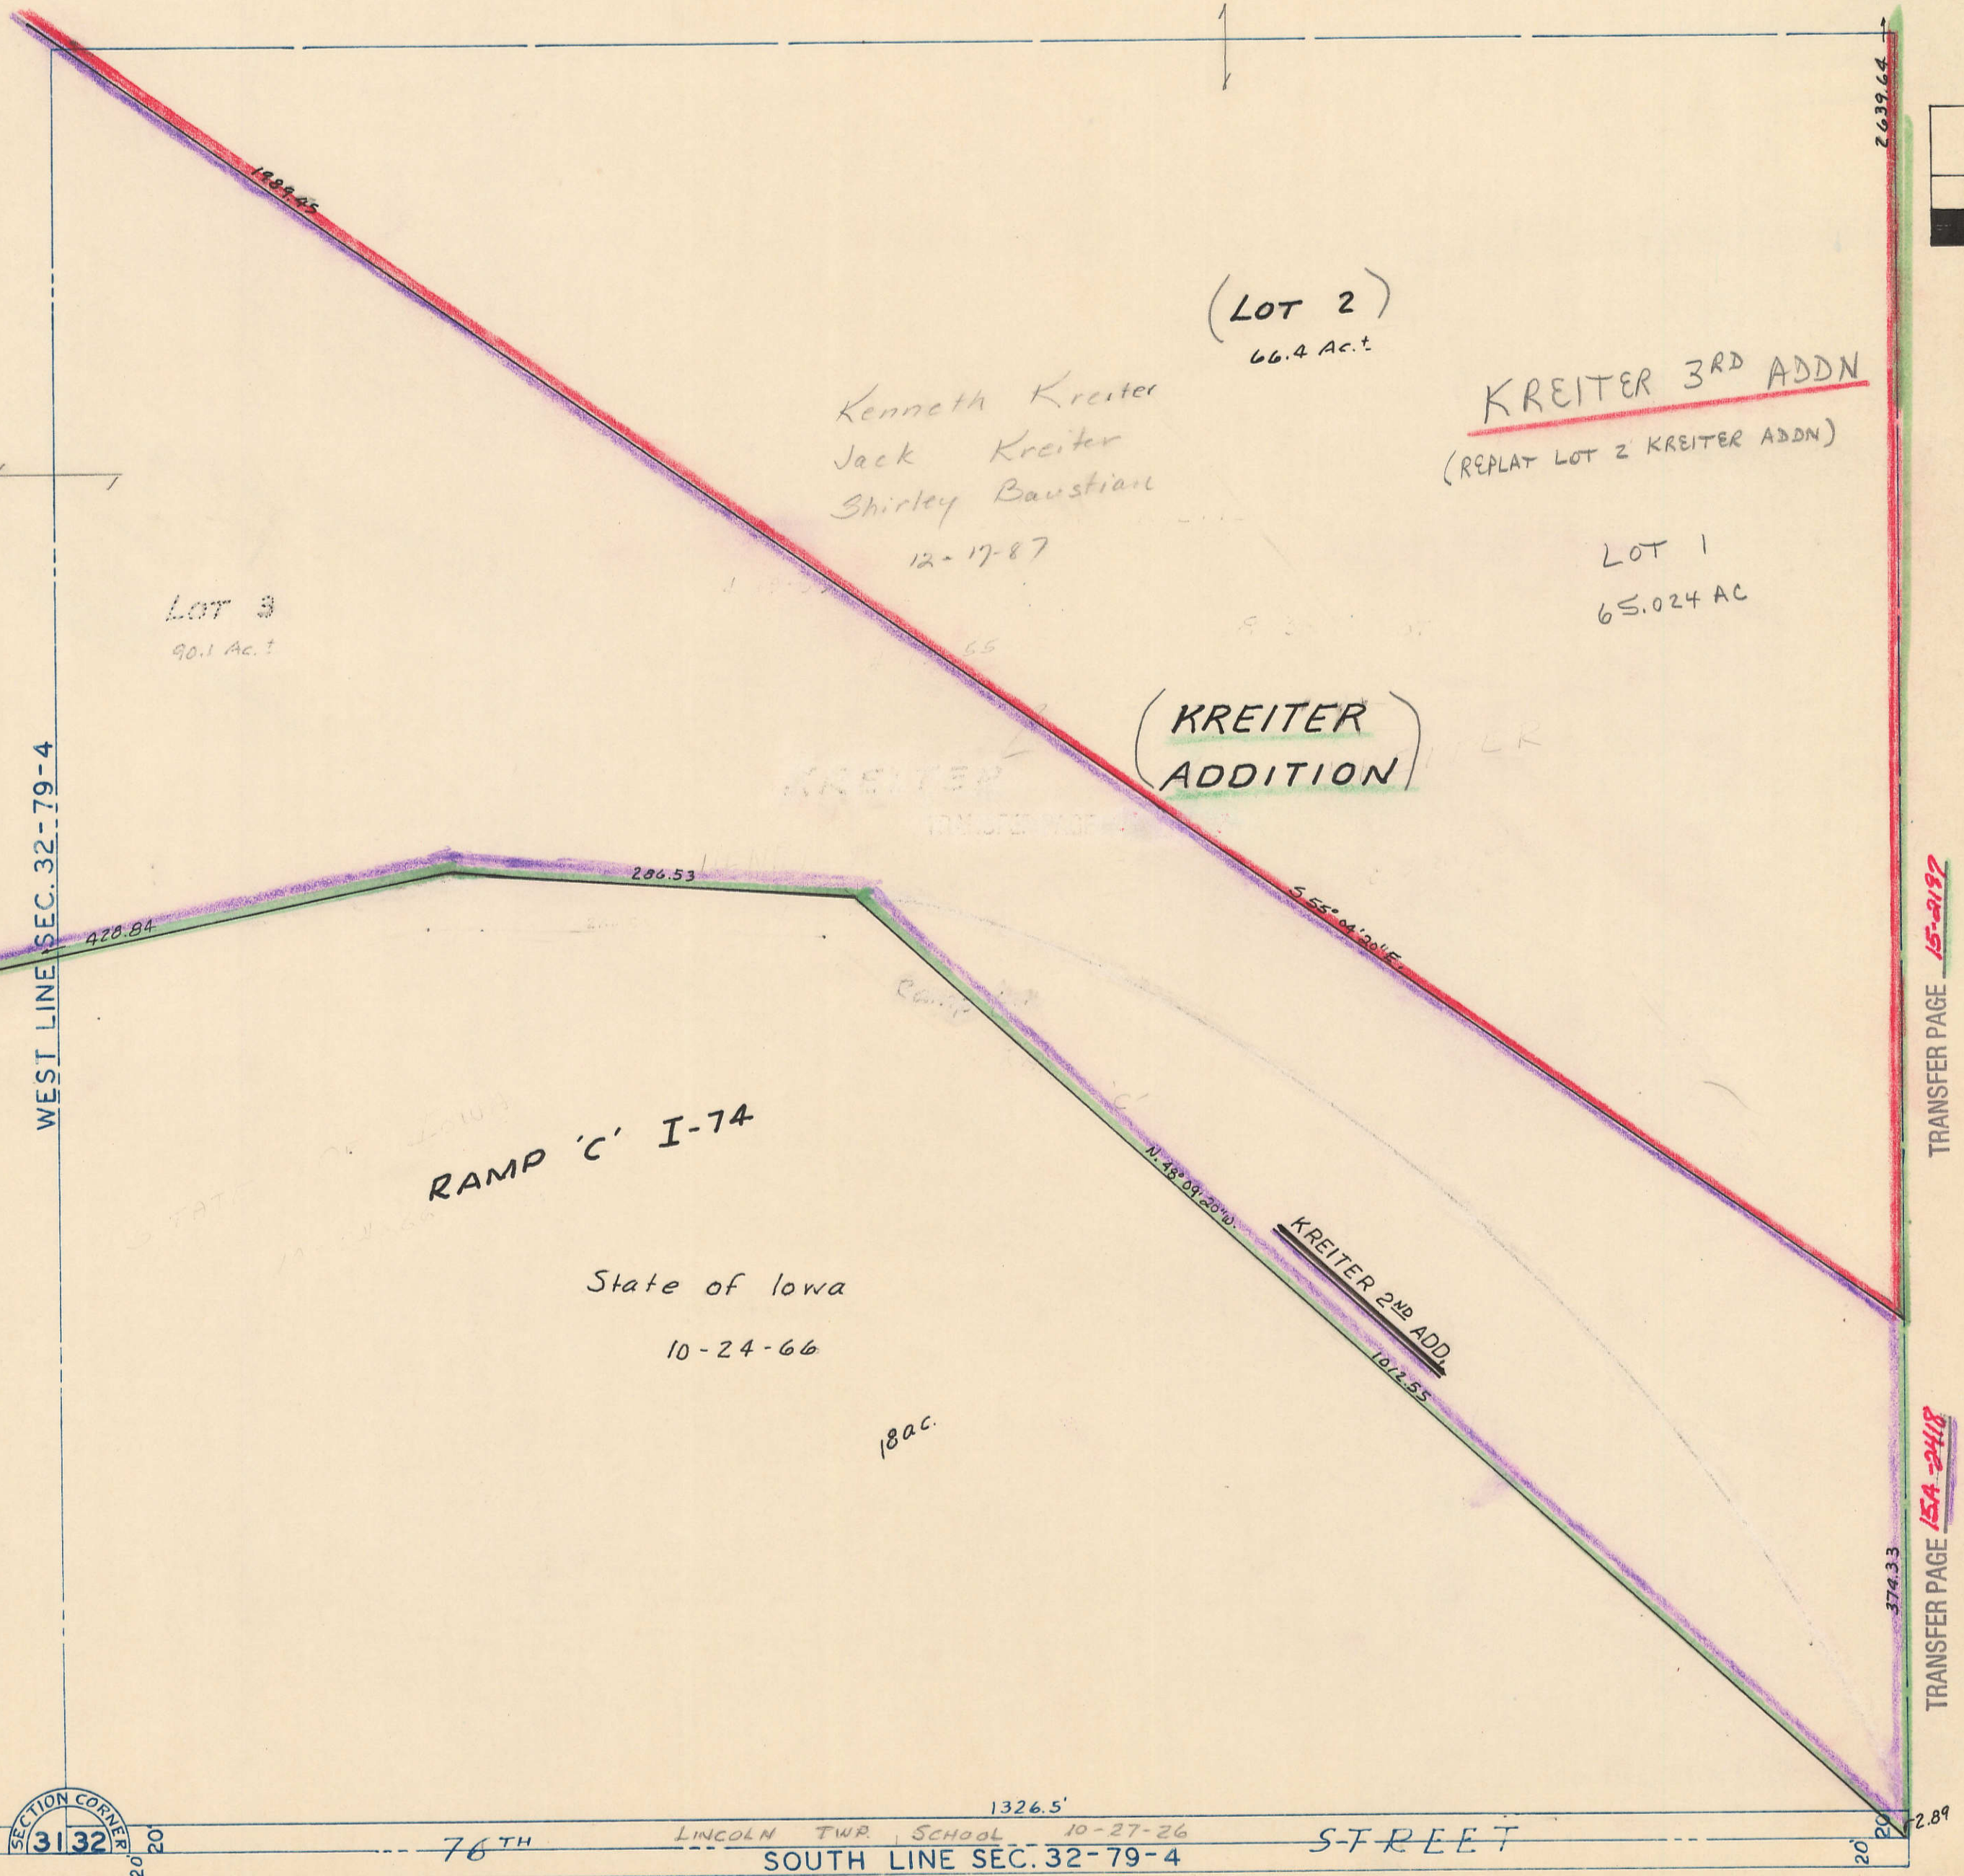

Y-31

55

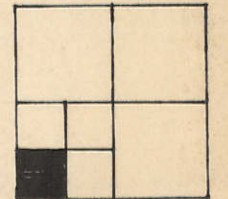

TRANSFER PAGE 15-2197

51

TRANSFER PAGE 15A-2418

1

Y-5

3