


O.L. A
10' Prairie Farms Homeowners Assoc.
#26861-2006
8-25-2006

33

JERSEY ROADS
6-27-03
33112-03

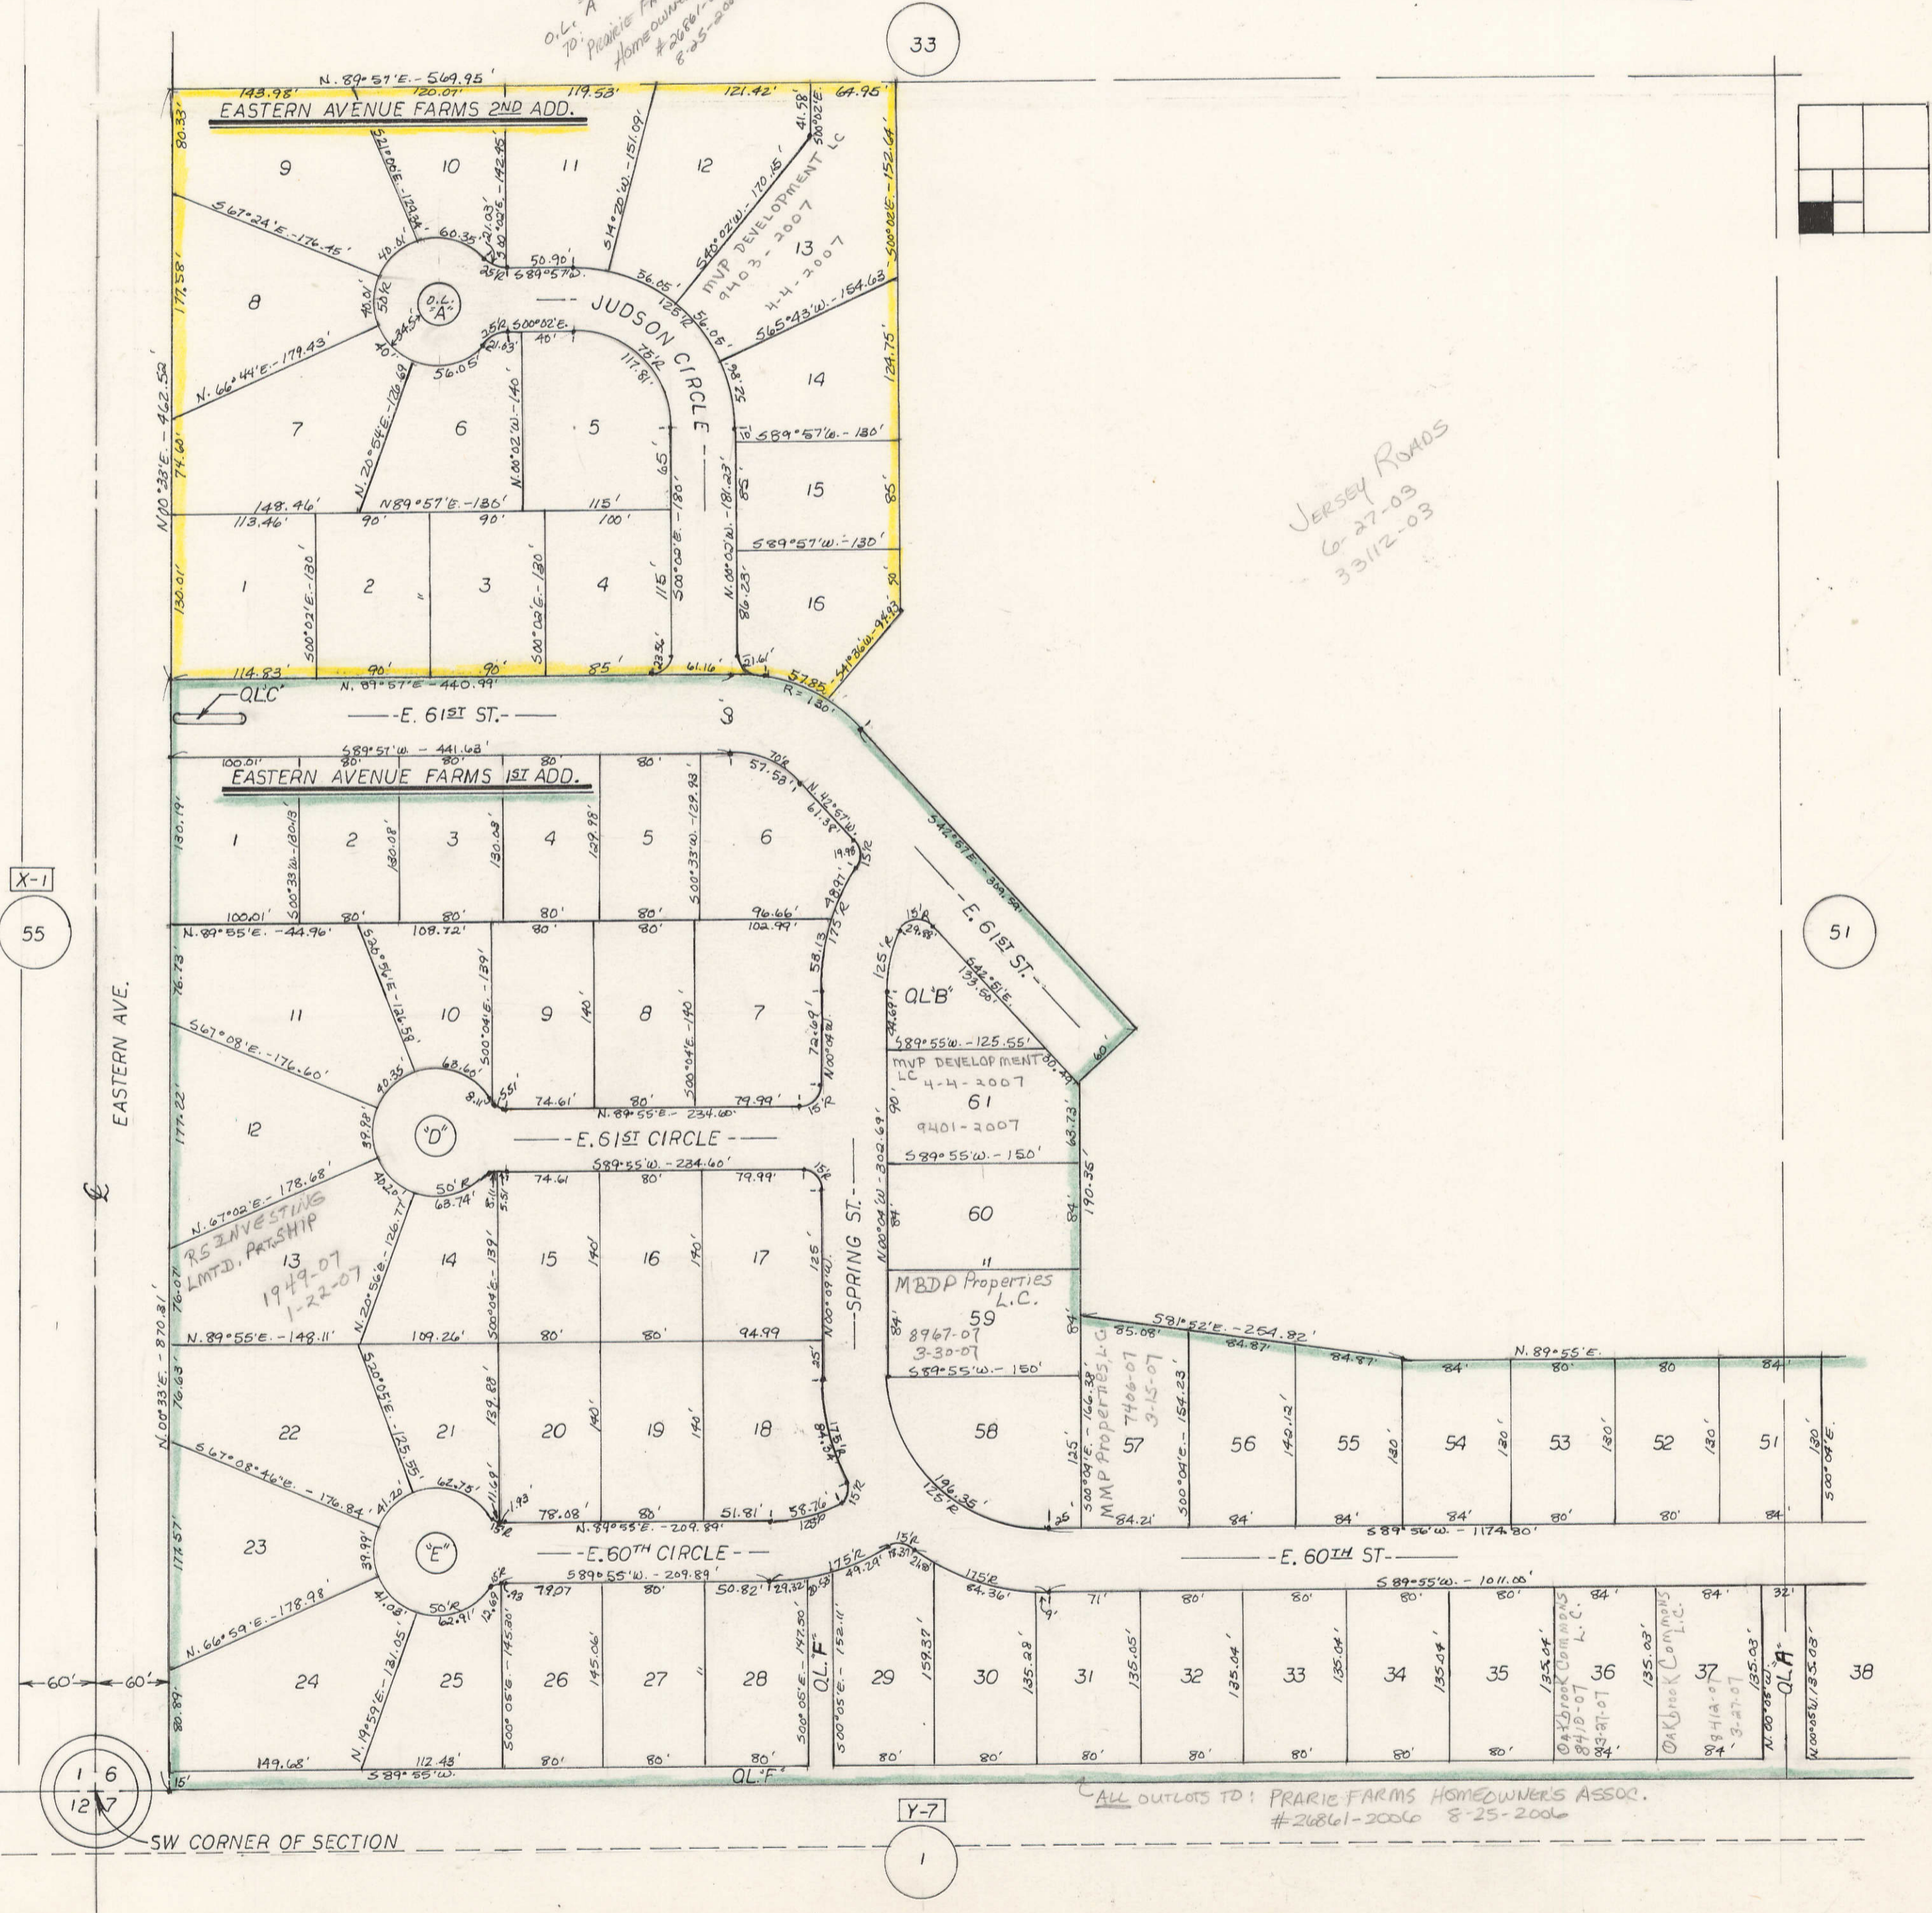

BLANKS
TO JERSEY
ROADS L.C.

X-1
55

51

16
127

Y-7

1

SW CORNER OF SECTION

ALL OUTLOTS TO: PRAIRIE FARMS HOMEOWNERS ASSOC.
#26861-2006 8-25-2006