


53

Y-32

55

TRANSFER PAGE 61d-206

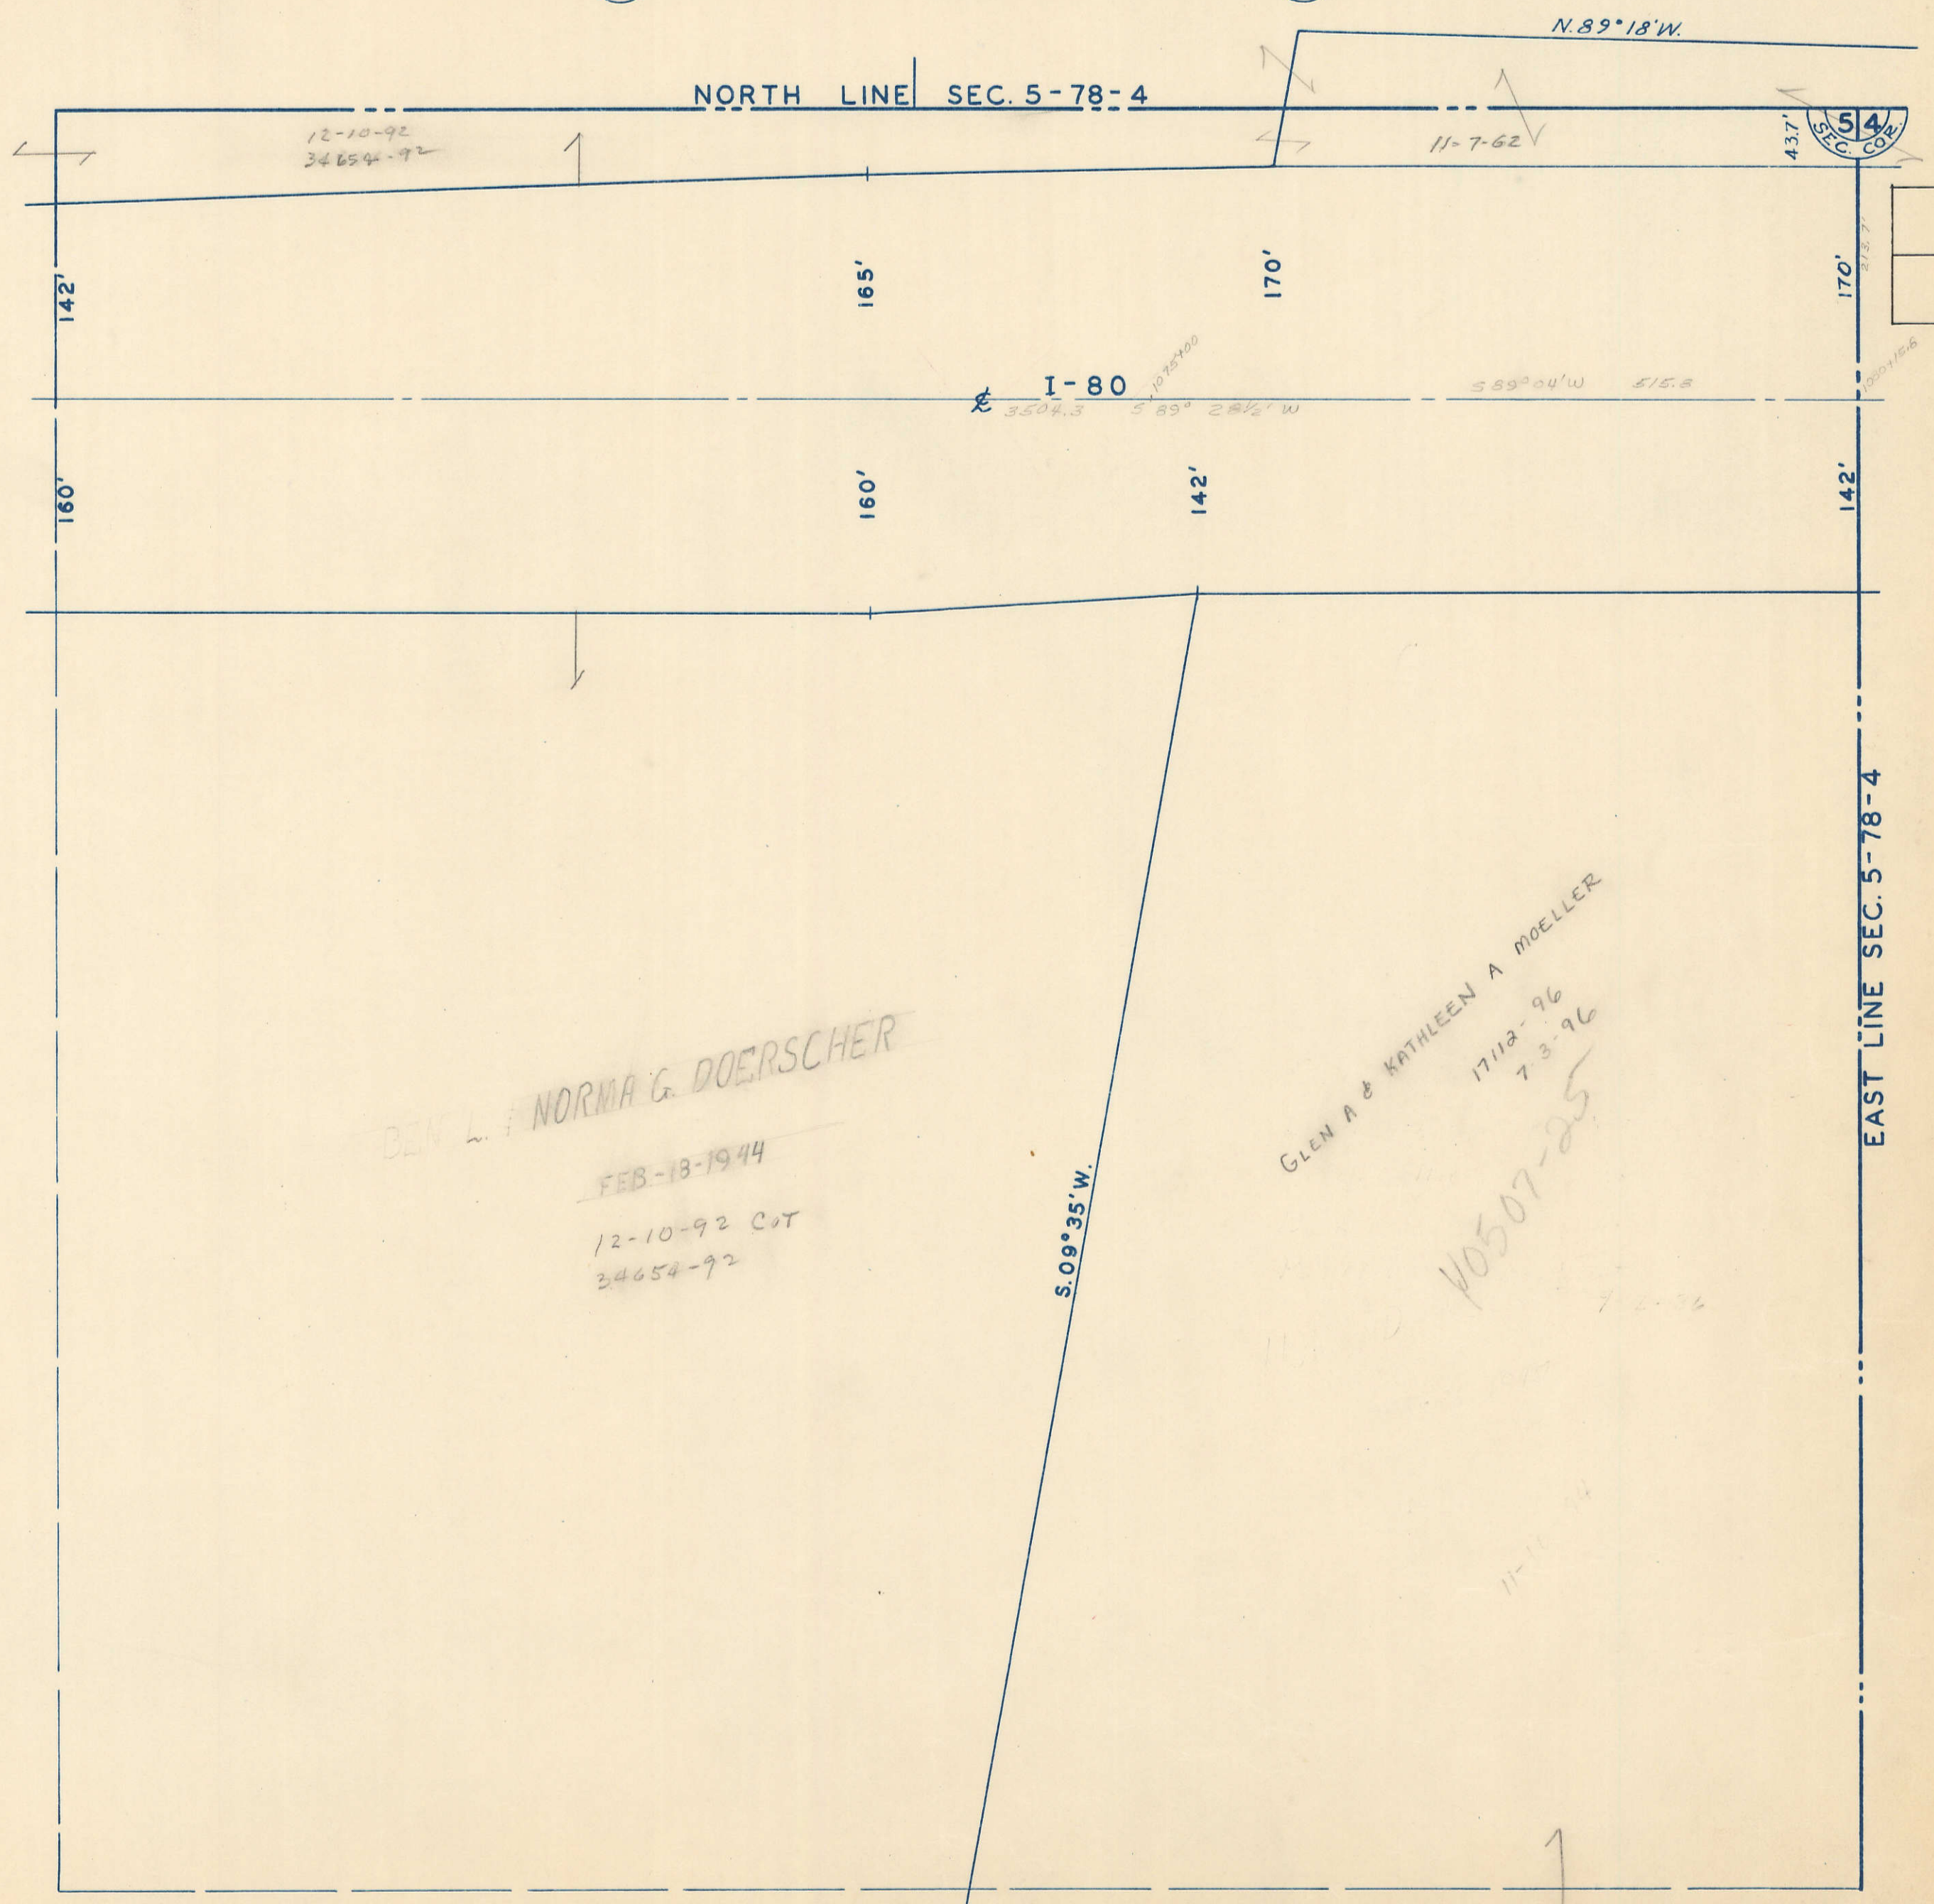

5

Y-4

1

23