
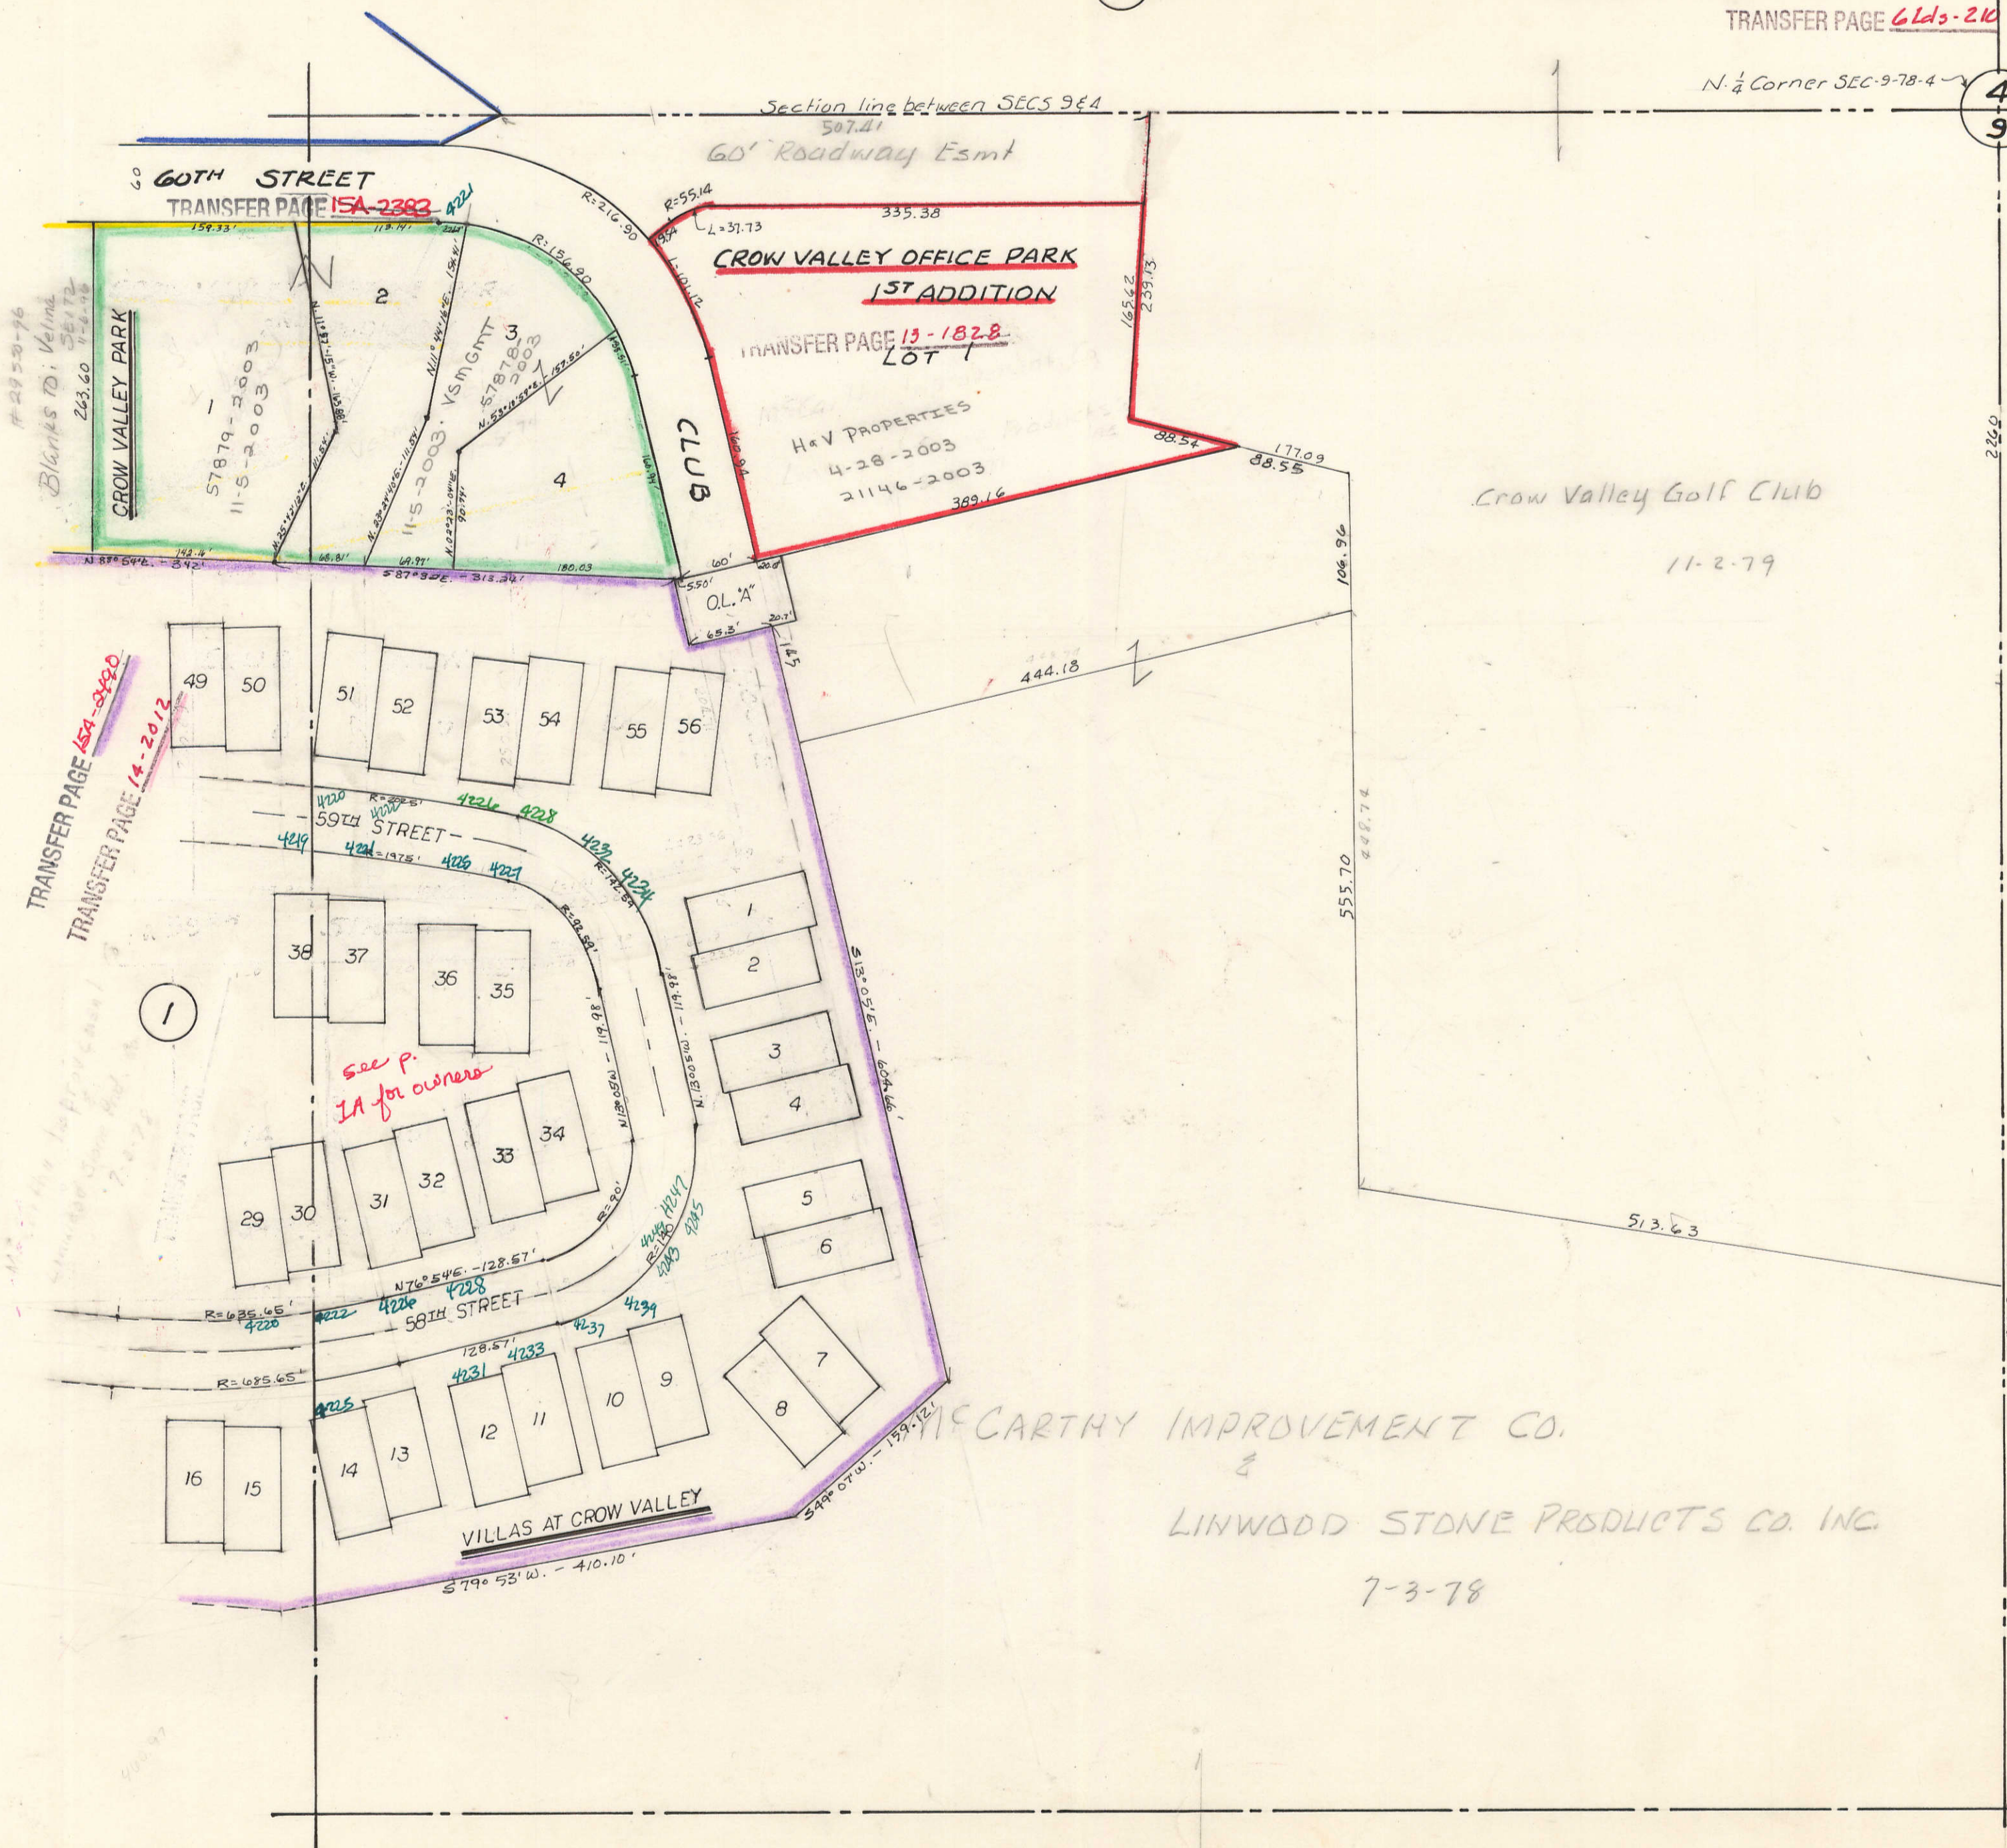


(51)

TRANSFER PAGE 6Lds-2K

N 1/4 Corner SEC-9-78-4

4
9

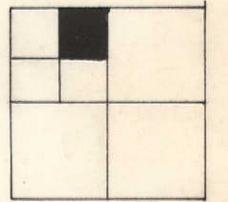

BETT.VOL.G

(5)

SEC 9

MCCARTHY IMPROVEMENT CO.
&
LINWOOD STONE PRODUCTS CO. INC.
7-3-78

(19)