


3

Transfer Page 6lds-210

TRANSFER PAGE 15A-2622

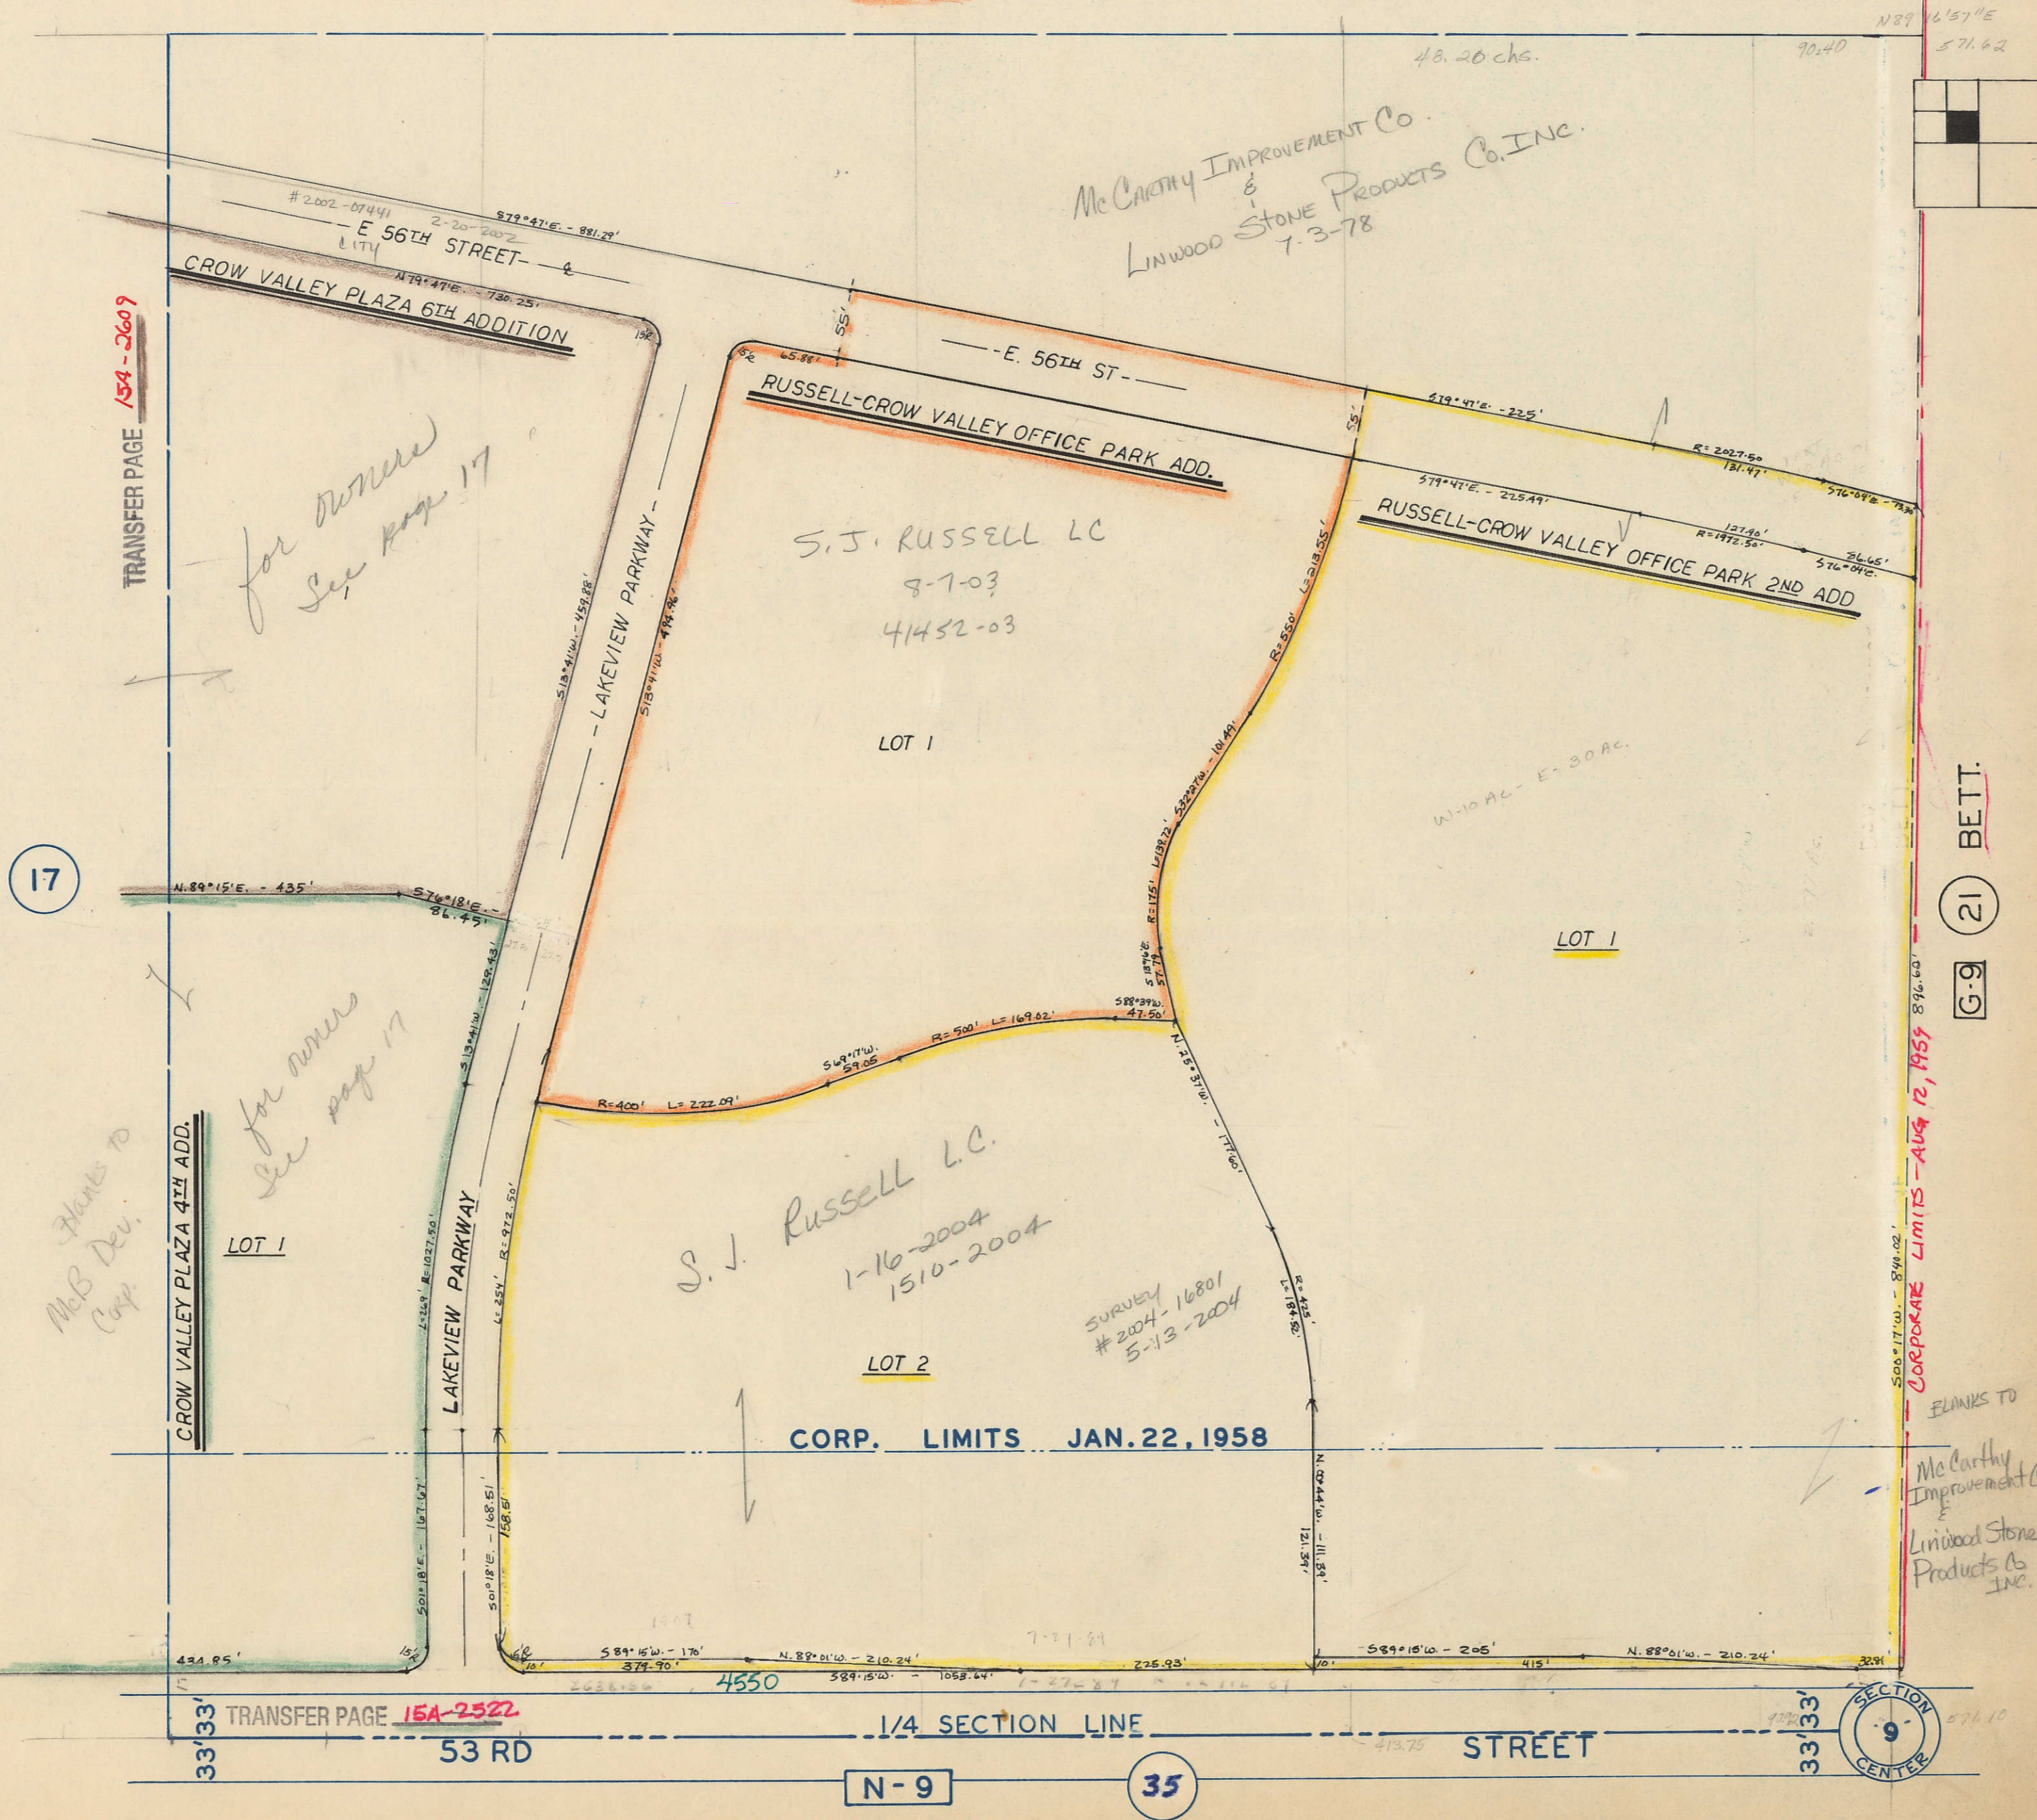

TRANSFER PAGE 15A-2522

1/4 SECTION LINE

STREET

N-9

35

SECTION CENTER
9

G-9 (21) BETT.