
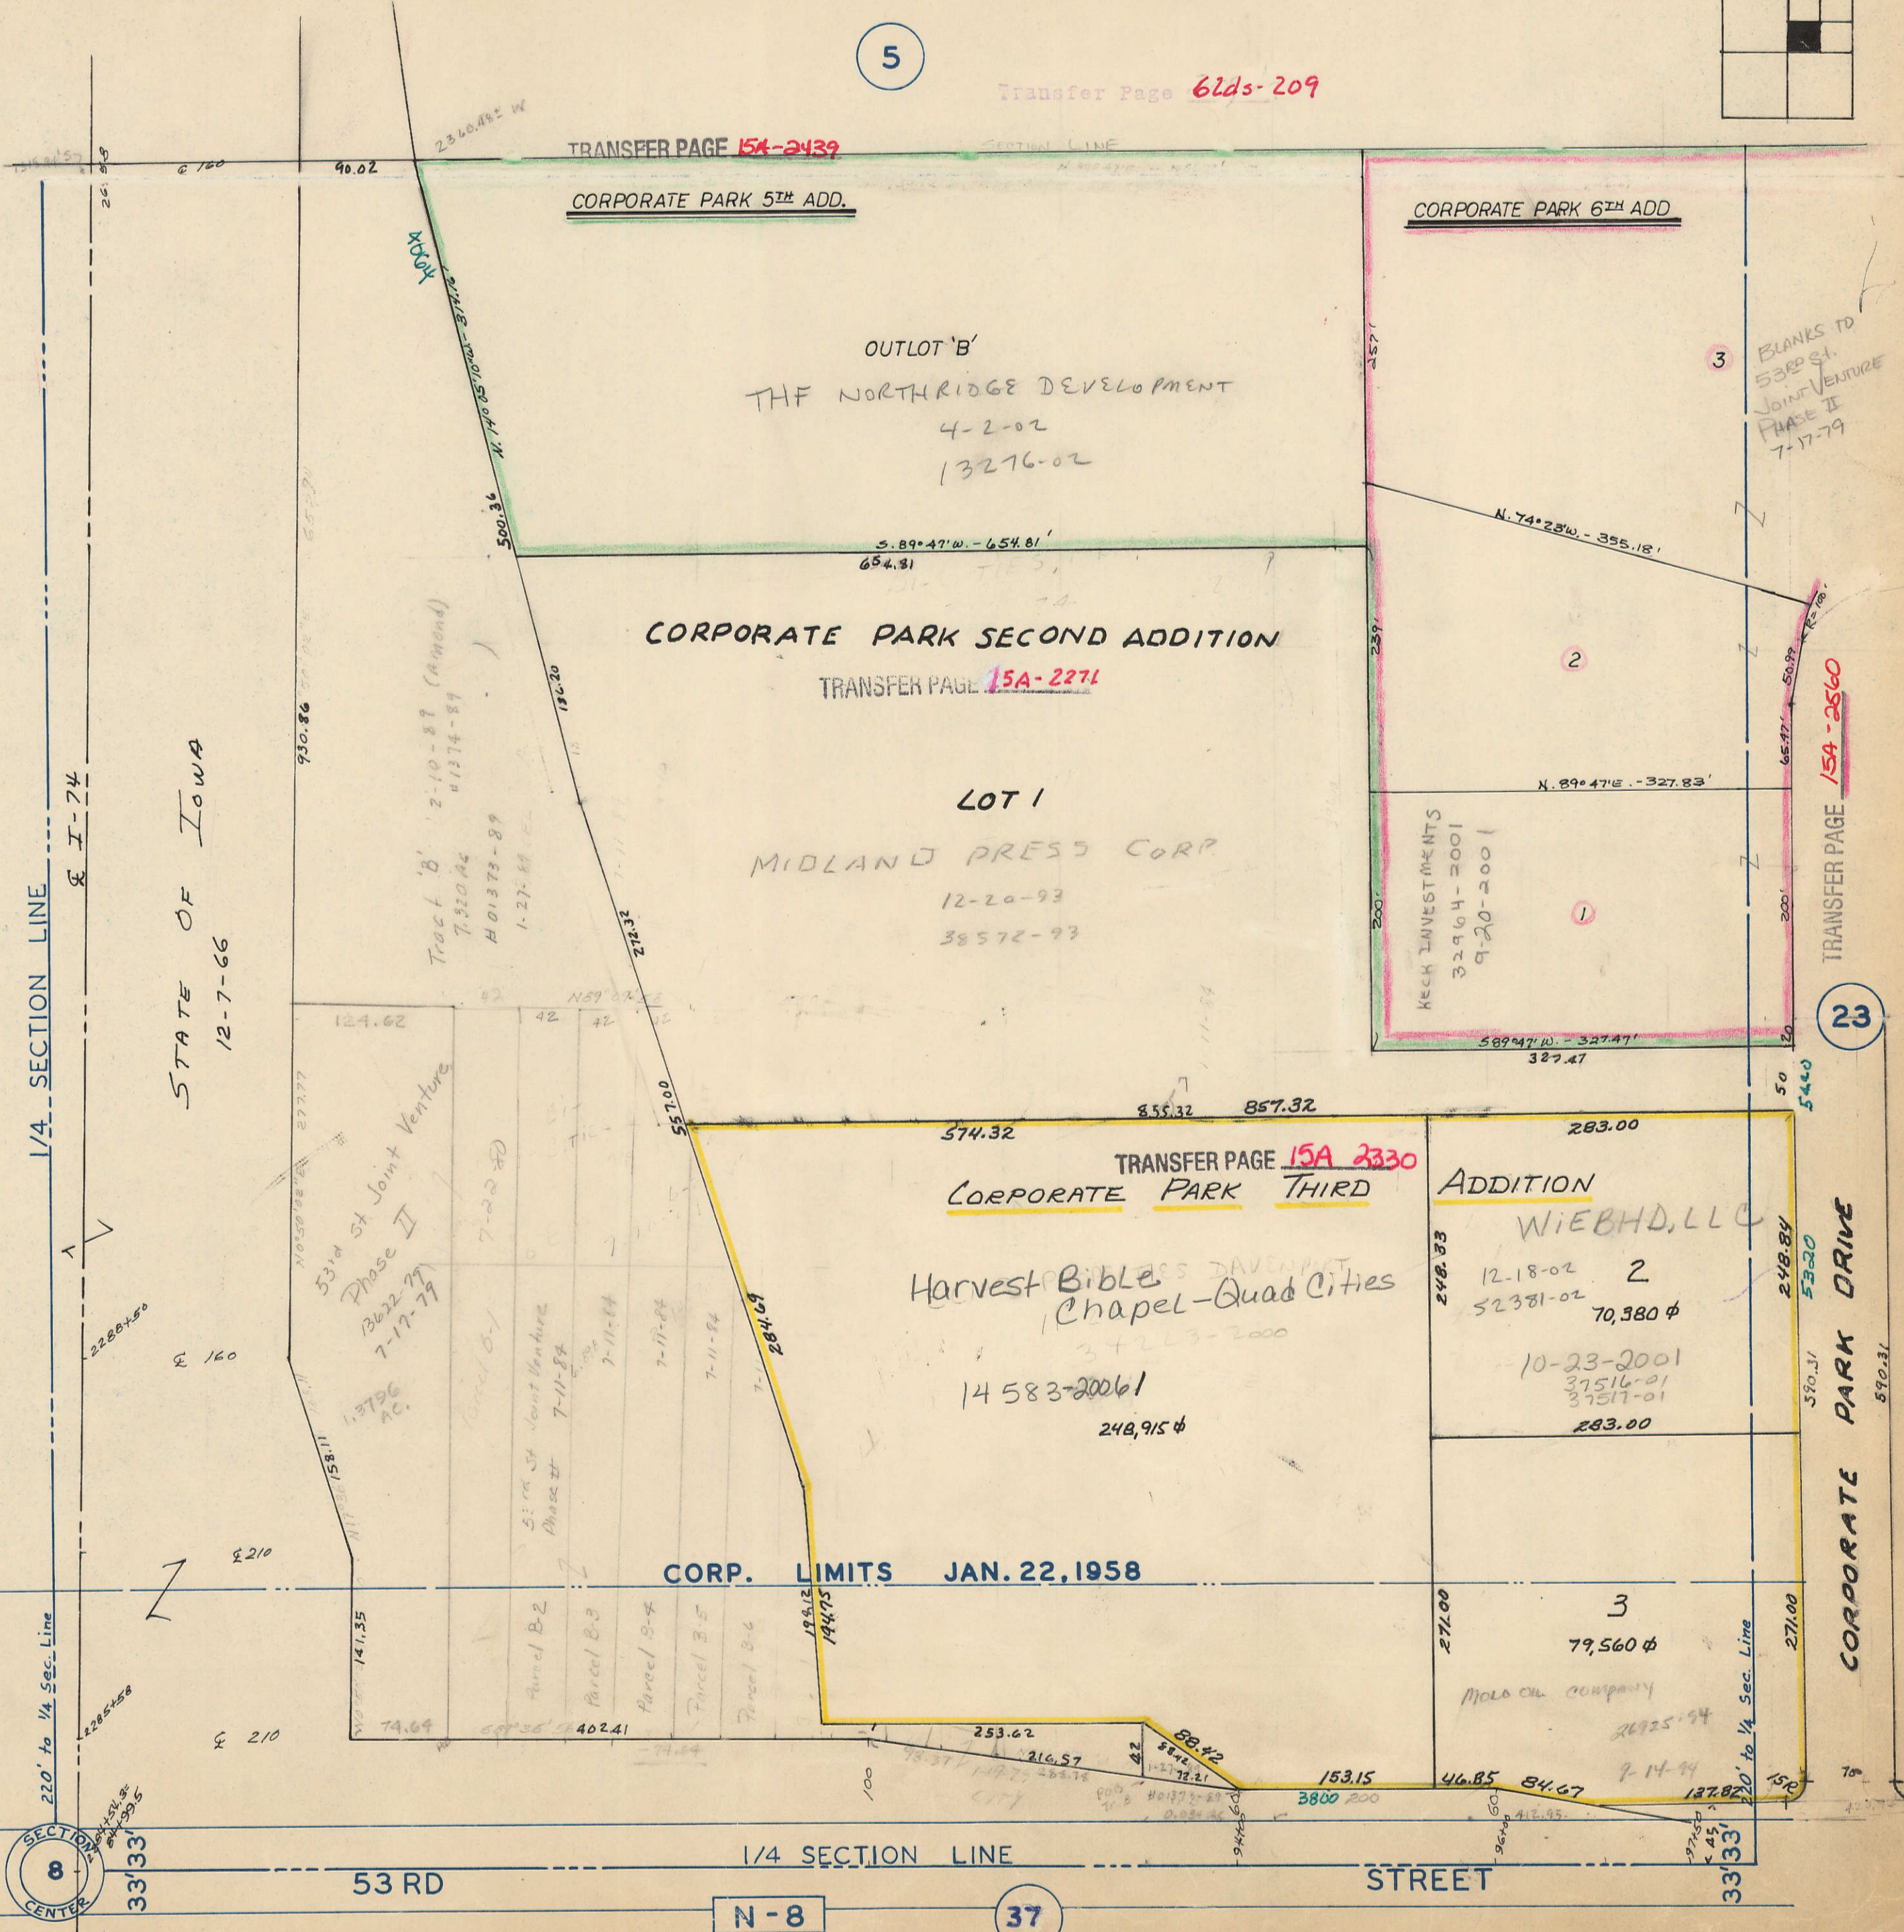


5

Transfer Page 62ds-209

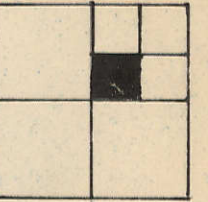

TRANSFER PAGE 15A-2439

CORPORATE PARK 5TH ADD.

CORPORATE PARK 6TH ADD.

CORPORATE PARK SECOND ADDITION

TRANSFER PAGE 15A-2271

LOT 1

MIDLAND PRESS CORP

12-20-93
38572-93

TRANSFER PAGE 15A 2330

CORPORATE PARK THIRD ADDITION

Chapel-Quad Cities

14583-20061
248,915 φ

ADDITION

WIEBHD, LLC

12-18-02 2
52381-02 70,380 φ

10-23-2001
37516-01
37517-01
283.00

CORP. LIMITS JAN. 22, 1958

1/4 SECTION LINE

53 RD

STREET

N-8

37

19

23

SECTION 8
CENTER
33'33"

SECTION 8
CENTER
33'33"

1/4 SECTION LINE

STATE OF IOWA

12-7-66

220' to 1/4 Sec. Line

33'33"

220' to 1/4 Sec. Line

33'33"