

SEC 32
53



T78N
T77N

32
5

(OLD) US. HWY. NO. 61
BURNSIDE LANE

I DOT
589°48'E.

BLANKS TO:
GRUNWALD LAND DEV. 6-1-04 19104-04

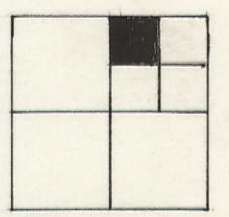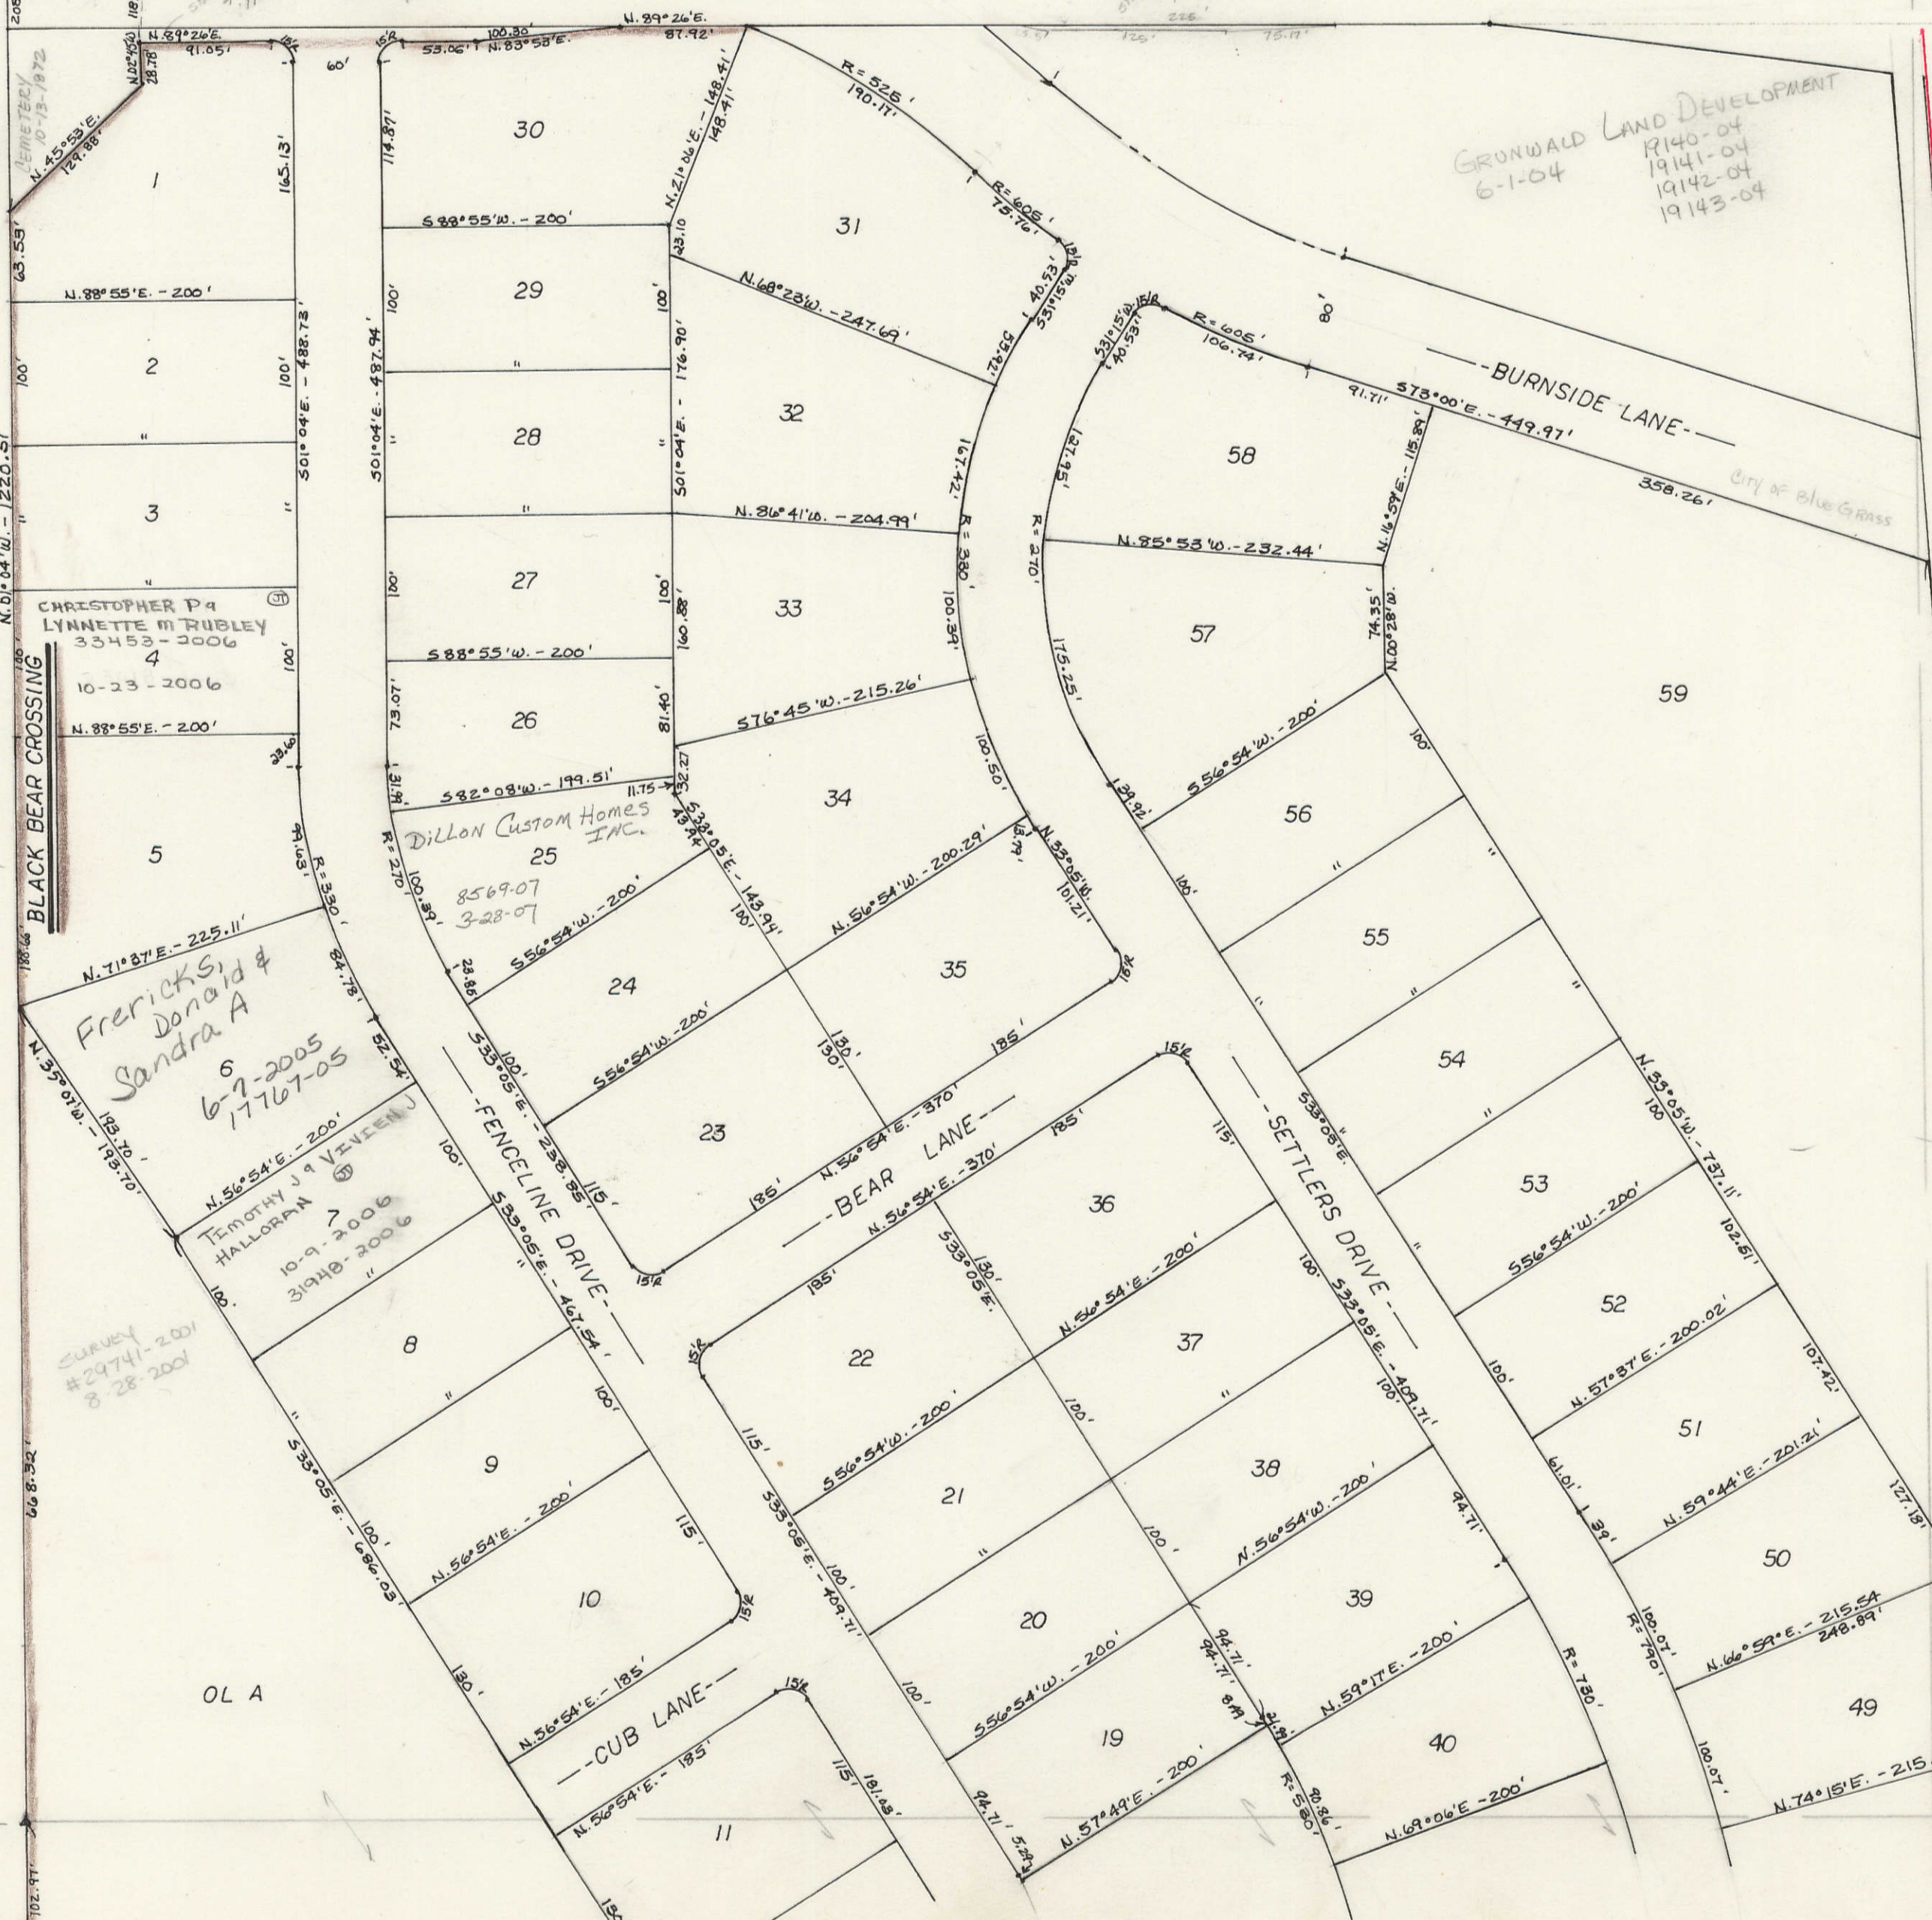

7

21

CITY OF BLUE GRASS - CORP. LIMITS