


53 SEC.-31

Transfer Page 514s-74

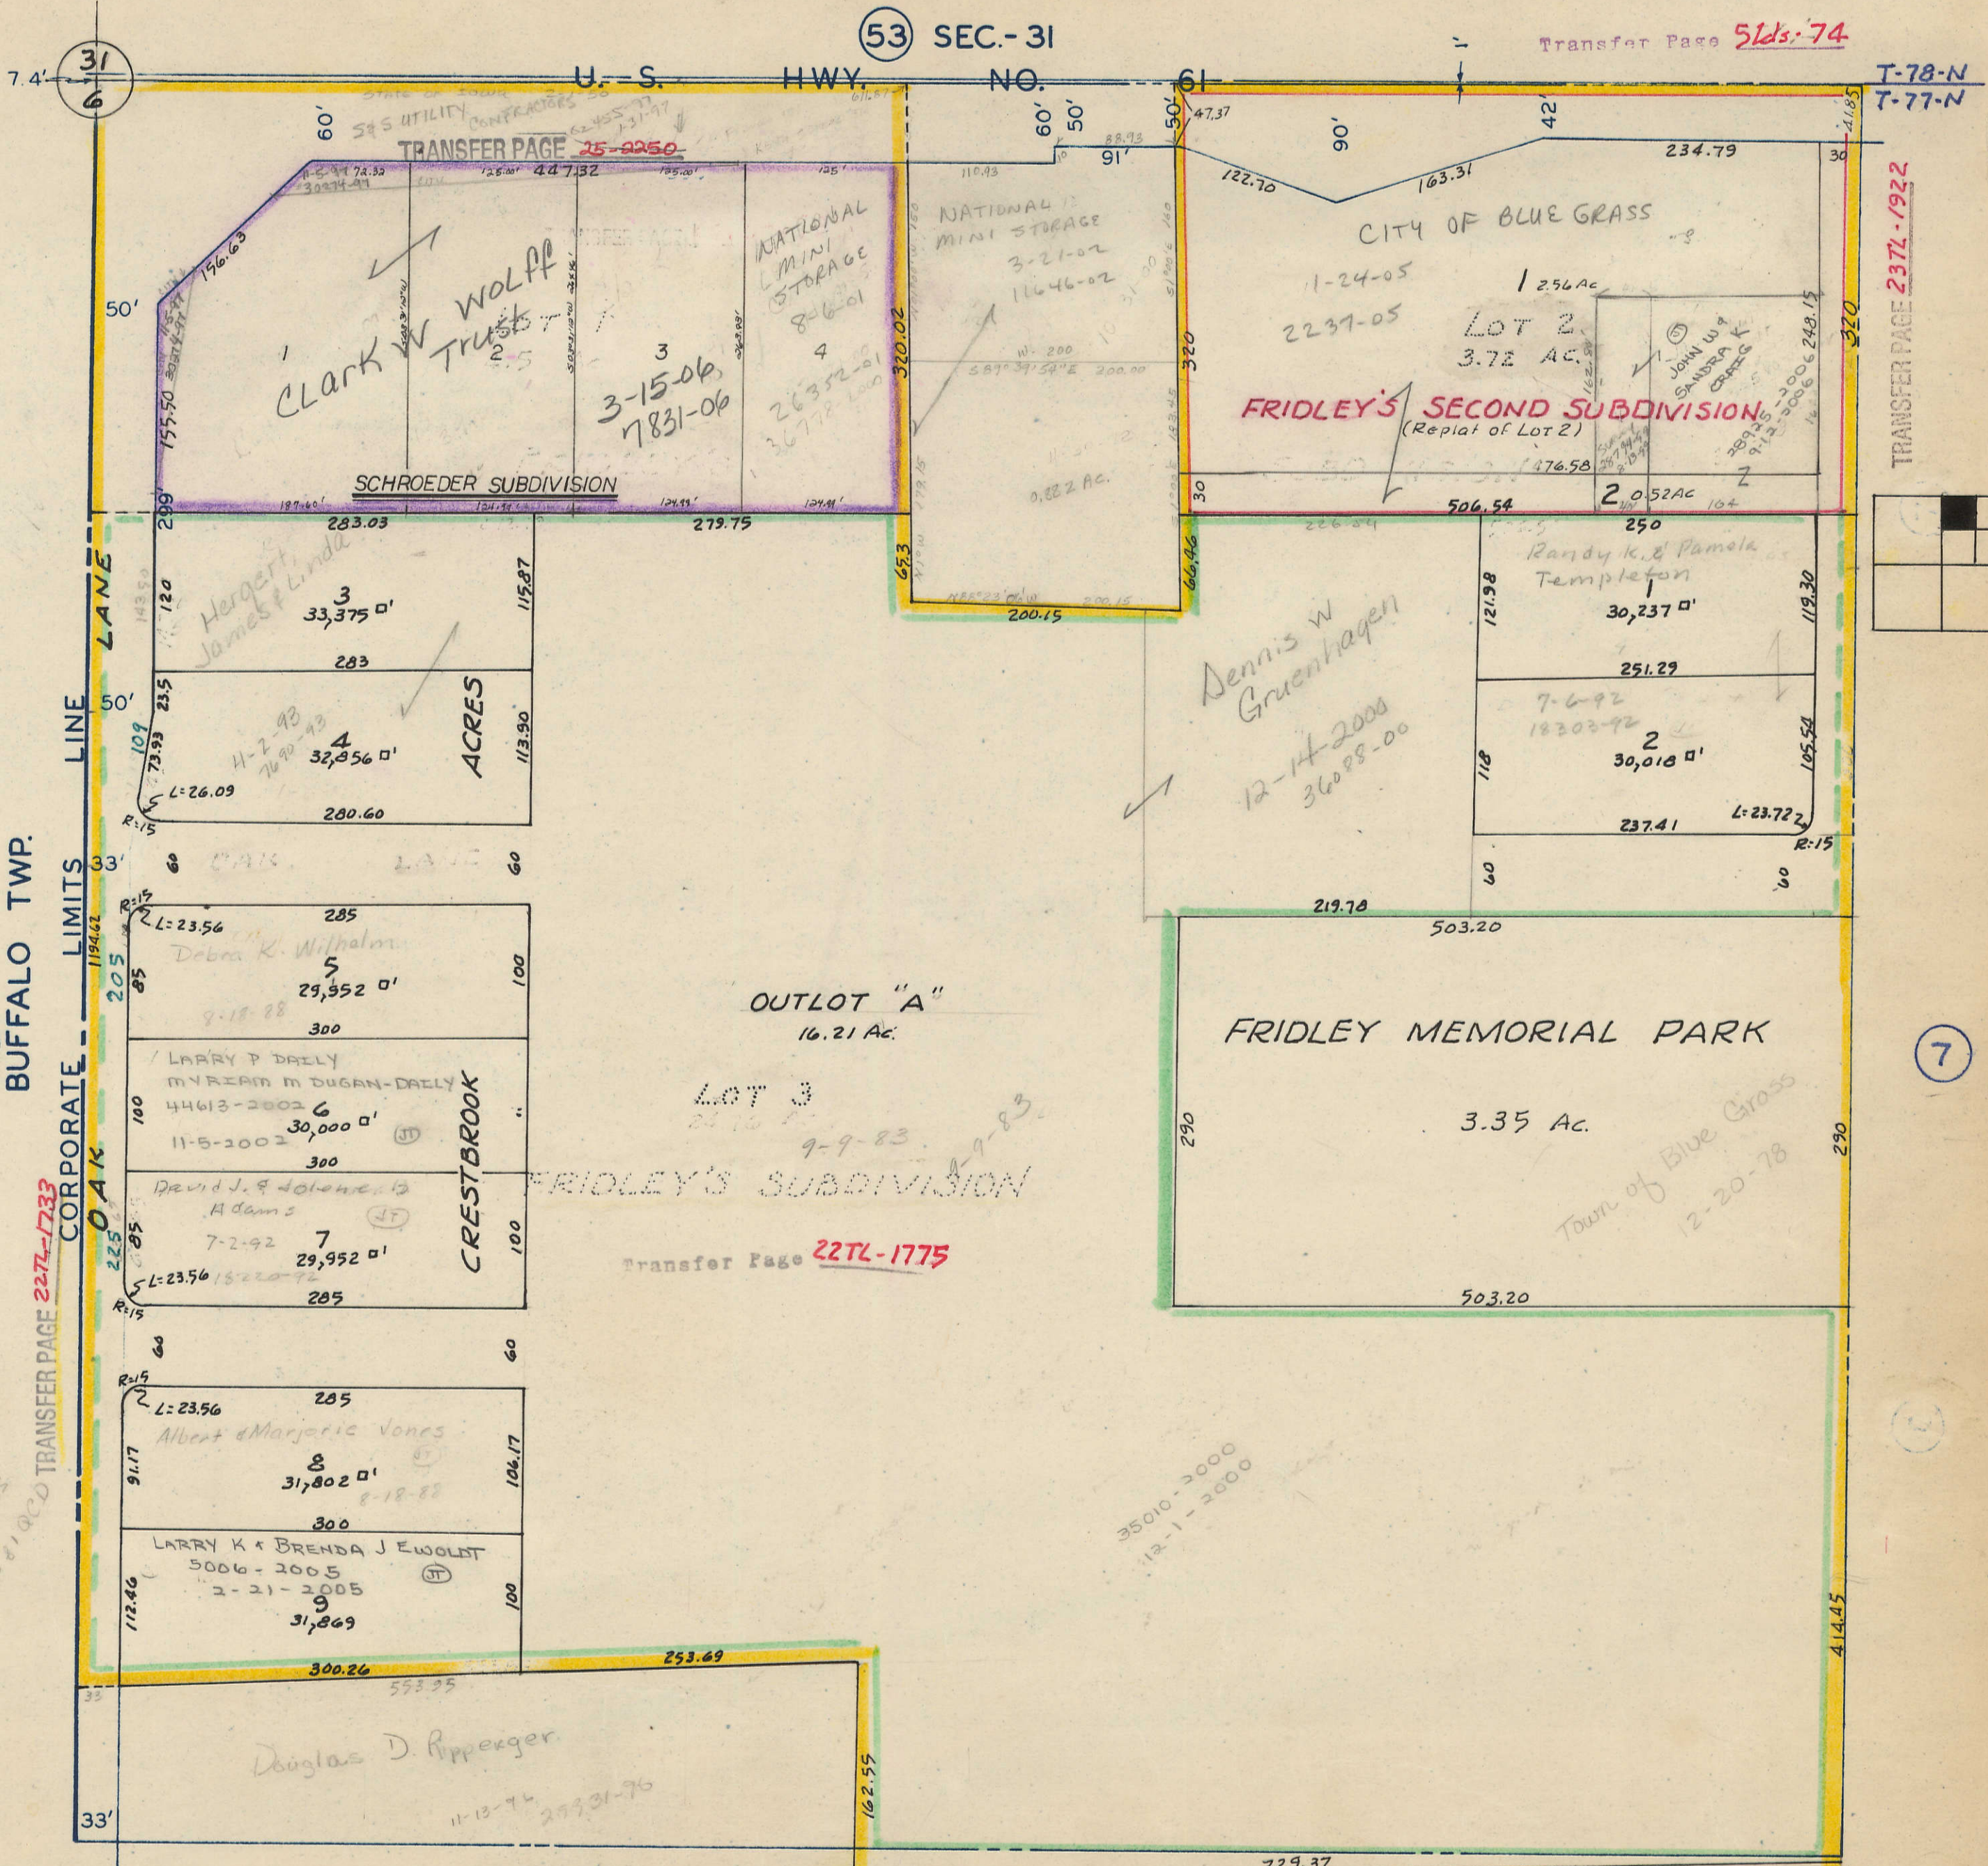

NOTE: - CRESTBROOK ACRES Vacated
 # 12736-81. Rescinding resolution # 16692-82

Roy L. Fridley & Wf
 4-30-43
 12-28-48
 3-9-70
 8-6-79-00D
 8-19-79-00D


CRESTBROOK ACRES
 1075 1-9-71 DL 71
 Charles J. Shirlett
 Jennings
 7-1-81 00D

6 SEC.-6
 BUFFALO TWP.

TRANSFER PAGE 227L-1733

CORPORATE LINE
 OAK LANE

TRANSFER PAGE 237L-1922

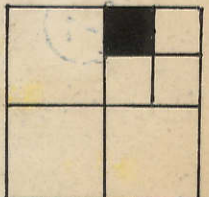

Sec 6-77-2

7

21

LOT 4