
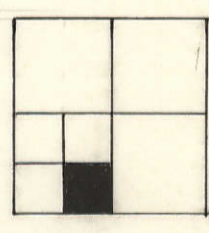


06-38185
SCOTT COUNTY WEST
BUSINESS PARK

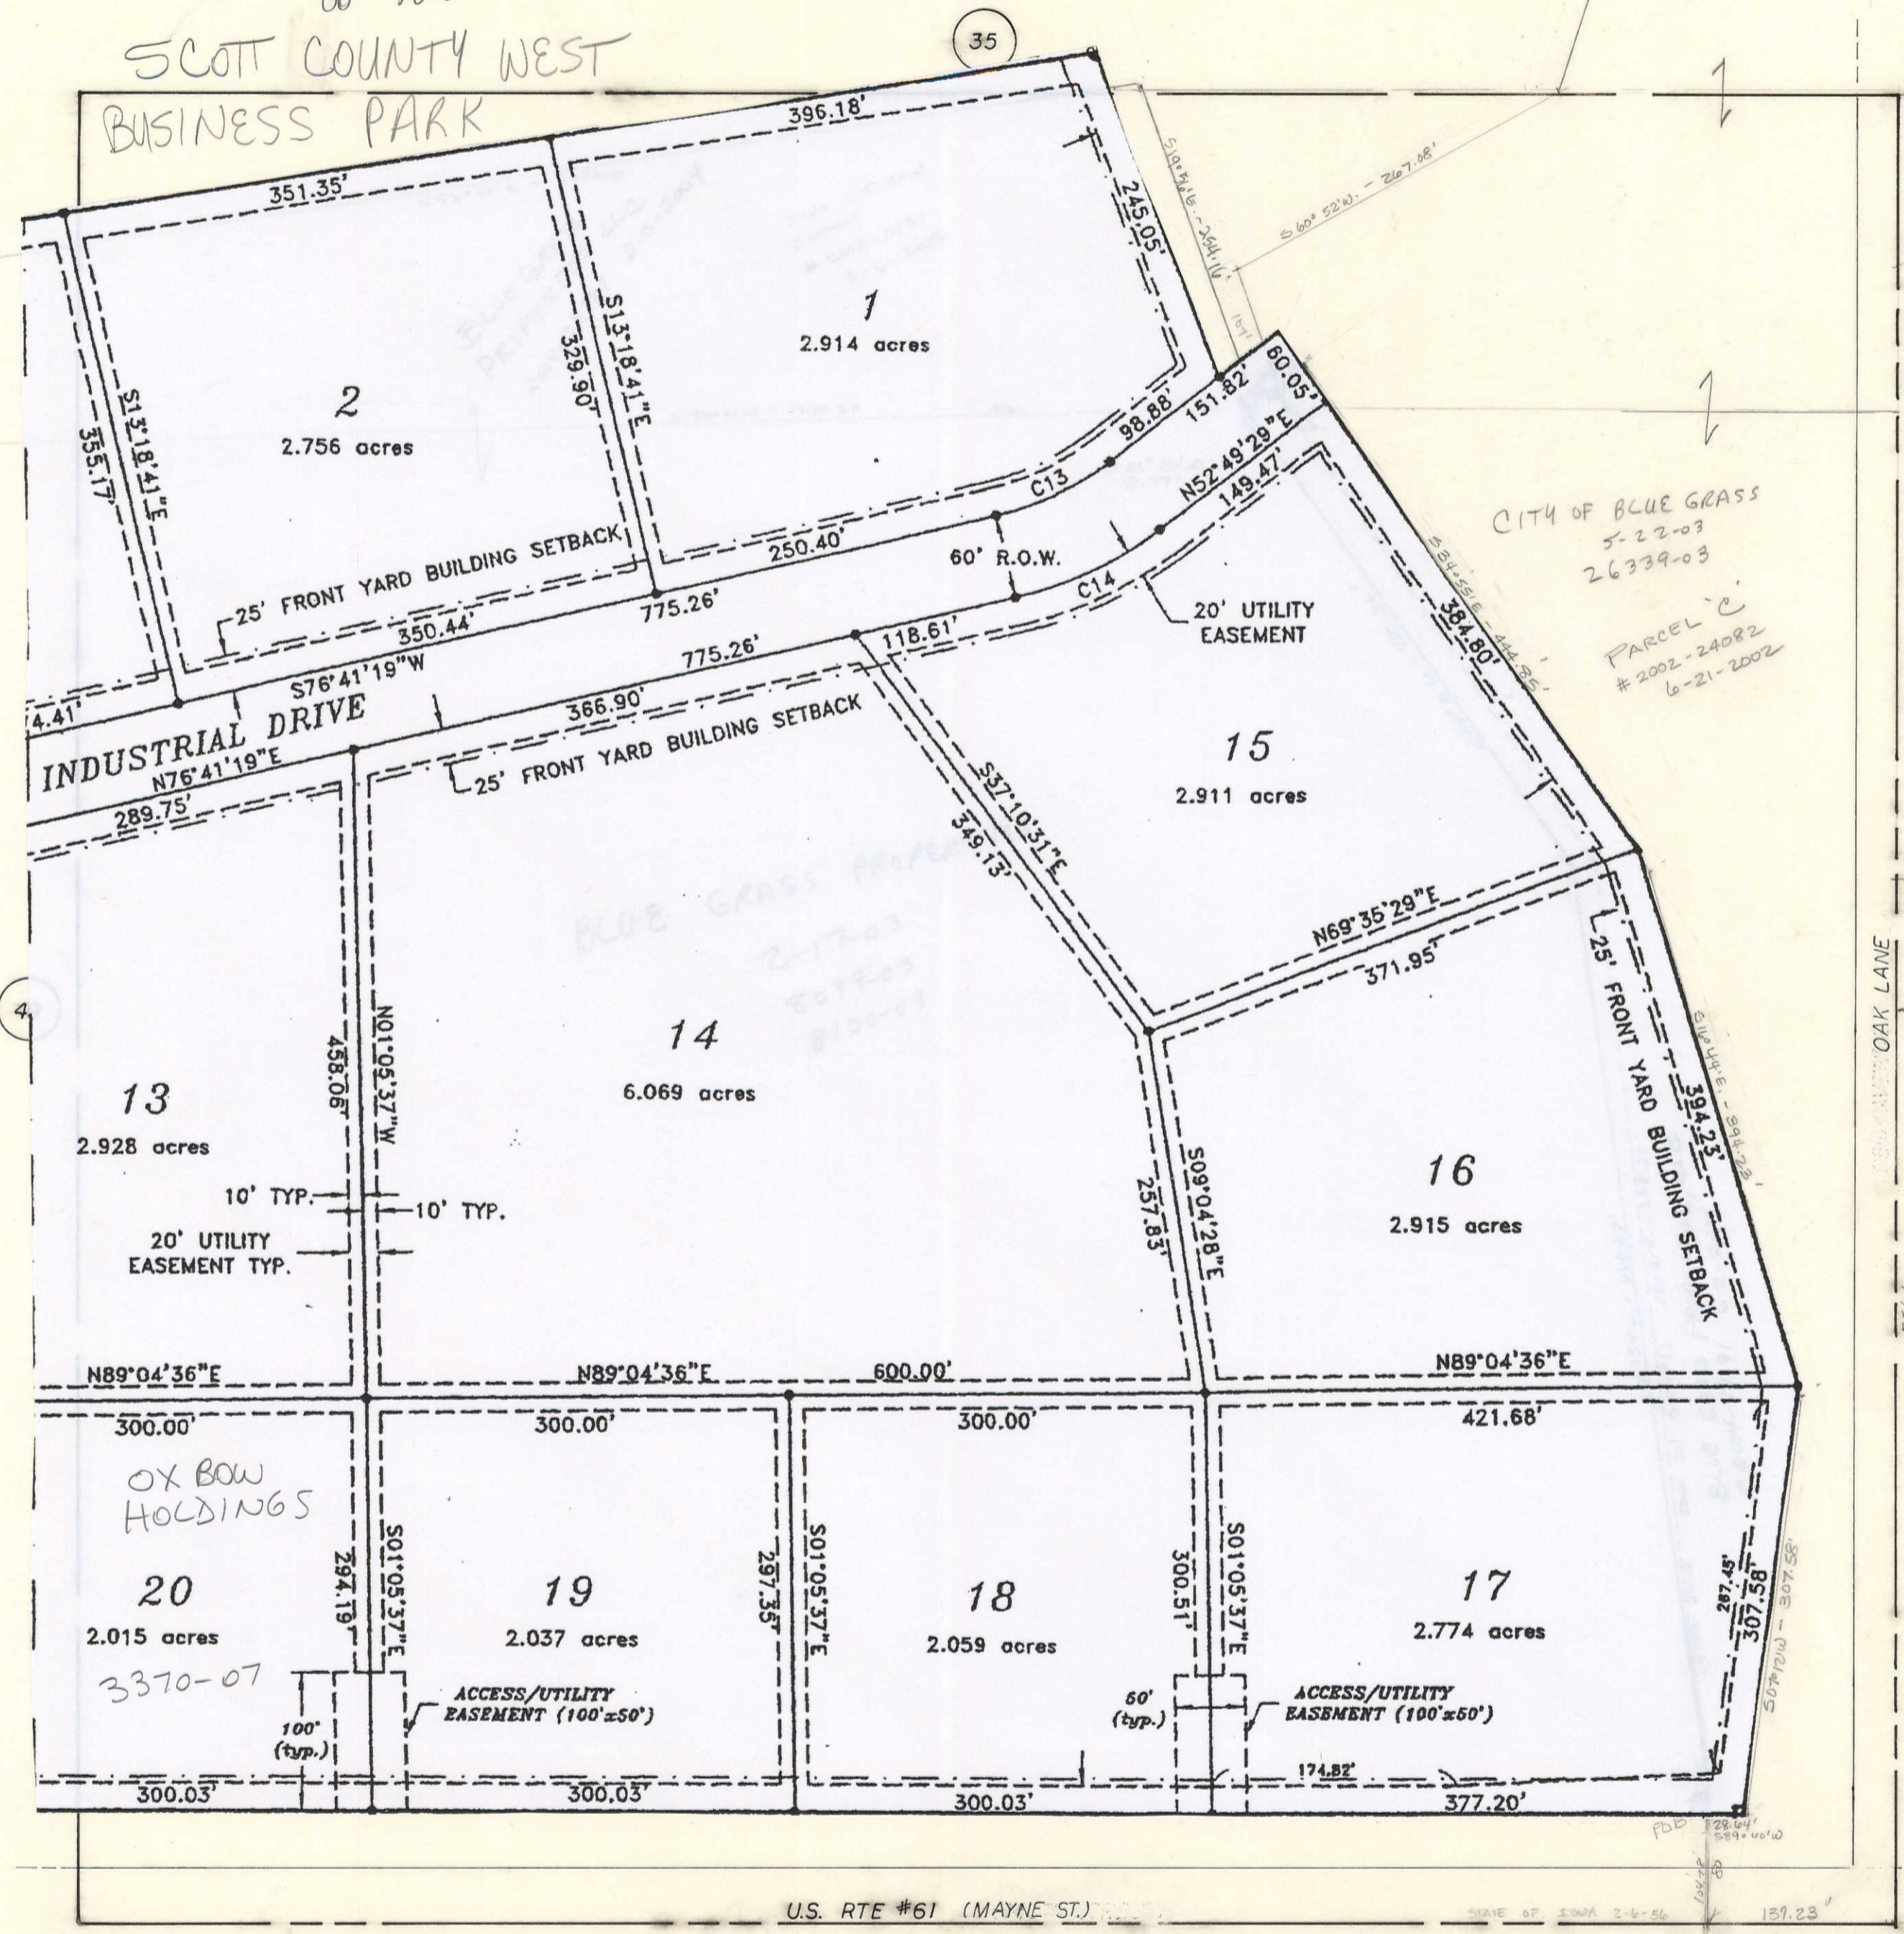

53

U.S. RTE #61 (MAYNE ST.)

SEC. 6