
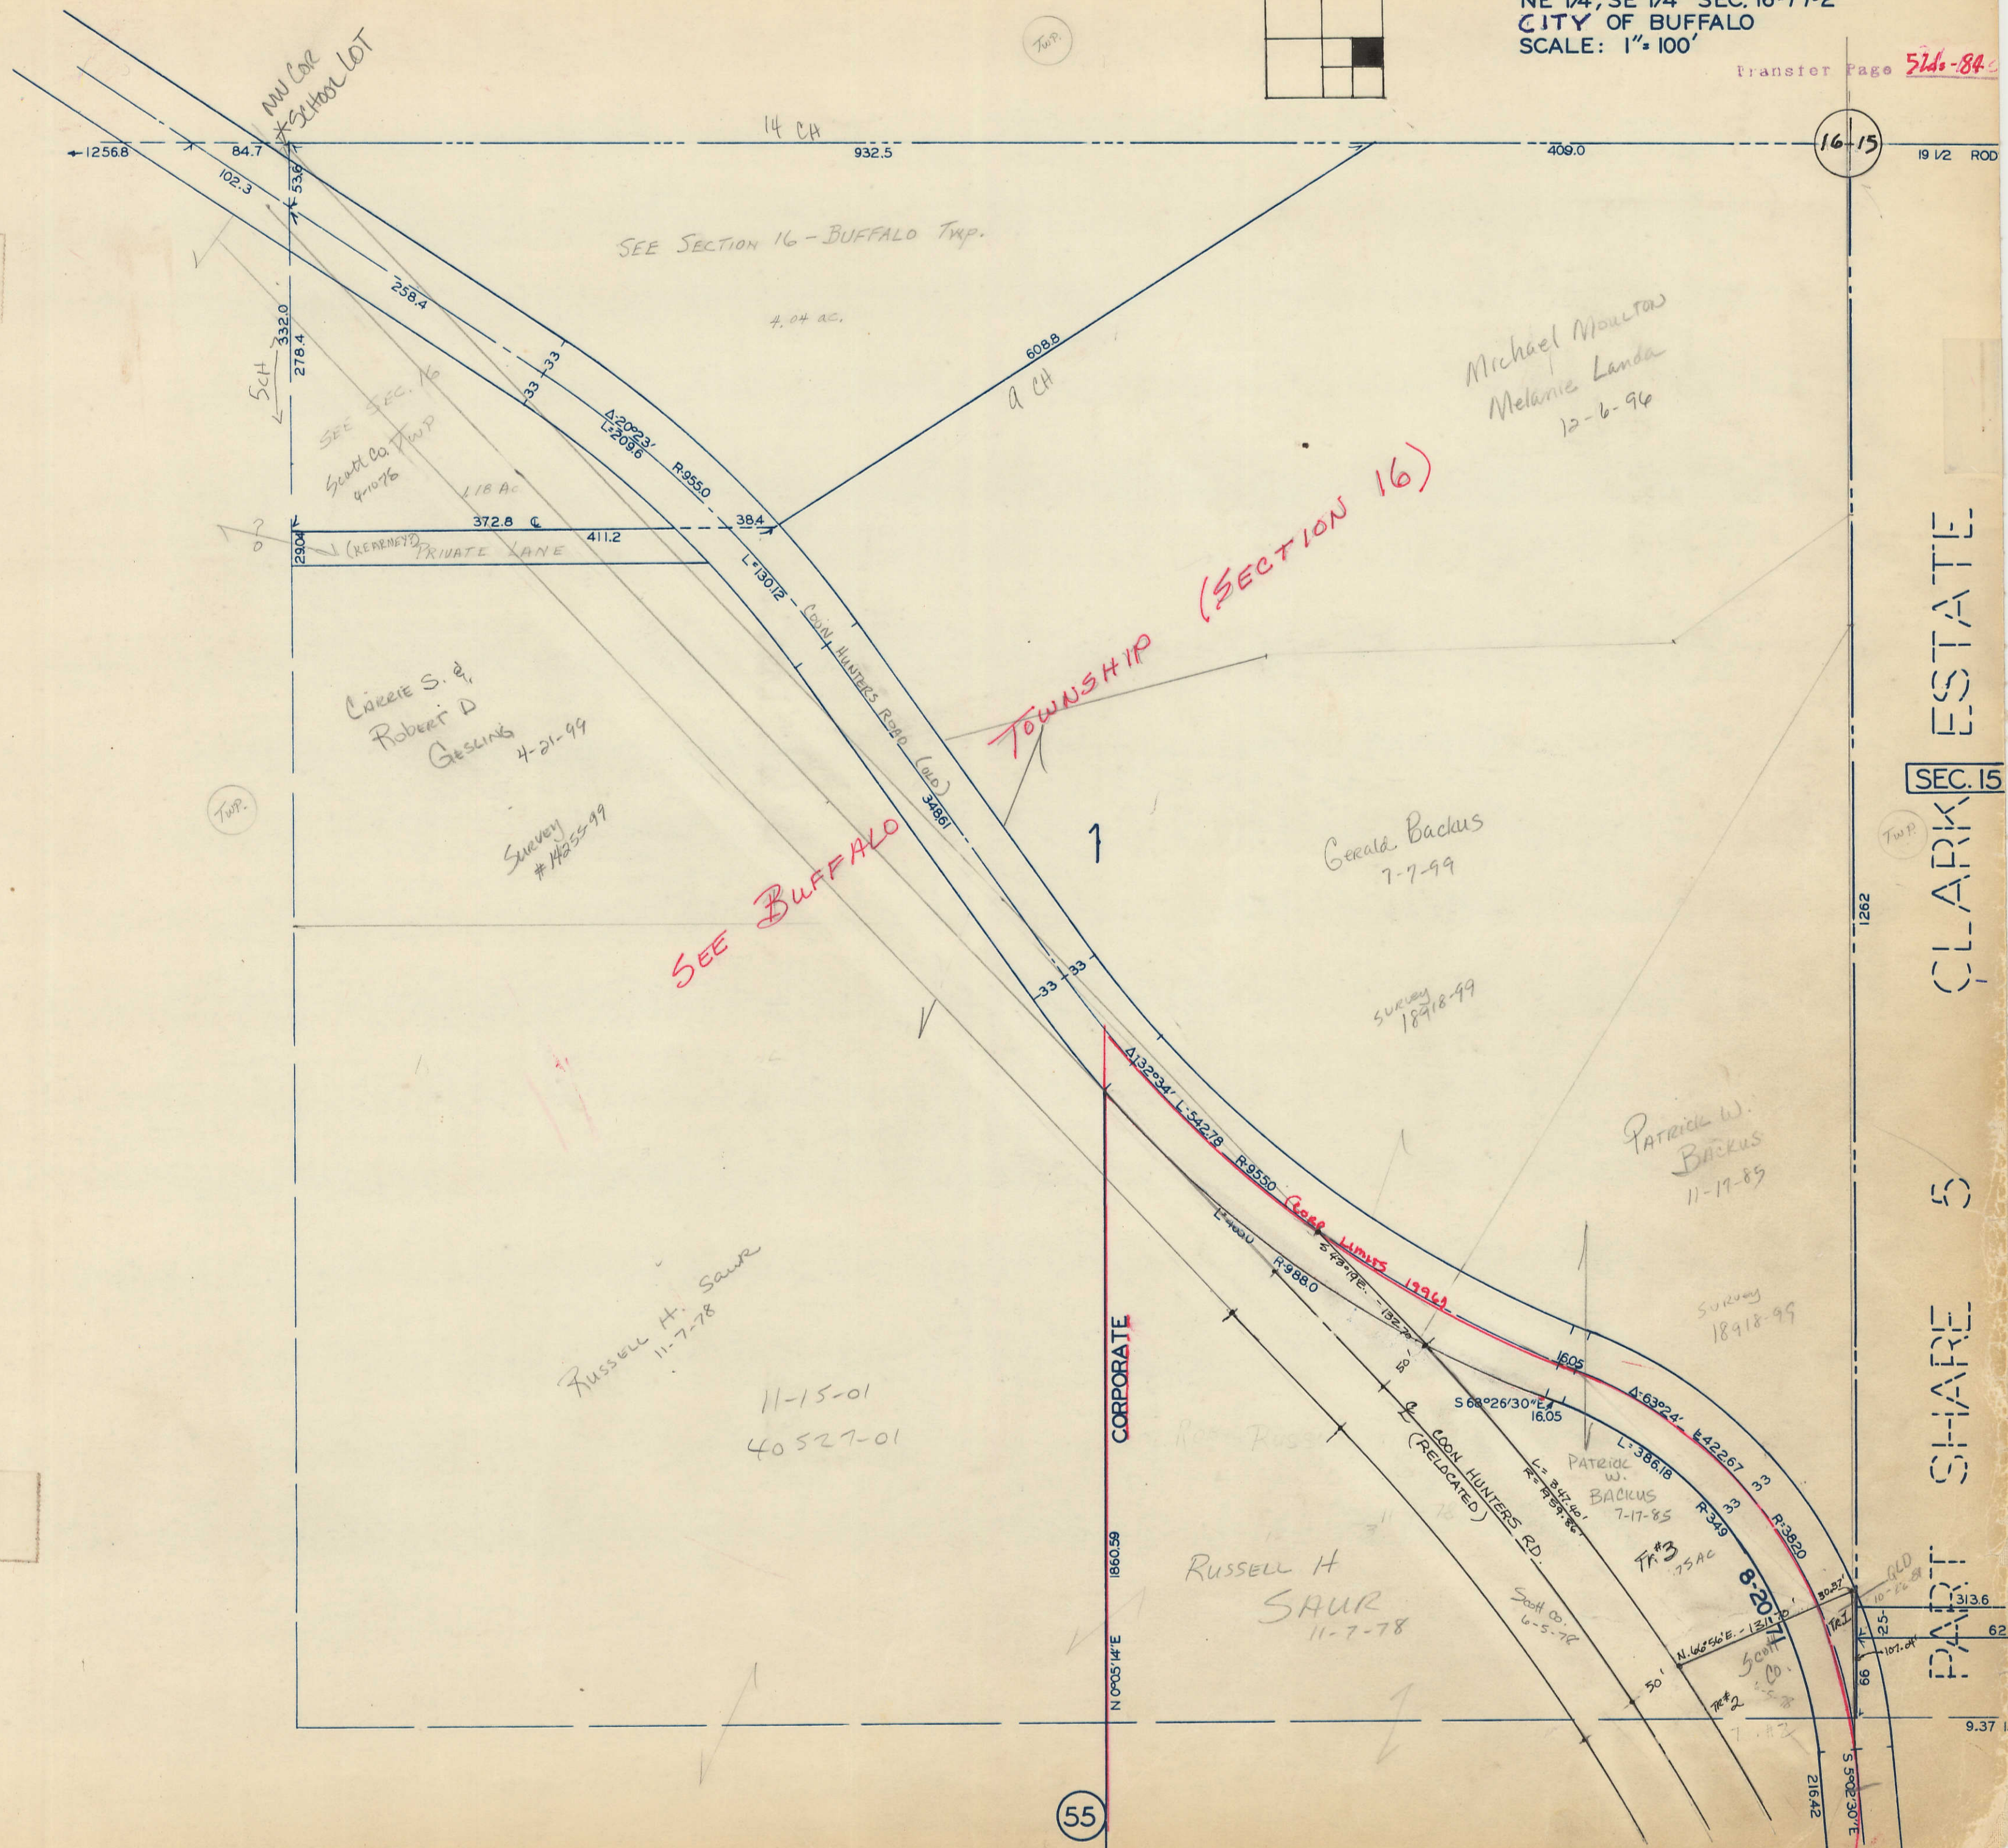


NE 1/4, SE 1/4 SEC. 16-77-2
CITY OF BUFFALO
SCALE: 1" = 100'

Transfer Page 514-84

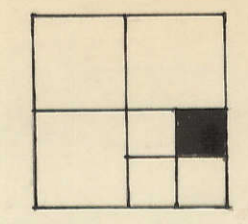

MW Coe
School Lot

SEE SECTION 16 - BUFFALO TWP.

Michael Moulton
Melanie Landa
12-6-96

SEE SEC. 16
Scott Co. TWP
41076

CARRIE S. &
ROBERT D.
GESLINS
4-21-99

Survey
4255-99

SEE BUFFALO

Gerald Backus
7-7-99

Survey
18918-99

PATRICK W.
BACKUS
11-19-85

Survey
18918-99

Russell H. SAUR
11-7-78

11-15-01
40527-01

RUSSELL H
SAUR
11-7-78

PATRICK W.
BACKUS
7-17-85

Scott Co.
6-5-78

Scott Co.
7-1-72

CLARK ESTATE
SEC. 15
PART SHARE 5

16-15

19 1/2 ROD

1262

9.37

55