
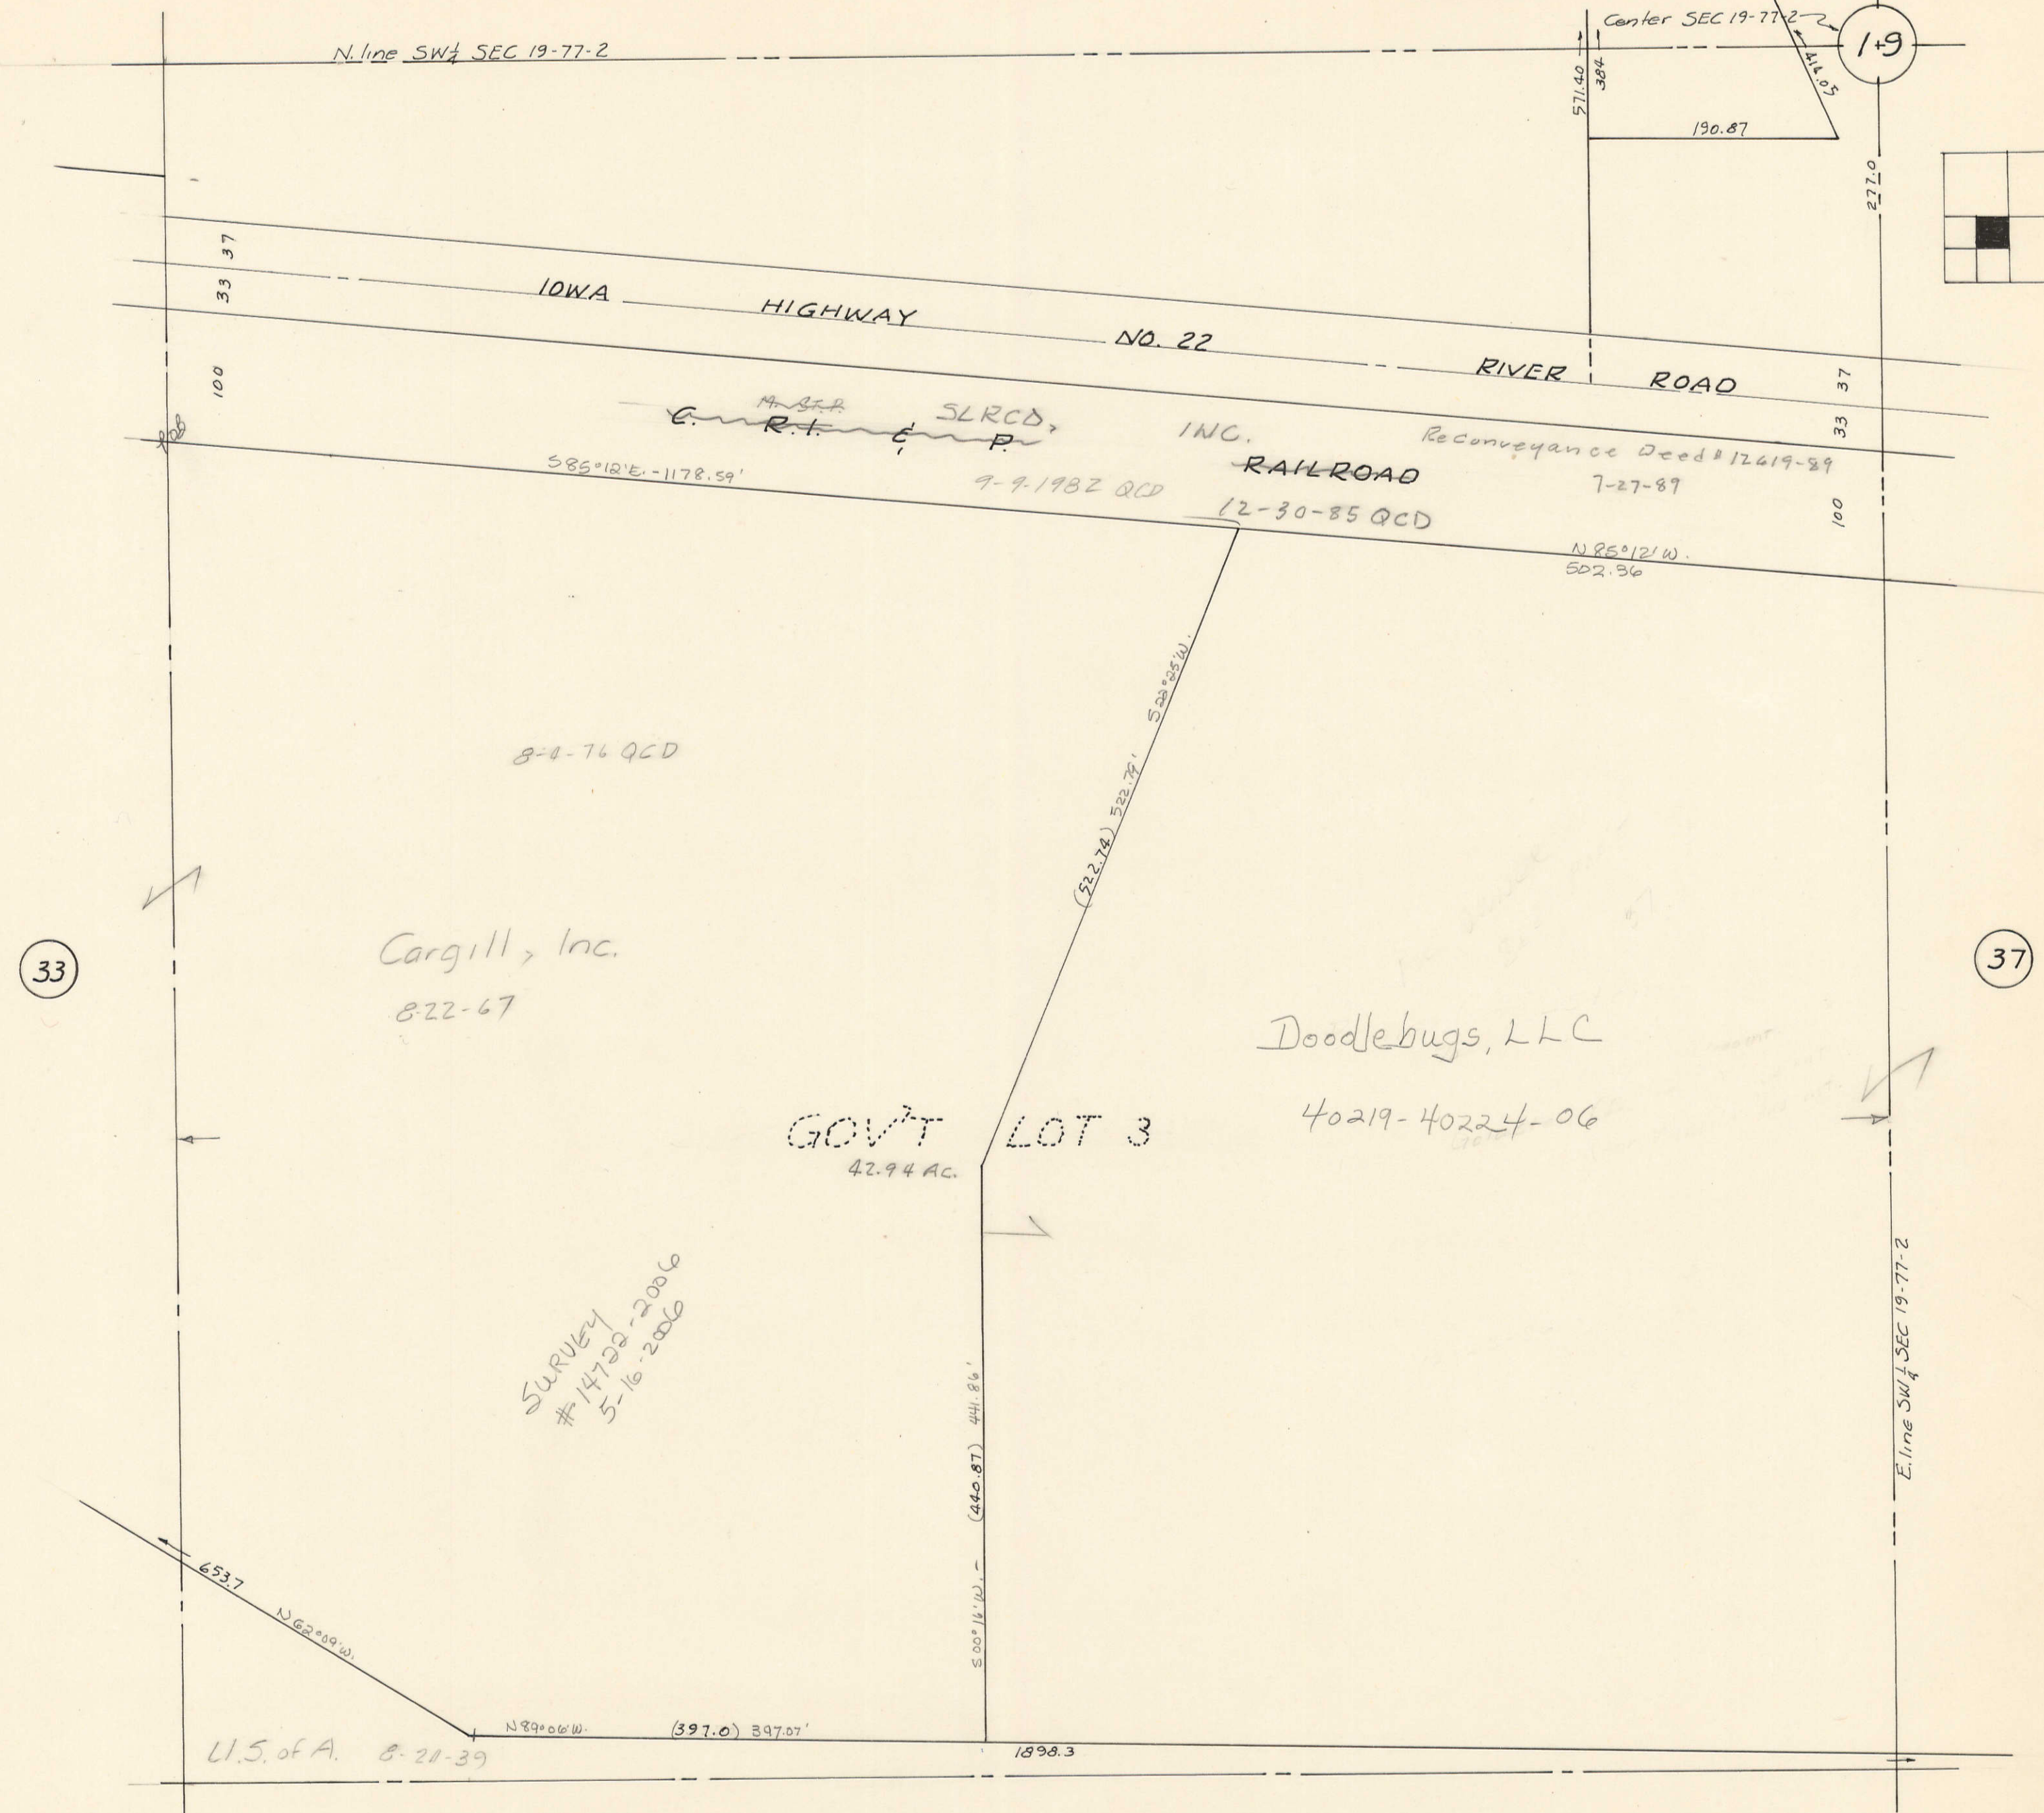


NE 1/4 SW 1/4 SEC 19-77-2
CITY OF BUFFALO
SCALE:- 1" = 100'

TRANSFER PAGE 35
5lds-87

19

19

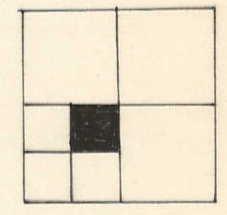

33

37

51

N. line SW 1/4 SEC 19-77-2

Center SEC 19-77-2

33 37
100

IOWA HIGHWAY NO. 22

RIVER ROAD

C.R.T. P. RAILROAD
SLRCD, INC.
Reconveyance Deed #12619-89
7-27-89
9-9-1982 QCD
12-30-85 QCD

S85°12'E - 1178.59'

N 85°12' W
502.36

8-1-76 QCD

Cargill, Inc.
822-67

Doodlebugs, LLC
40219-40224-06

GOV'T LOT 3
42.94 AC.

SURVEY
14722-2006
5-16-2006

653.7
N 62°09' W

U.S. of A. 8-21-39

N 89°06' W (397.0) 397.07'

S 00°14' W (440.87) 441.86'

1898.3

E. line SW 1/4 SEC 19-77-2

277.0

33 37
100