
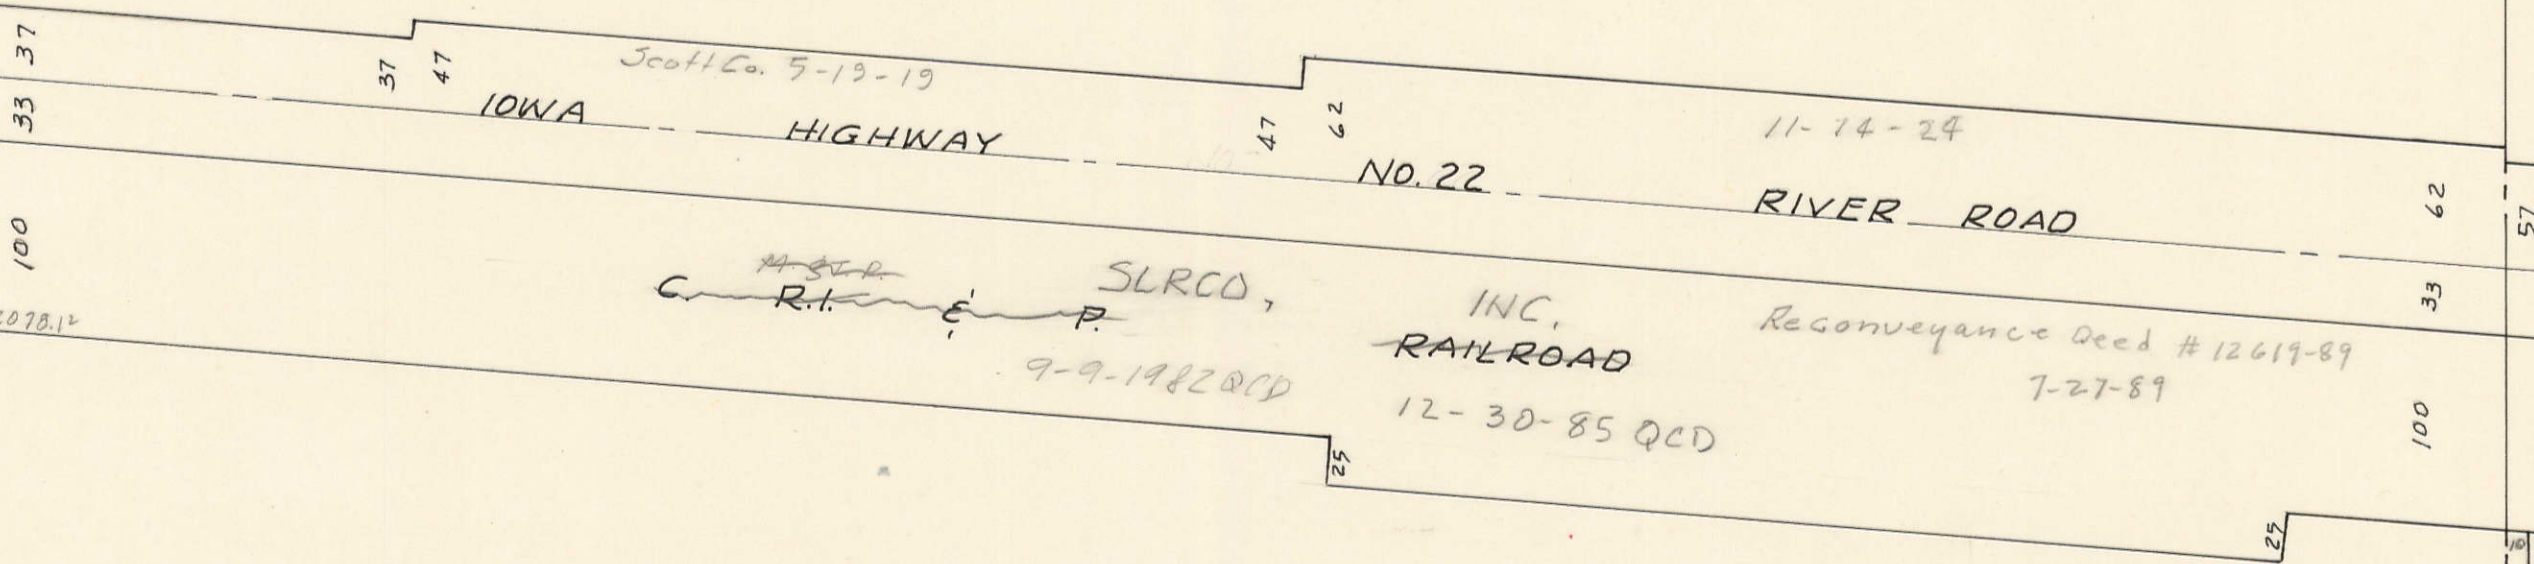


(21)

Center SEC 19-77-2
149

N. line SE 1/4 SEC 19-77-2

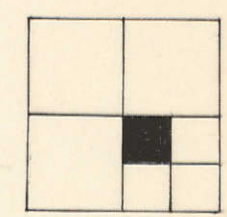

(35)

W. line SE 1/4 SEC 19-77-2

GOV'T LOT 2
4956 AC.

Doodlebugs, LLC

40219-40224-06

(39)

(53)