



SE 1/4, SE 1/4 SEC. 16-77-2
CITY OF BUFFALO
SCALE: 1" = 100'

Transfer Page 516s-84

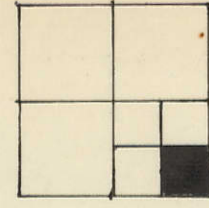

39

313.6
625.1
9.375

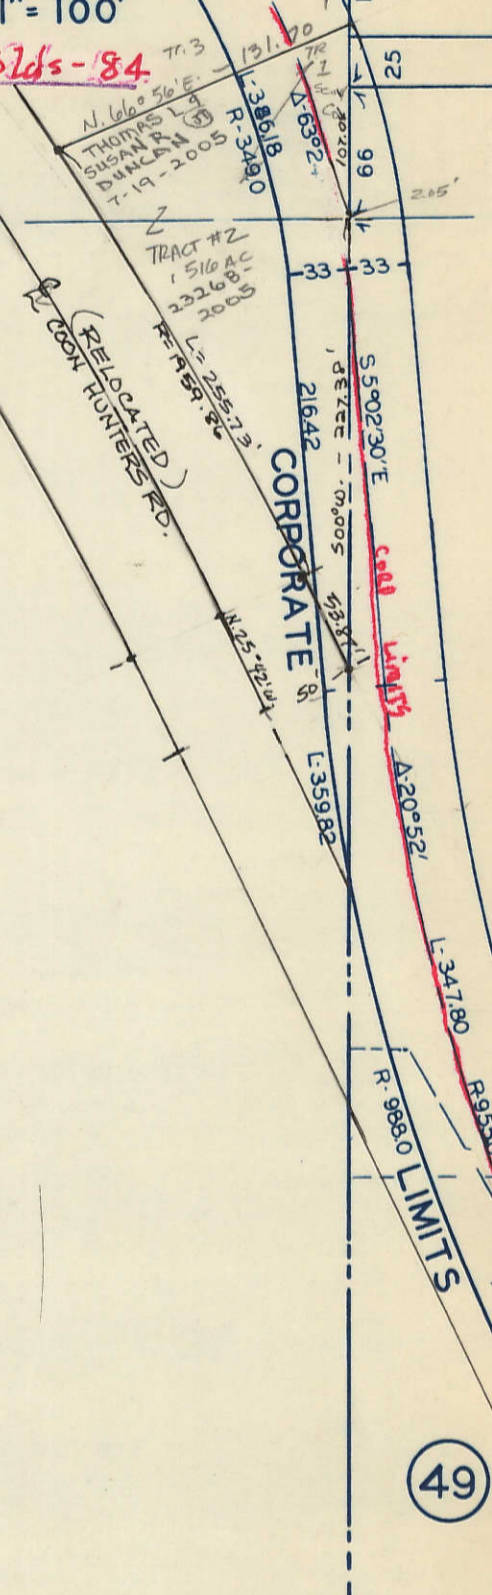

SEE ALSO BUFFALO TOWNSHIP
SECTION 16

ROBERT ALEXANDER
ETAL, TRUSTEE

RUSSELL H. SAUR

11-7-78

11-15-01

40527-01

8-20-71

LIMITS N 0°05'14"E 1860.59

4

CORPORATE

49

SEC. 15

W 642.95

396±

1615
2122

N 3°33'09"W
1985.501 196

SEC. 21

LOCUST GROVE ADD.
8 OUTLOT 24

TOP