


TRANSFER PAGE 54ds-91

17

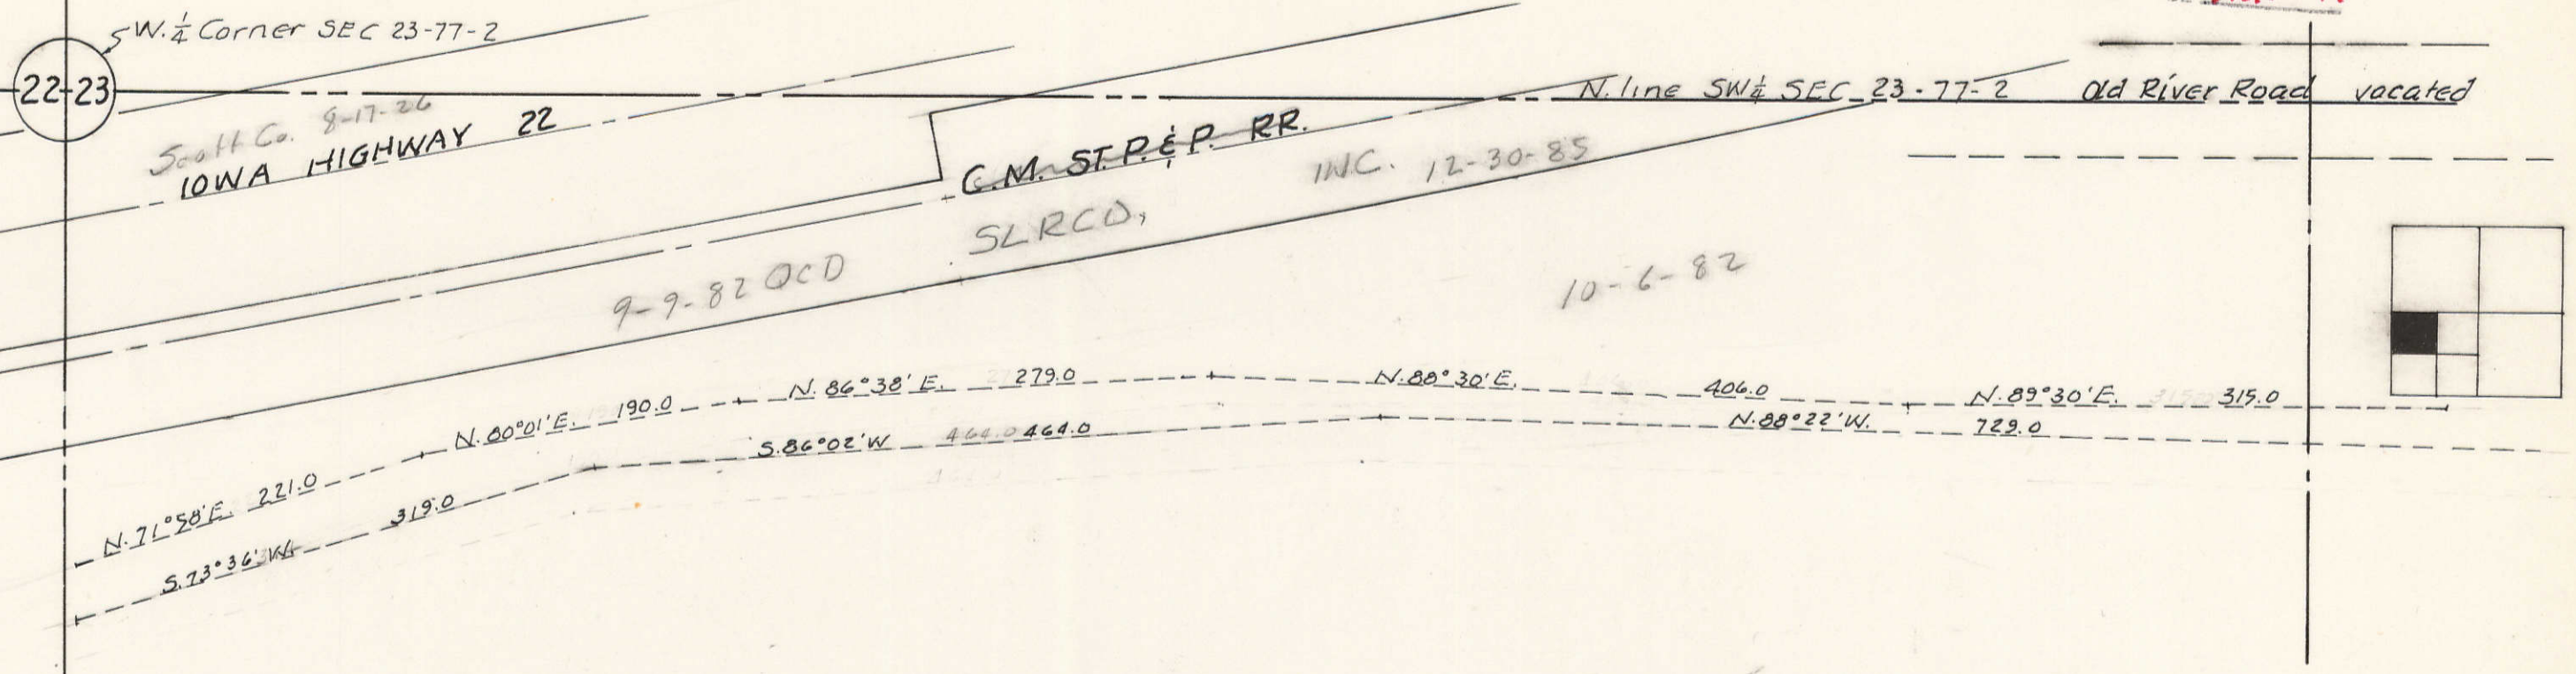

SEC 22

39

Section line between SECS 23 & 22

MISSISSIPPI RIVER

35