


35

Transfer Fee 54s-81

49

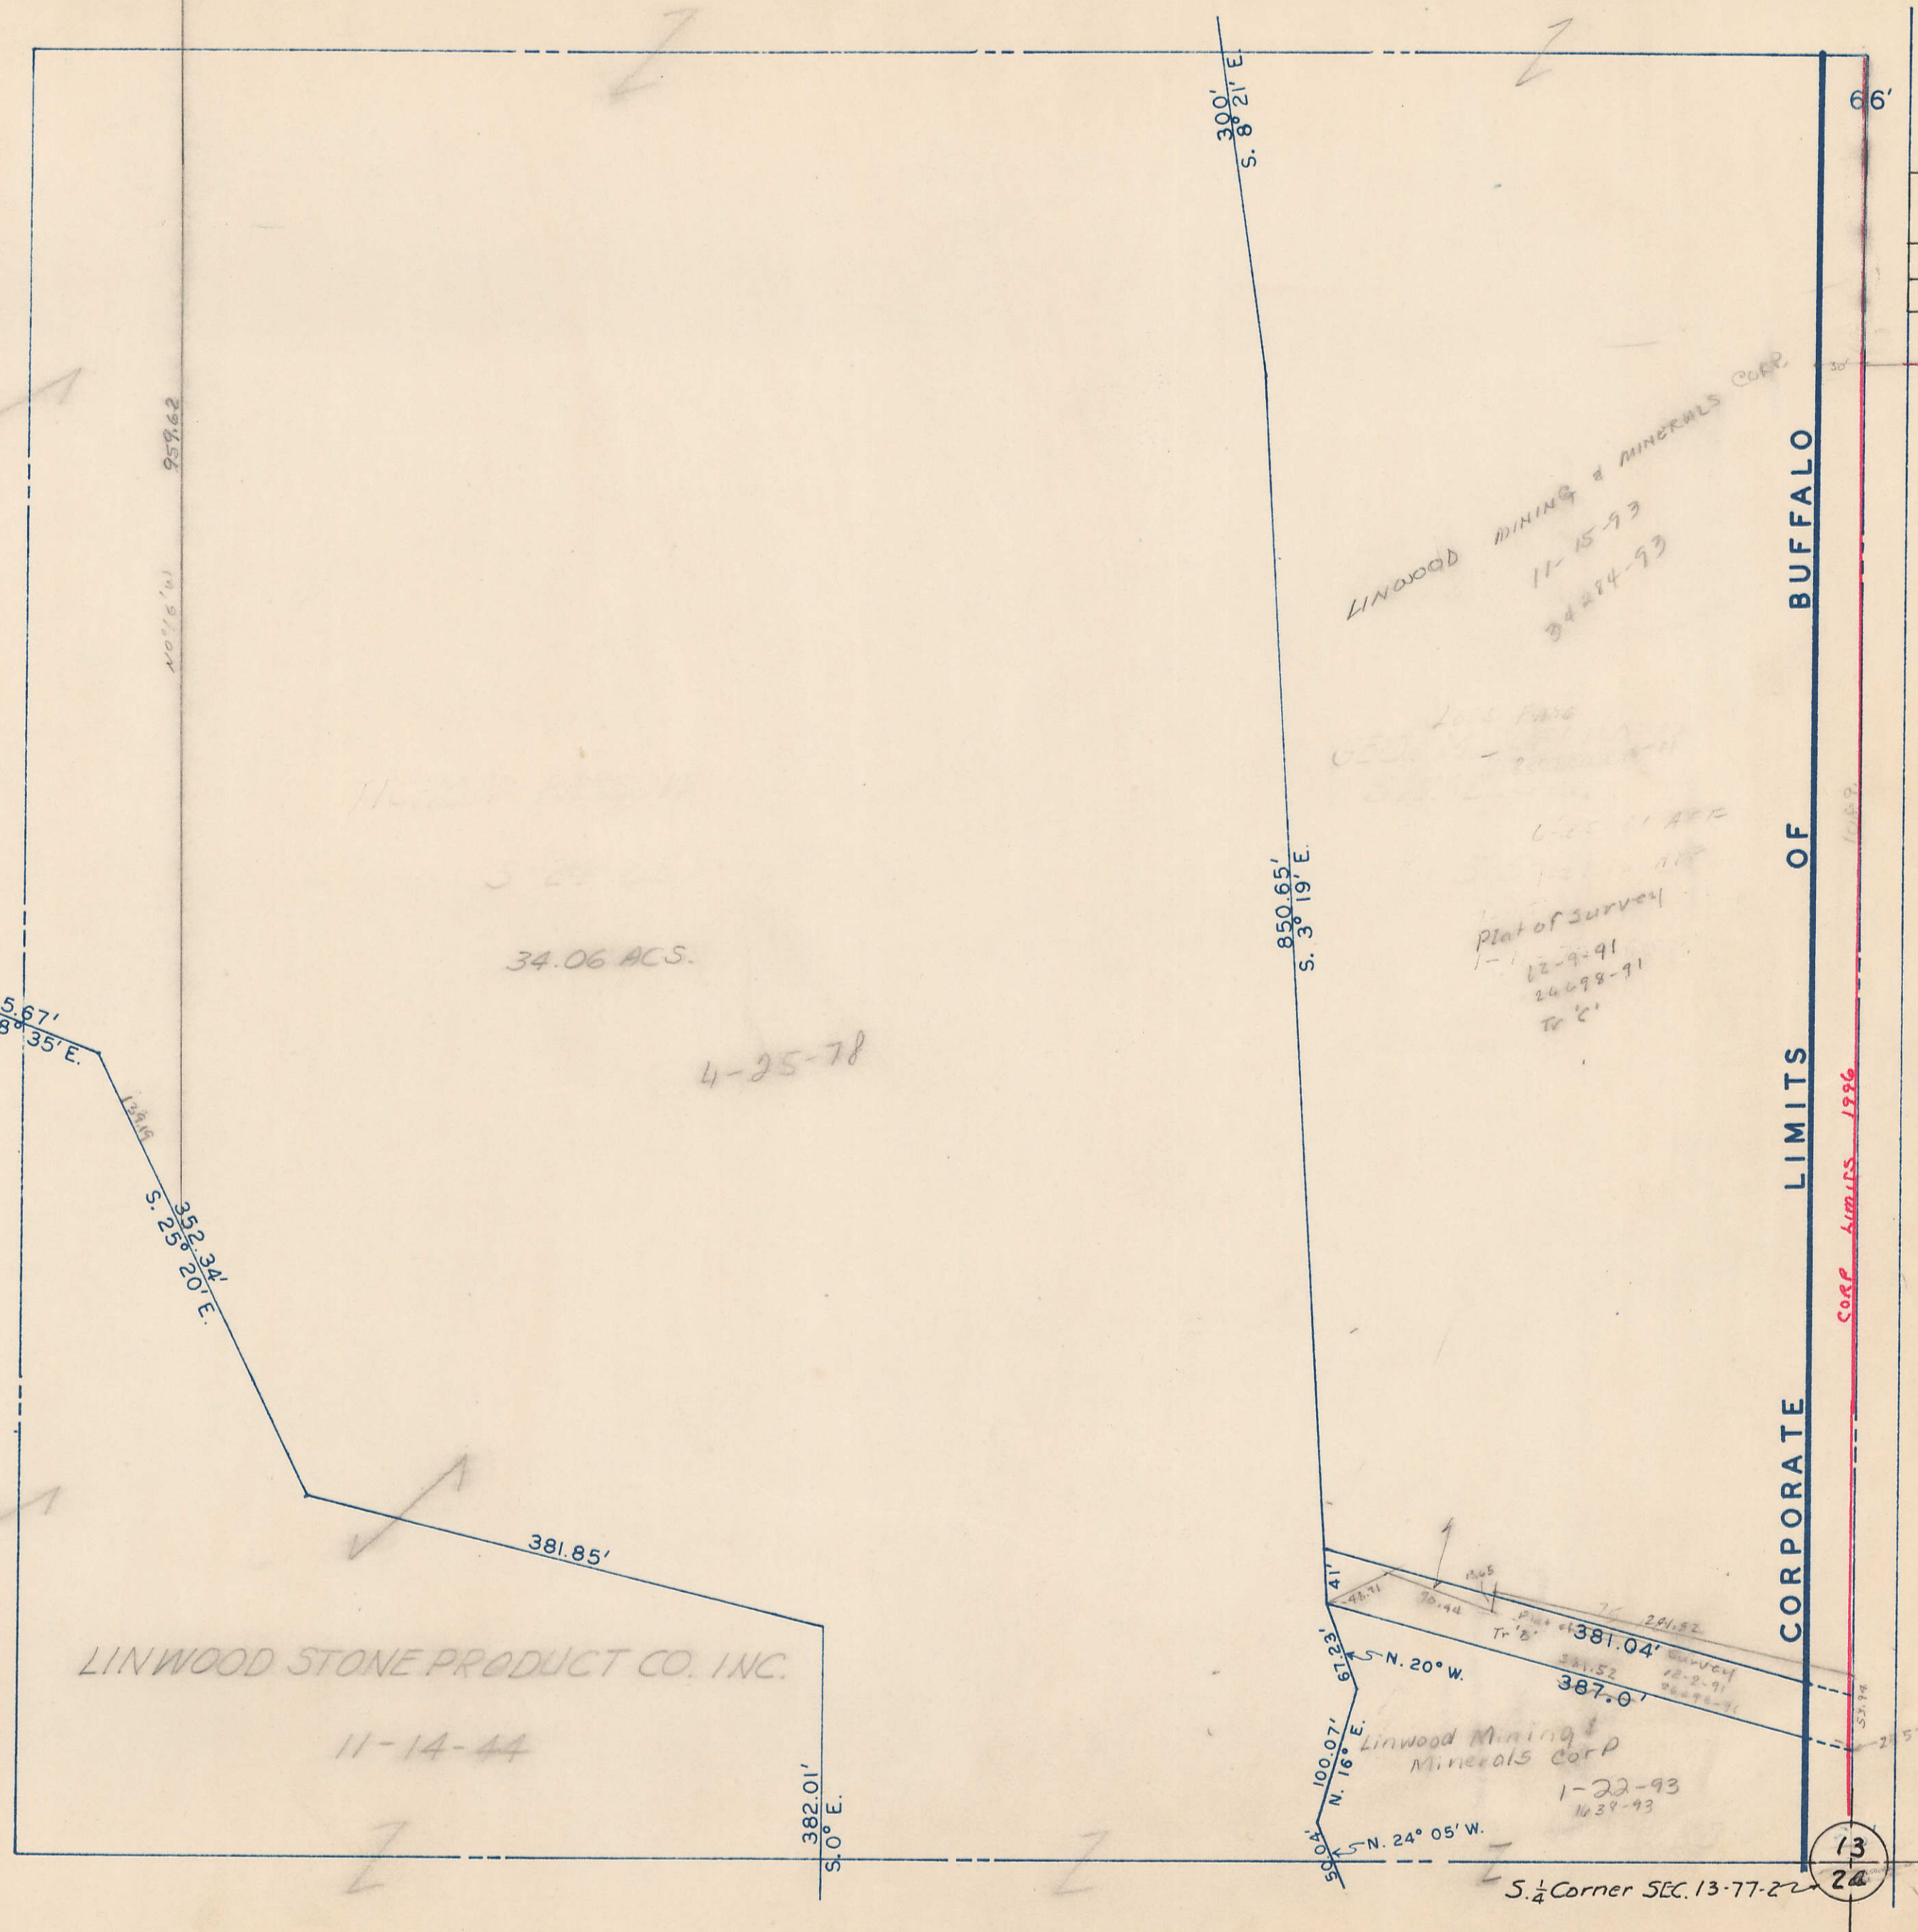

BUFFALO TOWNSHIP SW 1/4 SEC. 13

3 SEC. 24