


115<sup>TH</sup> AVENUE  
CORP. LIMITS 1996

19


115<sup>TH</sup> AVENUE  
CORP. LINE 1996

1-3

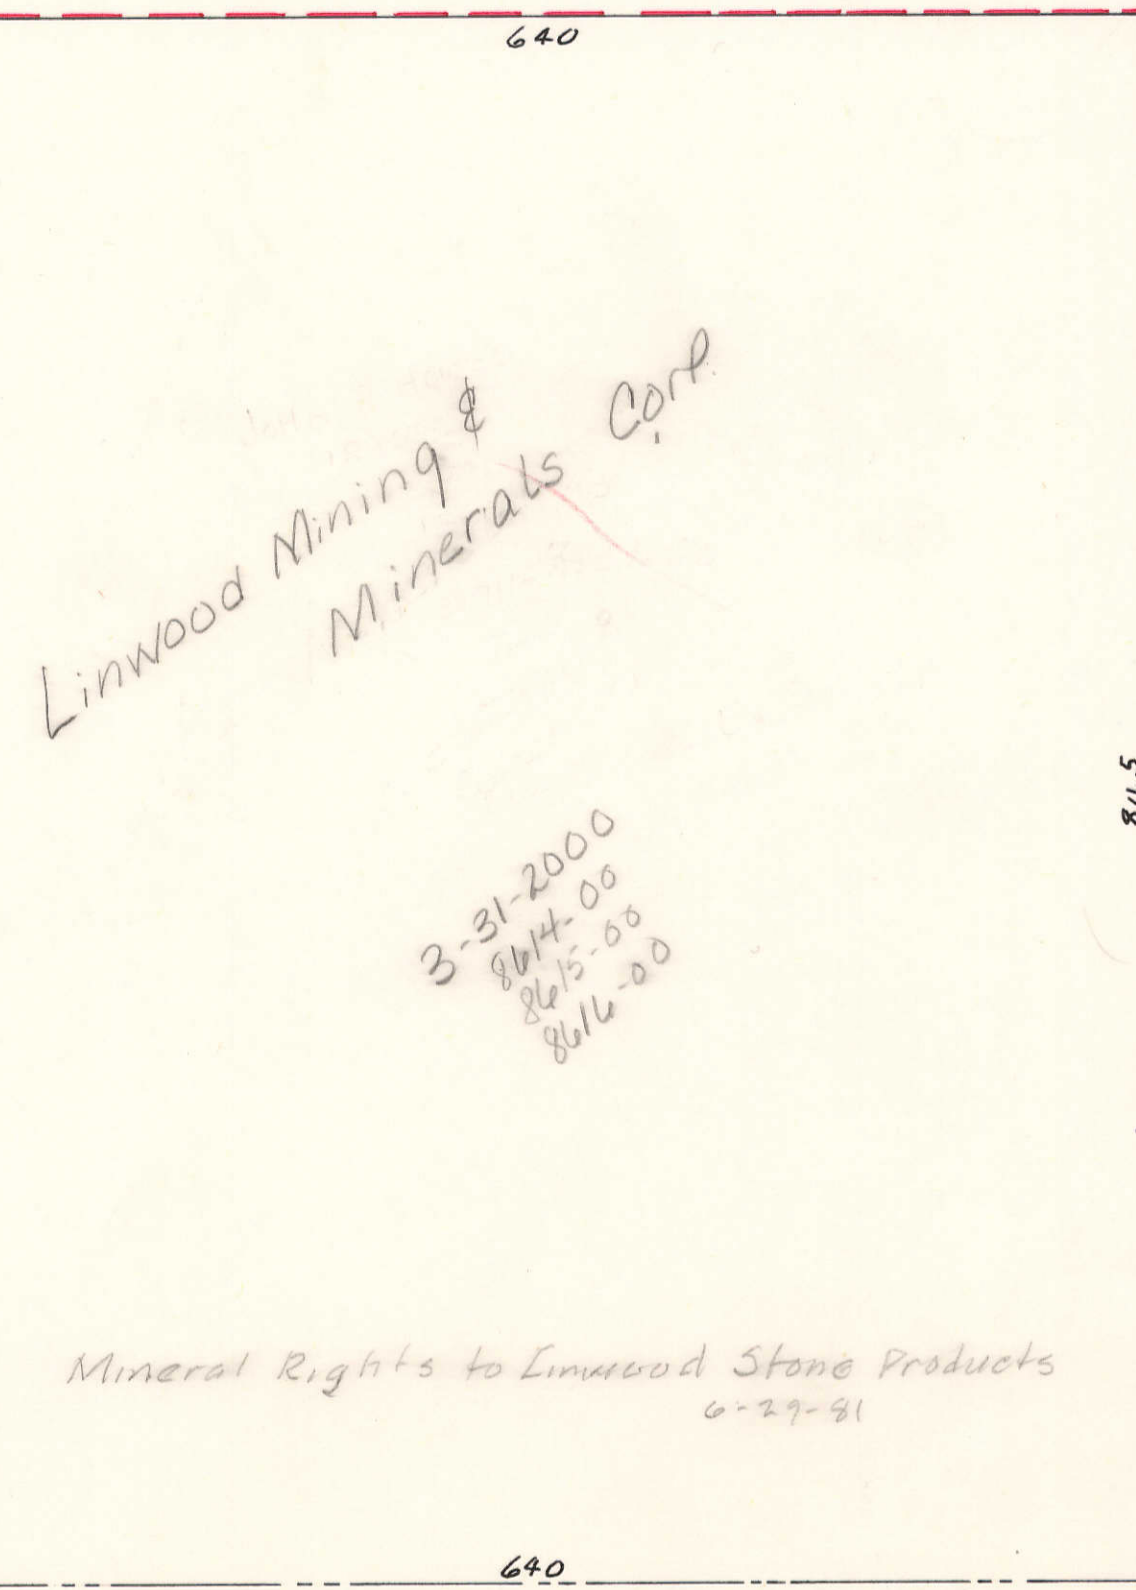

Linwood Mining & Minerals Corp.  
9-4-90  
10/89-90

ANNEXED TO BUFFALO  
3-16-96

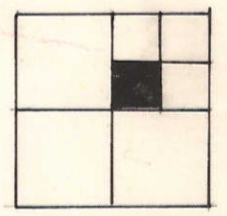

SE 1/4 NE 1/4 SEC. 13-77-2

Corporate Limits Nov. 14, 1989

37