
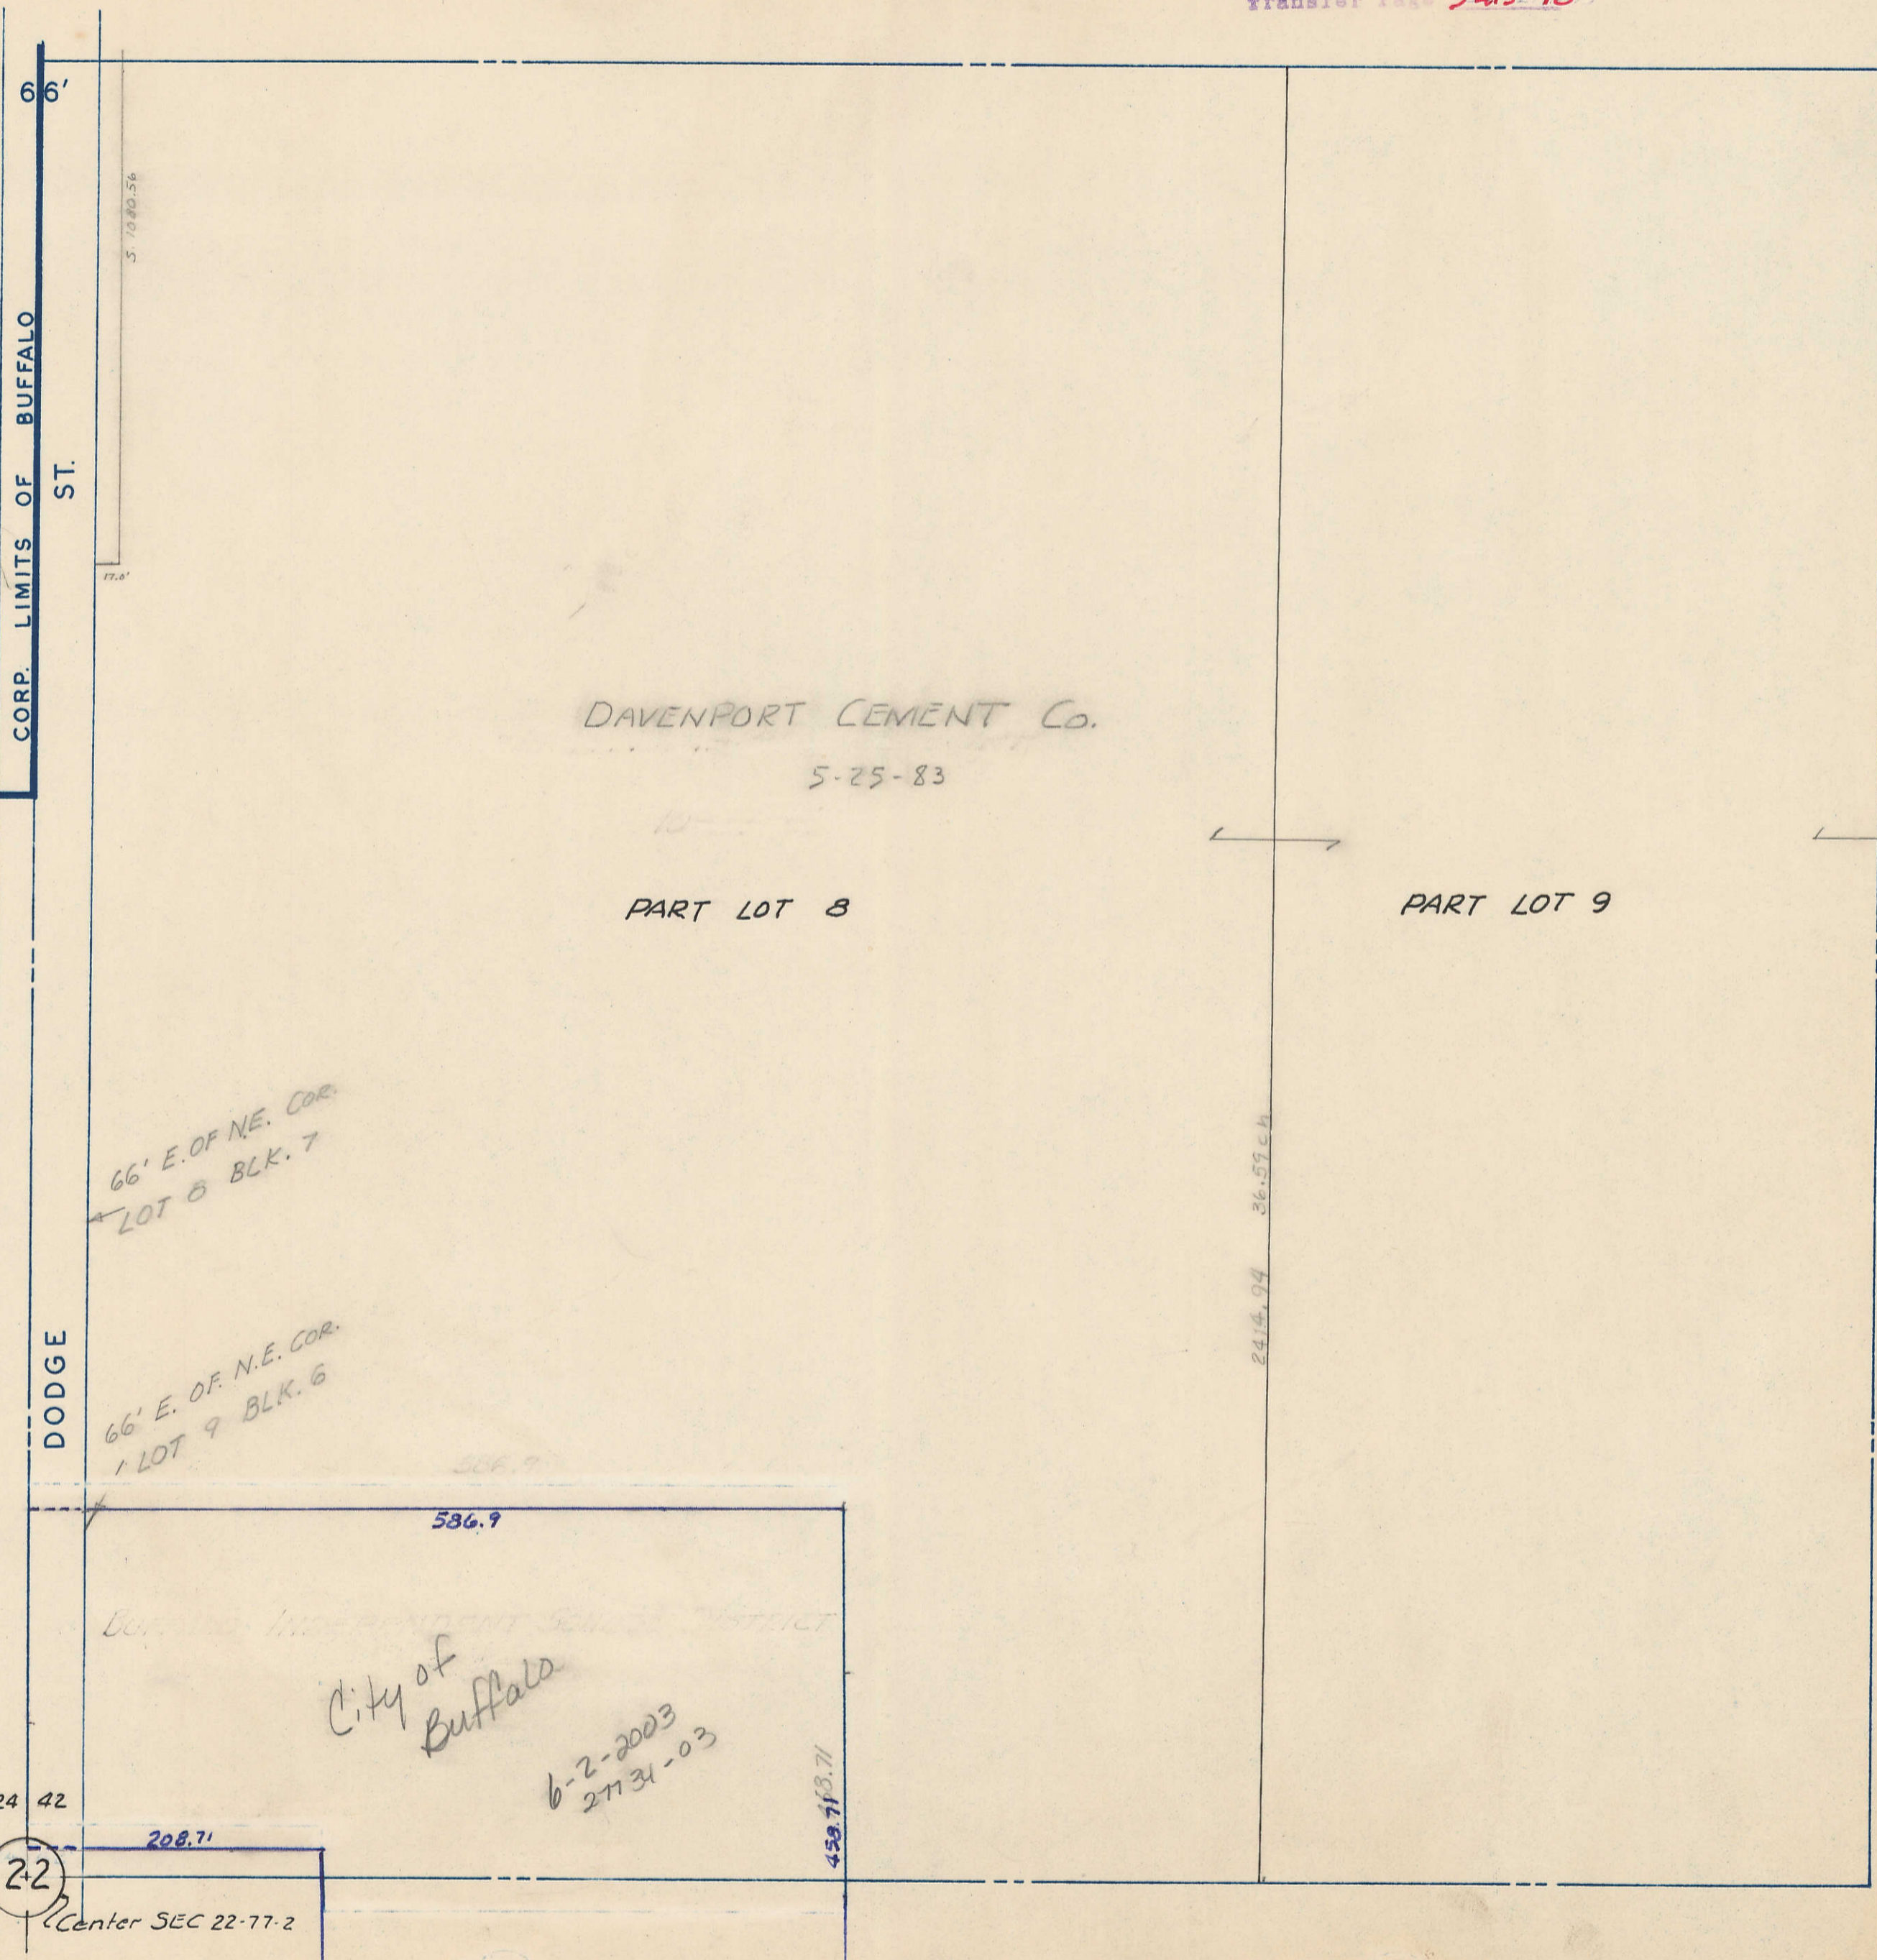


5

Transfer Page 543-90

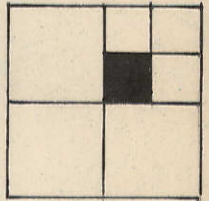

19

23

22

37

City of Buffalo
6-2-2003
27131-03