


SEC. 12-80-1

55

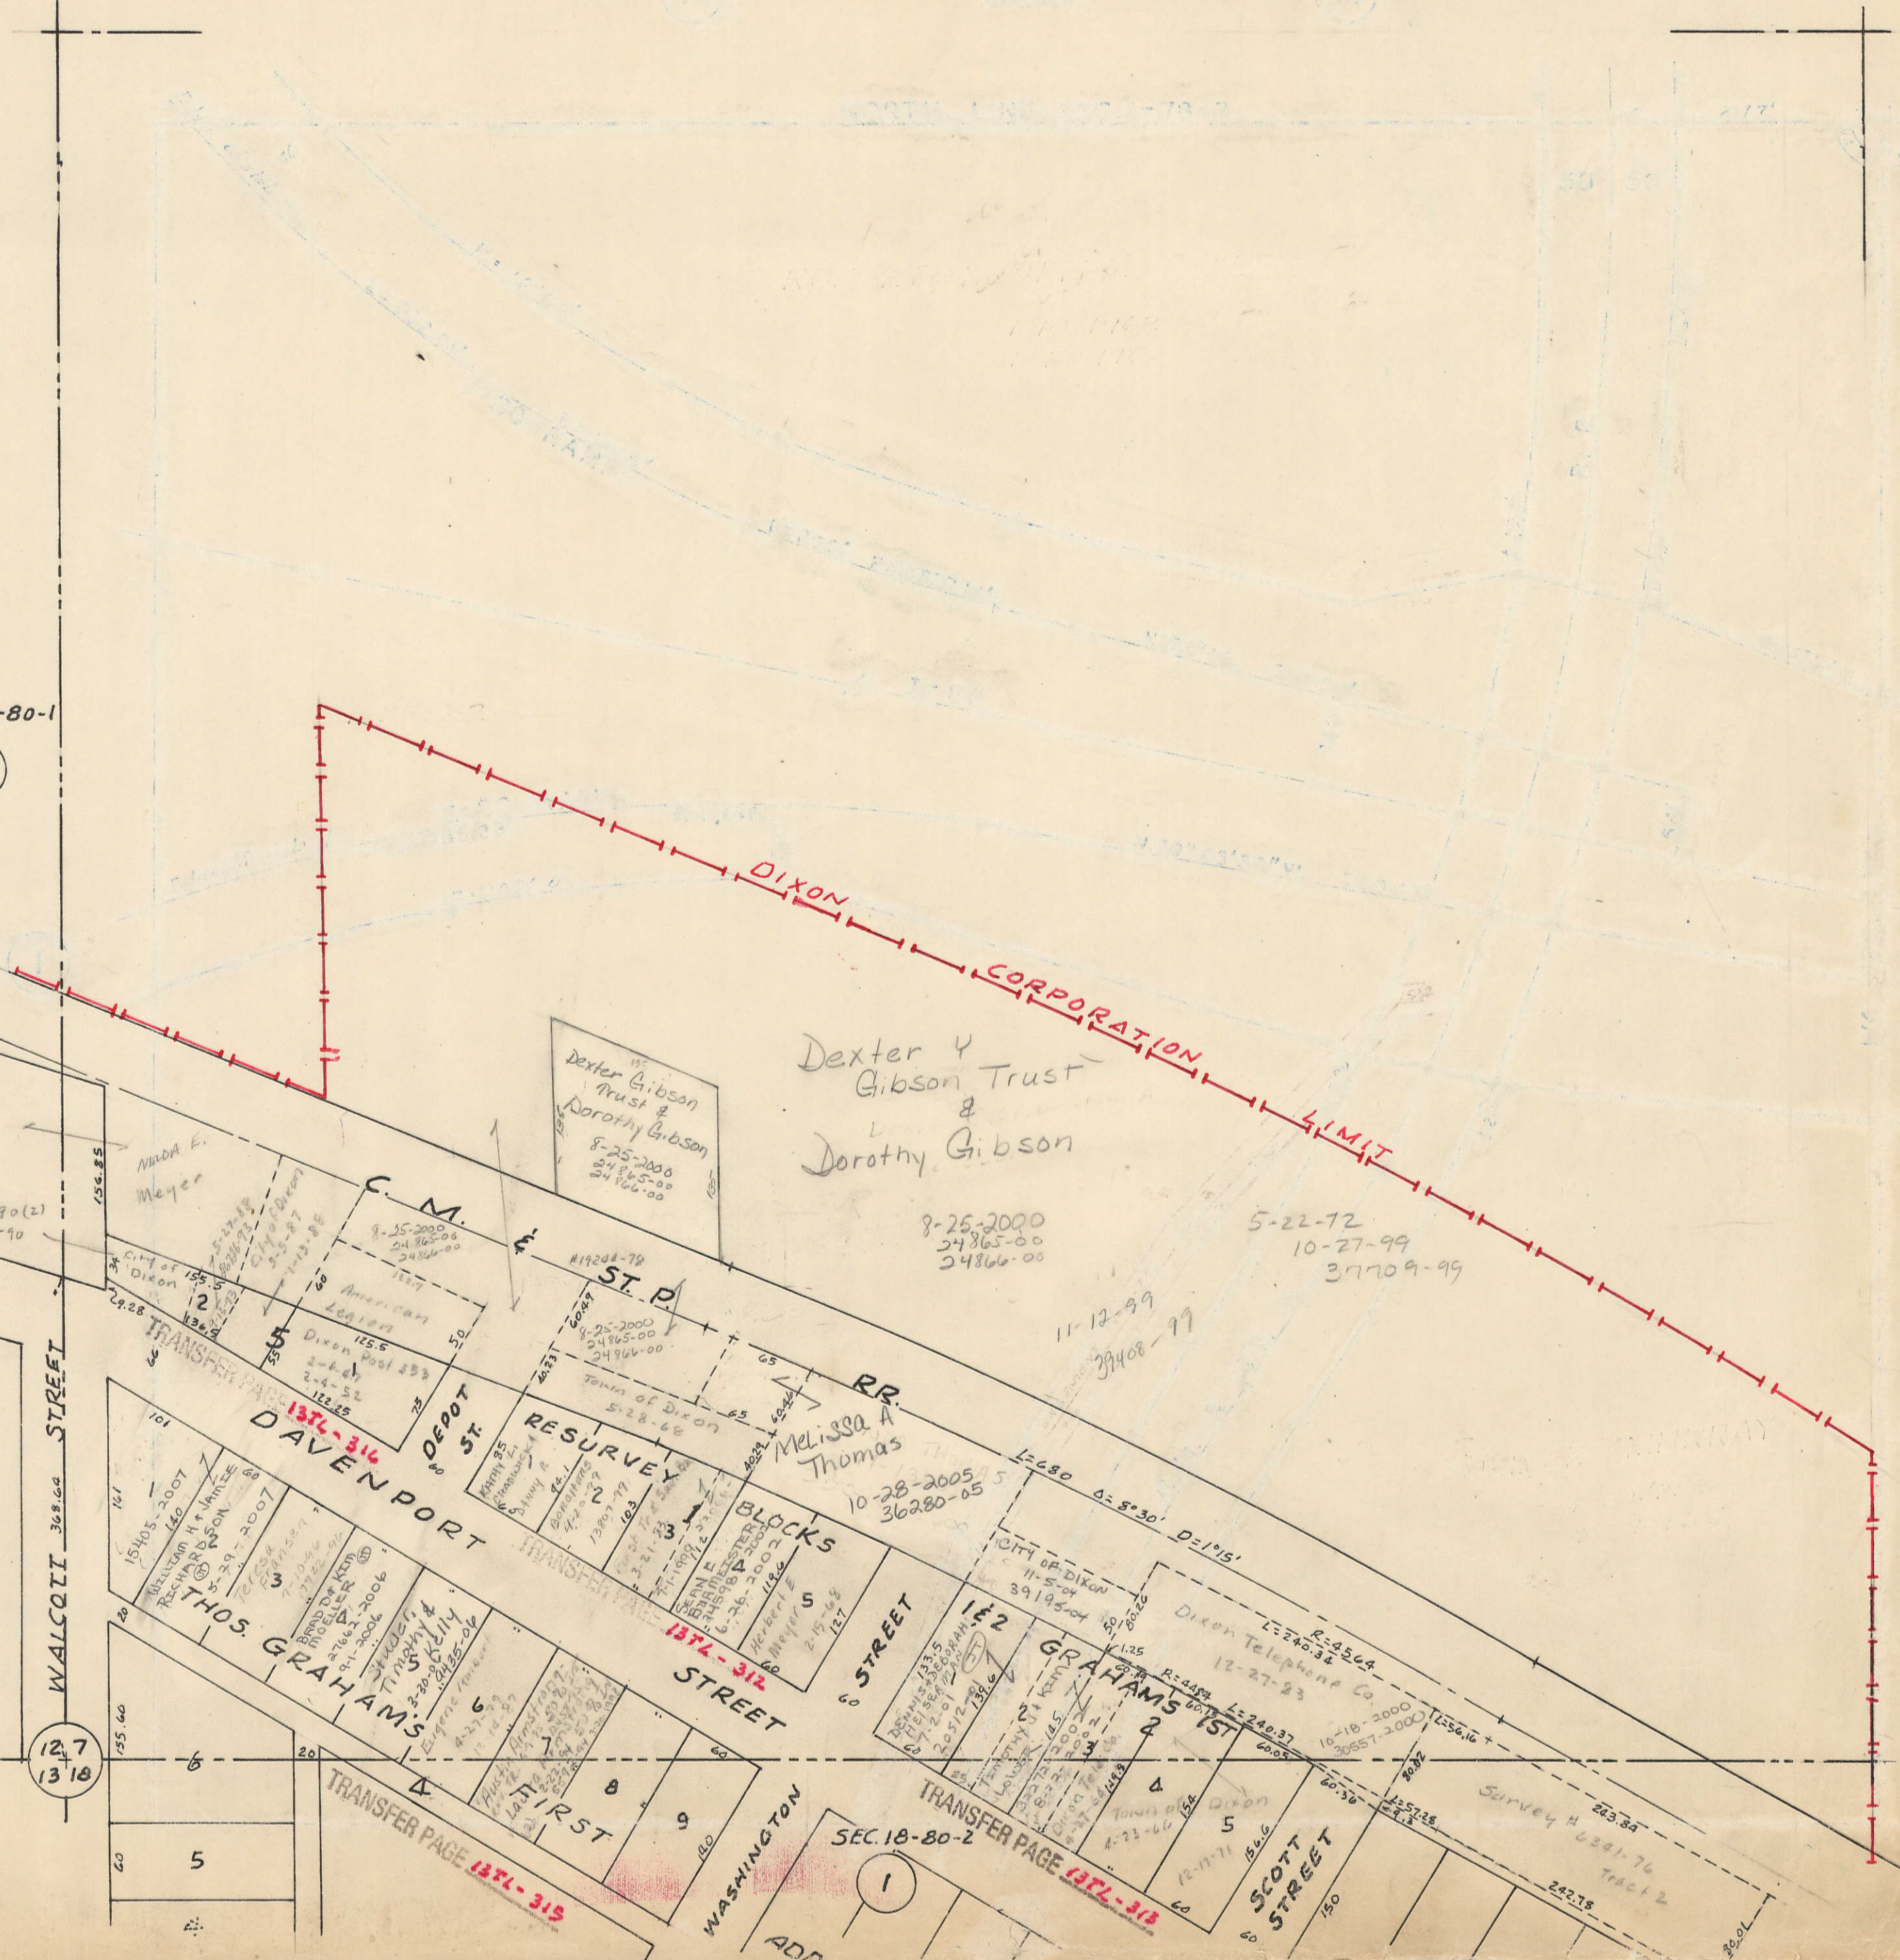

WALCOI STREET 368.64

12.7
13.18

TRANSFER PAGE 1376-315

SEC. 18-80-2


Dexter Gibson Trust & Dorothy Gibson
8-25-2000
24,865-00
24,866-00

Melissa A. Thomas
10-28-2005
36,280-05




TRANSFER PAGE 1376-315

5-22-72
10-27-99
37,709-99

11-12-99
39,408-99

8-25-2000
24,865-00
24,866-00

7-3-90(2)
H 12,171-90


THOS. GRAHAM'S

RESURVEY

STREET

STREET

GRAHAM'S

DIXON TELEPHONE CO.

SCOTT STREET

WASHINGTON STREET

ADD



