
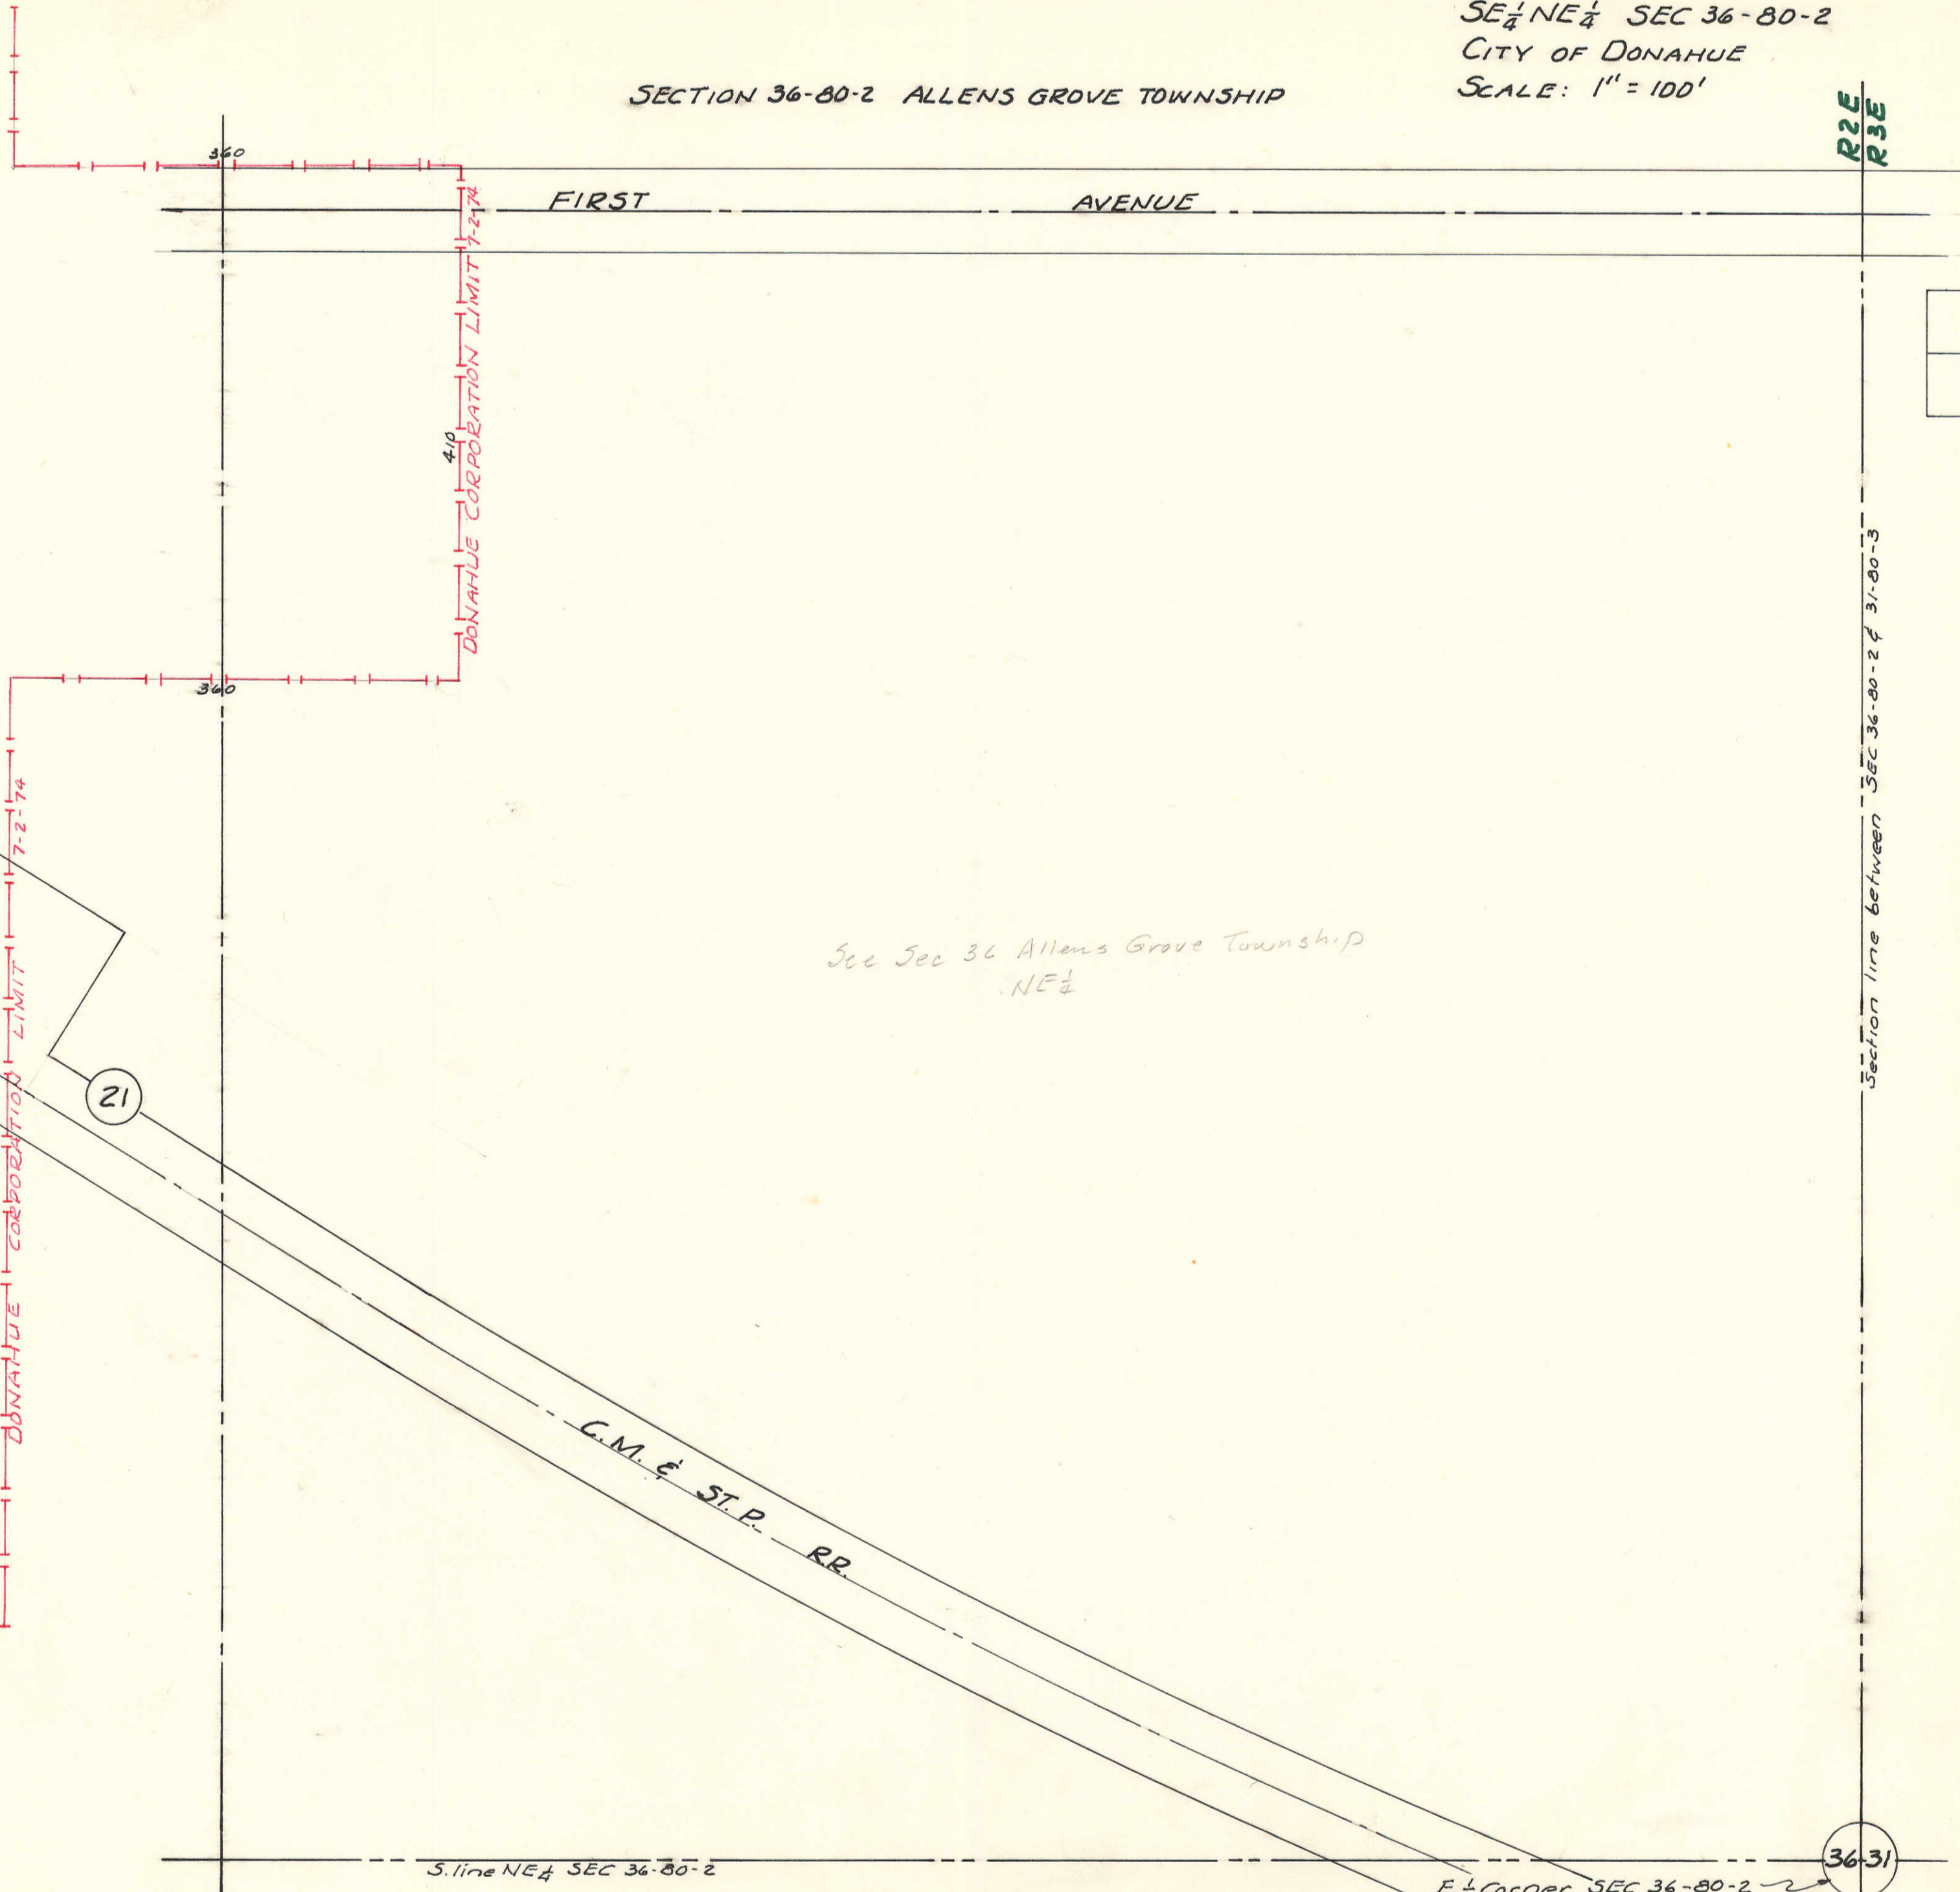


SE 1/4 NE 1/4 SEC 36-80-2
CITY OF DONAHUE
SCALE: 1" = 100'

SECTION 36-80-2 ALLENS GROVE TOWNSHIP

R2E
R3E

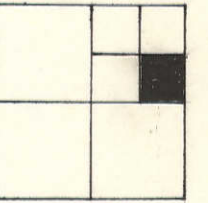

See Sec 36 Allens Grove Township
NE 1/4

Section line between SEC 36-80-2 & 31-80-3

SECTION-31-80-3 WINFIELD TOWNSHIP

SECTION 36-80-2 ALLENS GROVE TOWNSHIP

R2E
R3E

S. line NE 1/4 SEC 36-80-2

E 1/4 Corner SEC 36-80-2

36-31