


SECTION 25-80-2 ALLENS GROVE TOWNSHIP

SECTION 25-80-2 ALLENS GROVE TOWNSHIP

SECTION 25-80-2 ALLENS GROVE TOWNSHIP

See SEC 25 Allens Grove Township SW 1/4

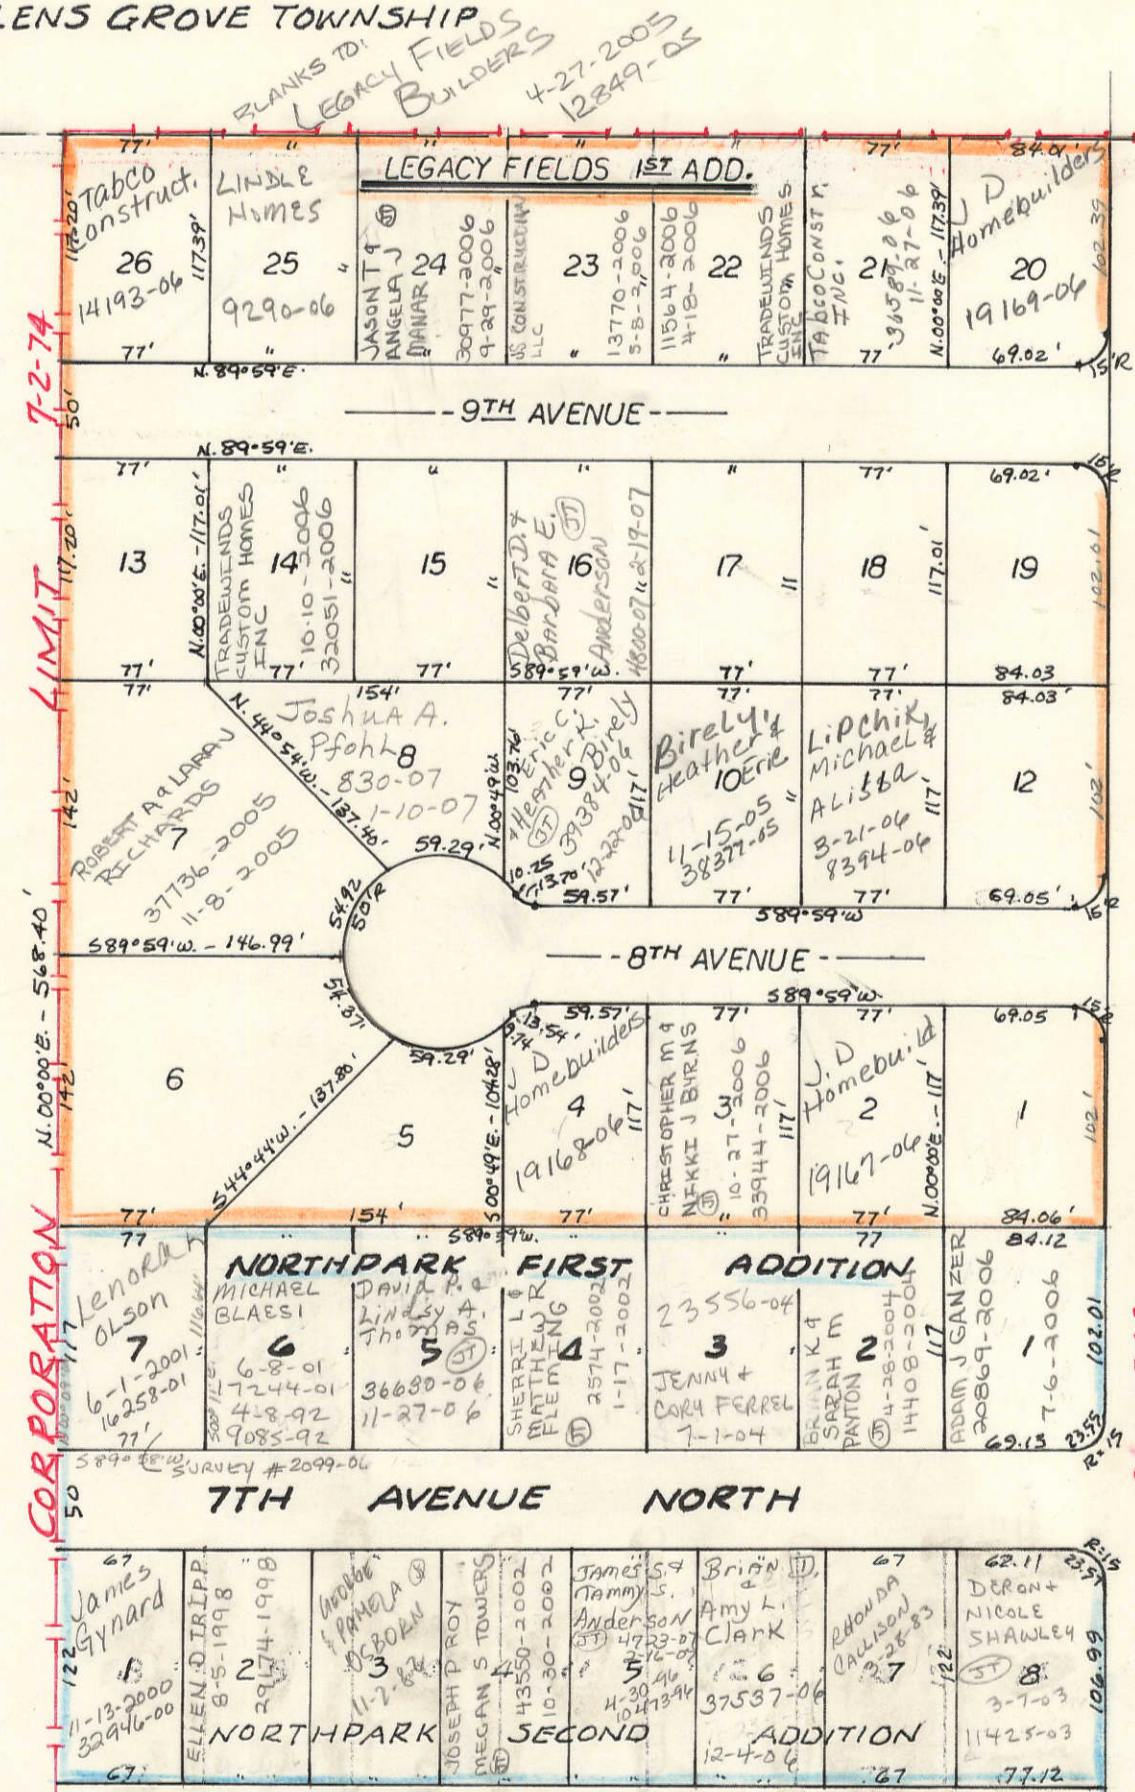

DONAHUE CORPORATION LIMIT

LEGACY FIELDS 1ST ADD.

STREET (Y52)

TRANSFER PAGE 2072-1742

N. MAIN E. line SW 1/4 SEC 25-80-2

SECTION 36-80-2 ALLENS GROVE TOWNSHIP

SEC 36 1/4 Corner SEC 25-80-2

3