


17

2324

SW 1/4 Corner SEC 24-79-3

346

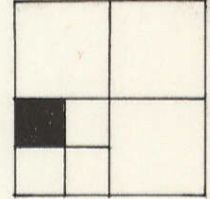

SEC 23


39

Section line between SECS 23 & 24

HIGHWAY 561

35

A & G Holdings  
6-17-2005  
19293-05  
19294-05

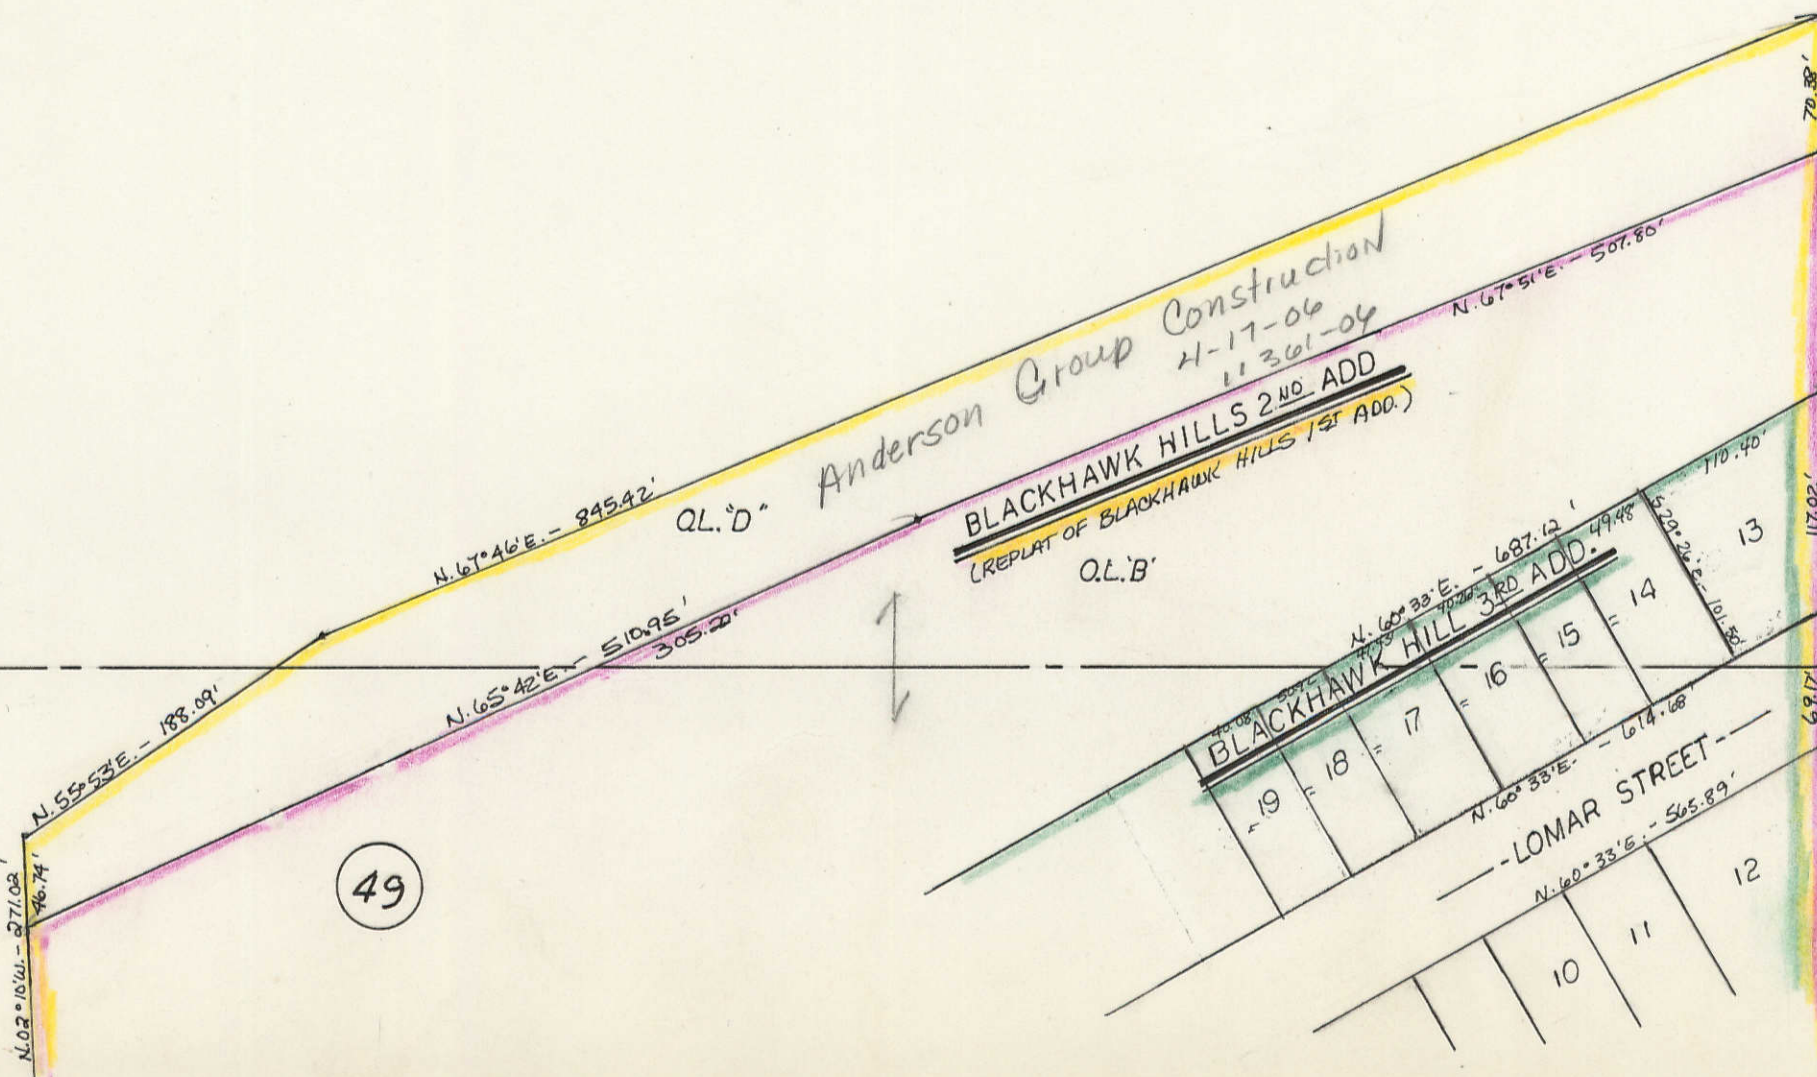

49

Blanks to:  
Anderson Group  
Construction  
4-17-06  
HI361-00