


7

SE 1/4 NE 1/4 SEC 28-79-3
CITY OF ELDRIDGE
SCALE: 1" = 100'

23

TRANSFER PAGE 8405 452

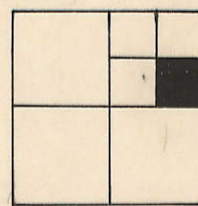

Section line between SECS 27 & 28

Roy B. Keppy & WF


3-4-53

3-31-53

SEC 27

17

21

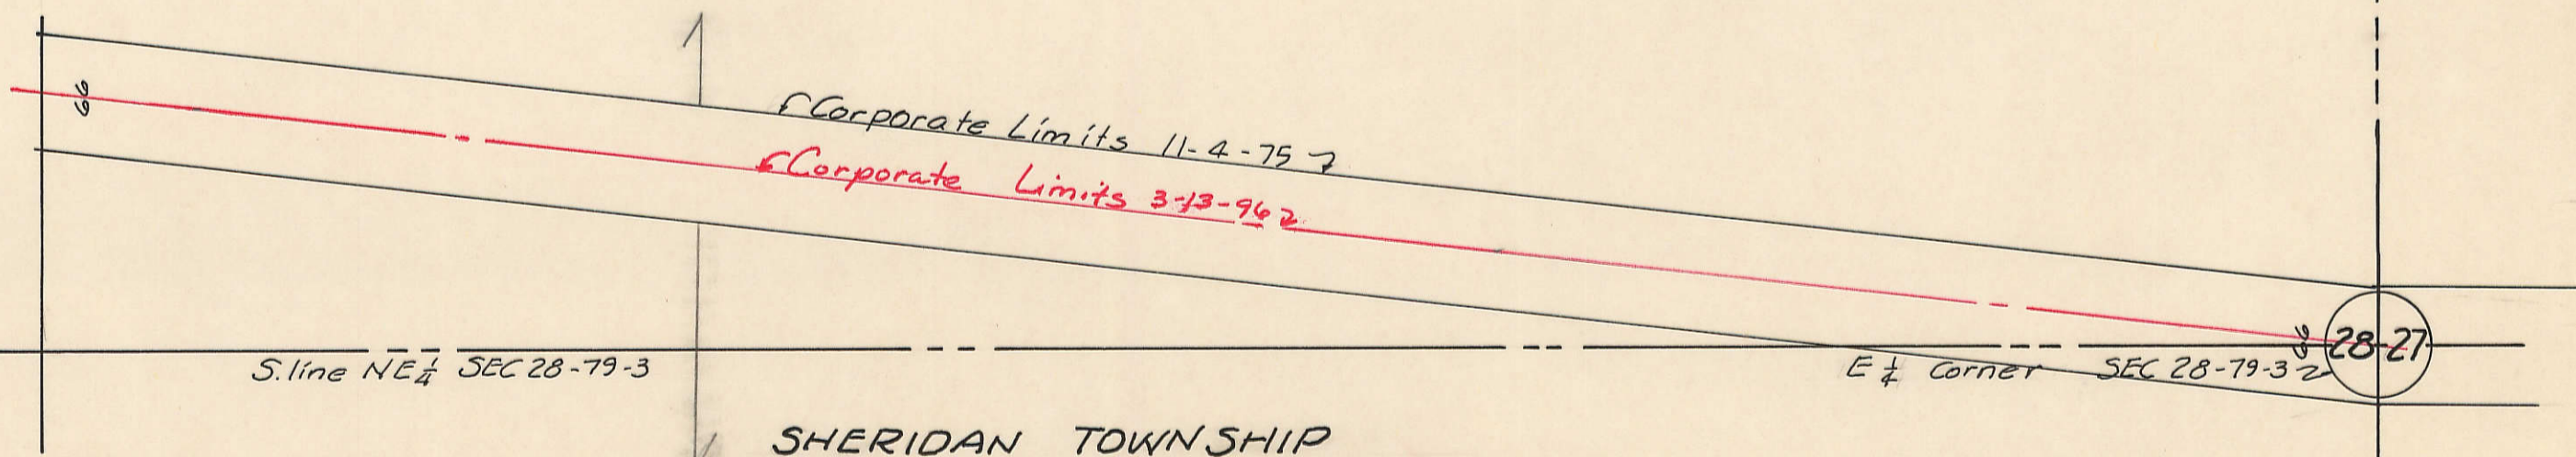

S. line NE 1/4 SEC 28-79-3

SHERIDAN TOWNSHIP

E 1/4 corner SEC 28-79-3

28-27