



SHERIDAN TOWNSHIP

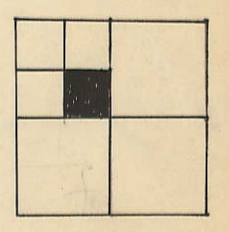

SHERIDAN TOWNSHIP

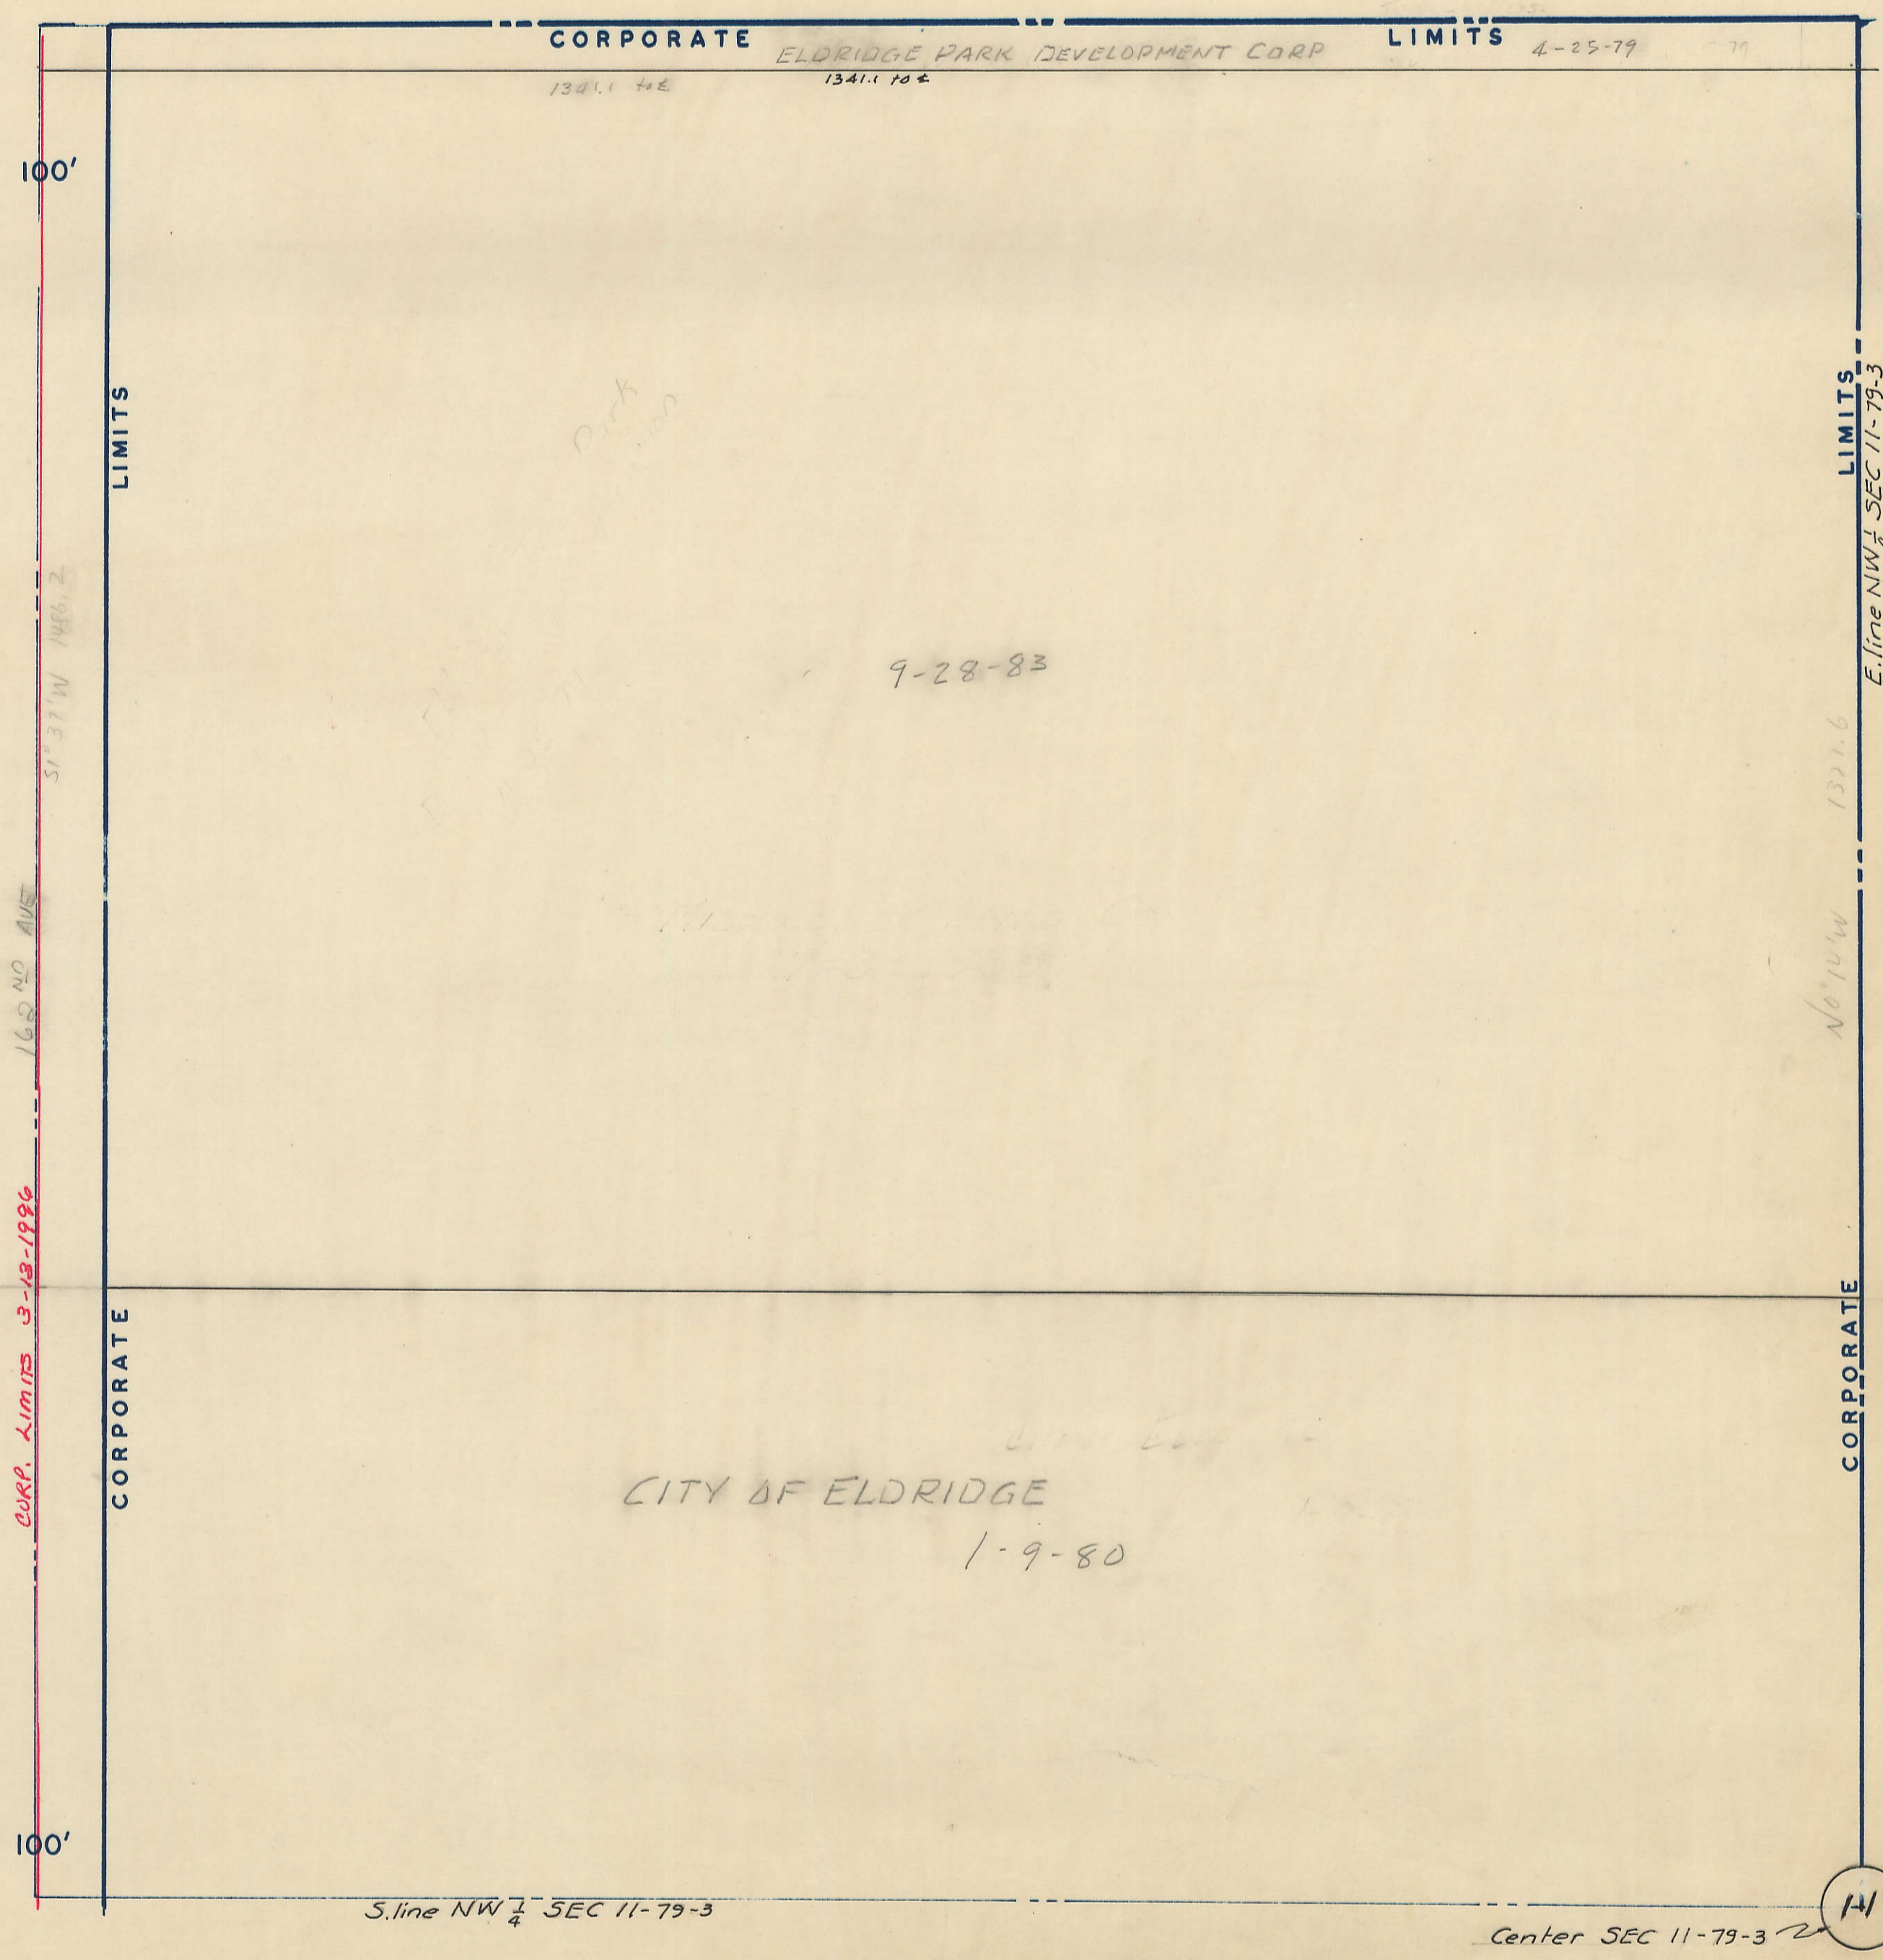

LIMITS
E. line NW 1/4 SEC 11-79-3

No. 14 W 1321.6

CORPORATE

141

SHERIDAN TOWNSHIP