


3

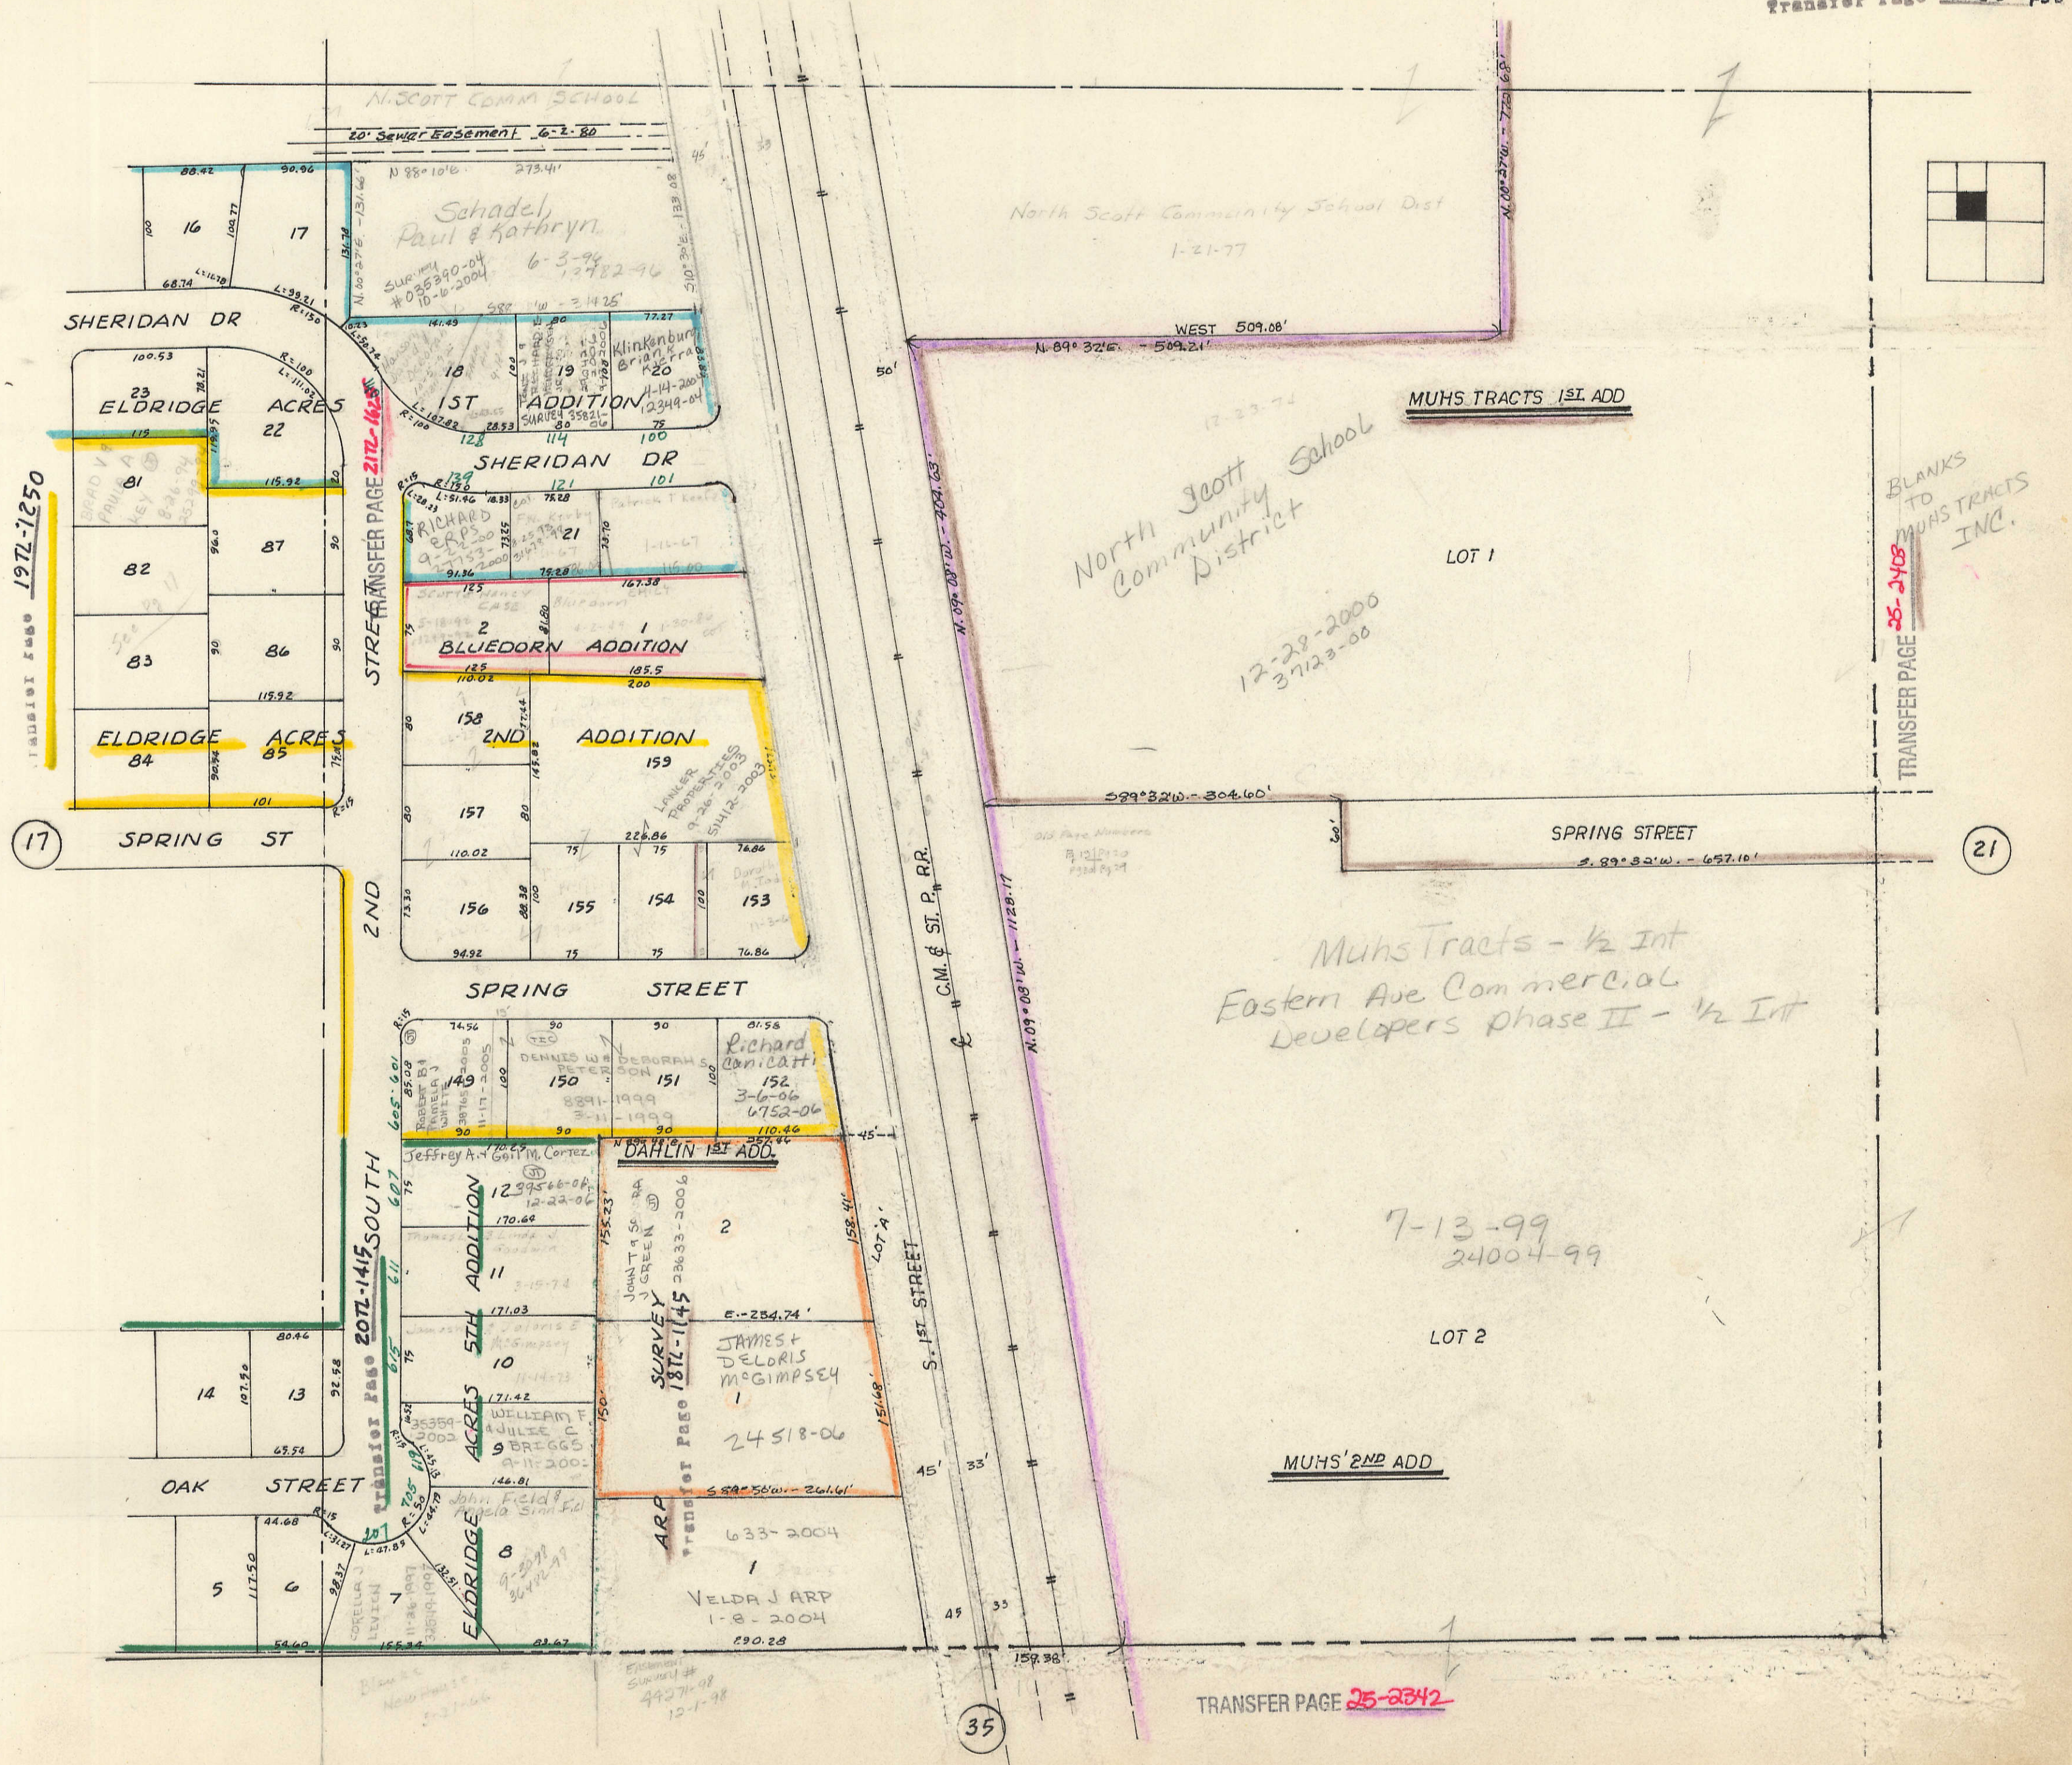

TRANSFER PAGE 1972-1250

BLANKS TO MUEHLS TRACTS INC.
TRANSFER PAGE 25-2408

17

21

35

TRANSFER PAGE 25-2342