
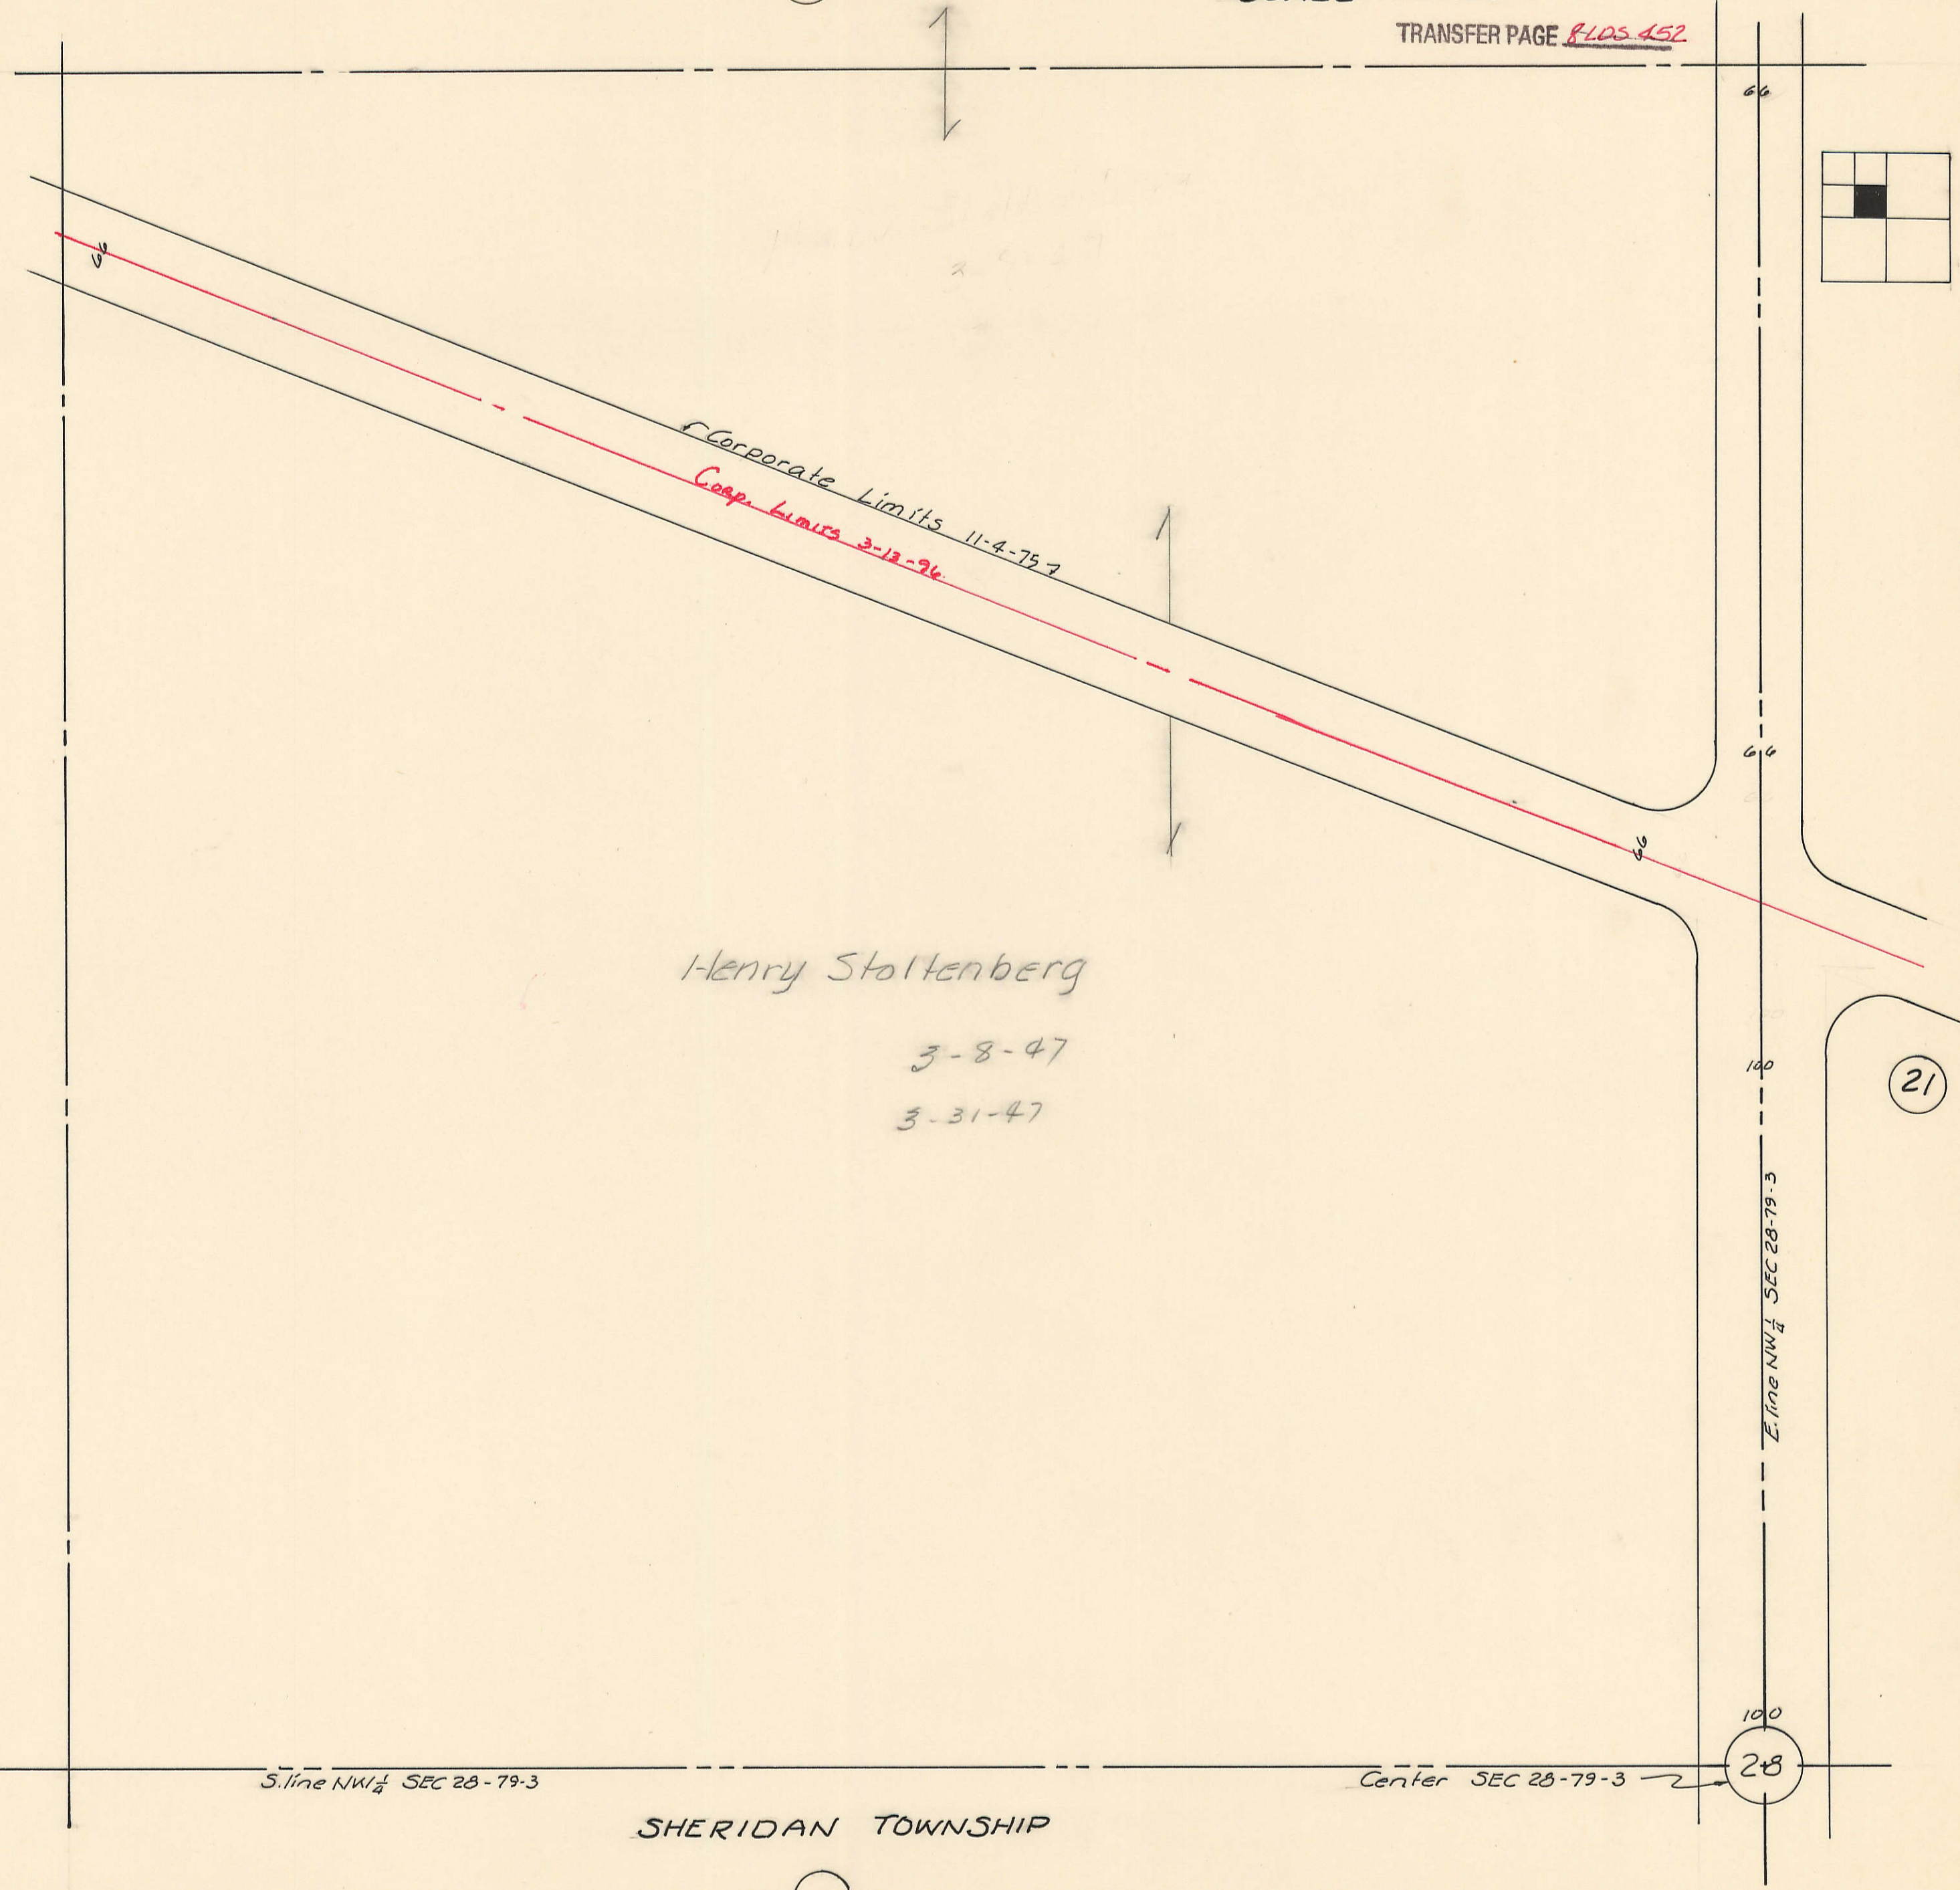


SE 1/4 NW 1/4 SEC 28-79-3
CITY OF ELDRIDGE
SCALE: 1" = 100'

3

TRANSFER PAGE PLDS 452

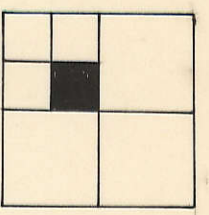

SHERIDAN TOWNSHIP

Henry Stoltenberg
3-8-47
3-31-47

S. line NW 1/4 SEC 28-79-3

Center SEC 28-79-3

E. line NW 1/4 SEC 28-79-3

SHERIDAN TOWNSHIP

21

28