


39

53

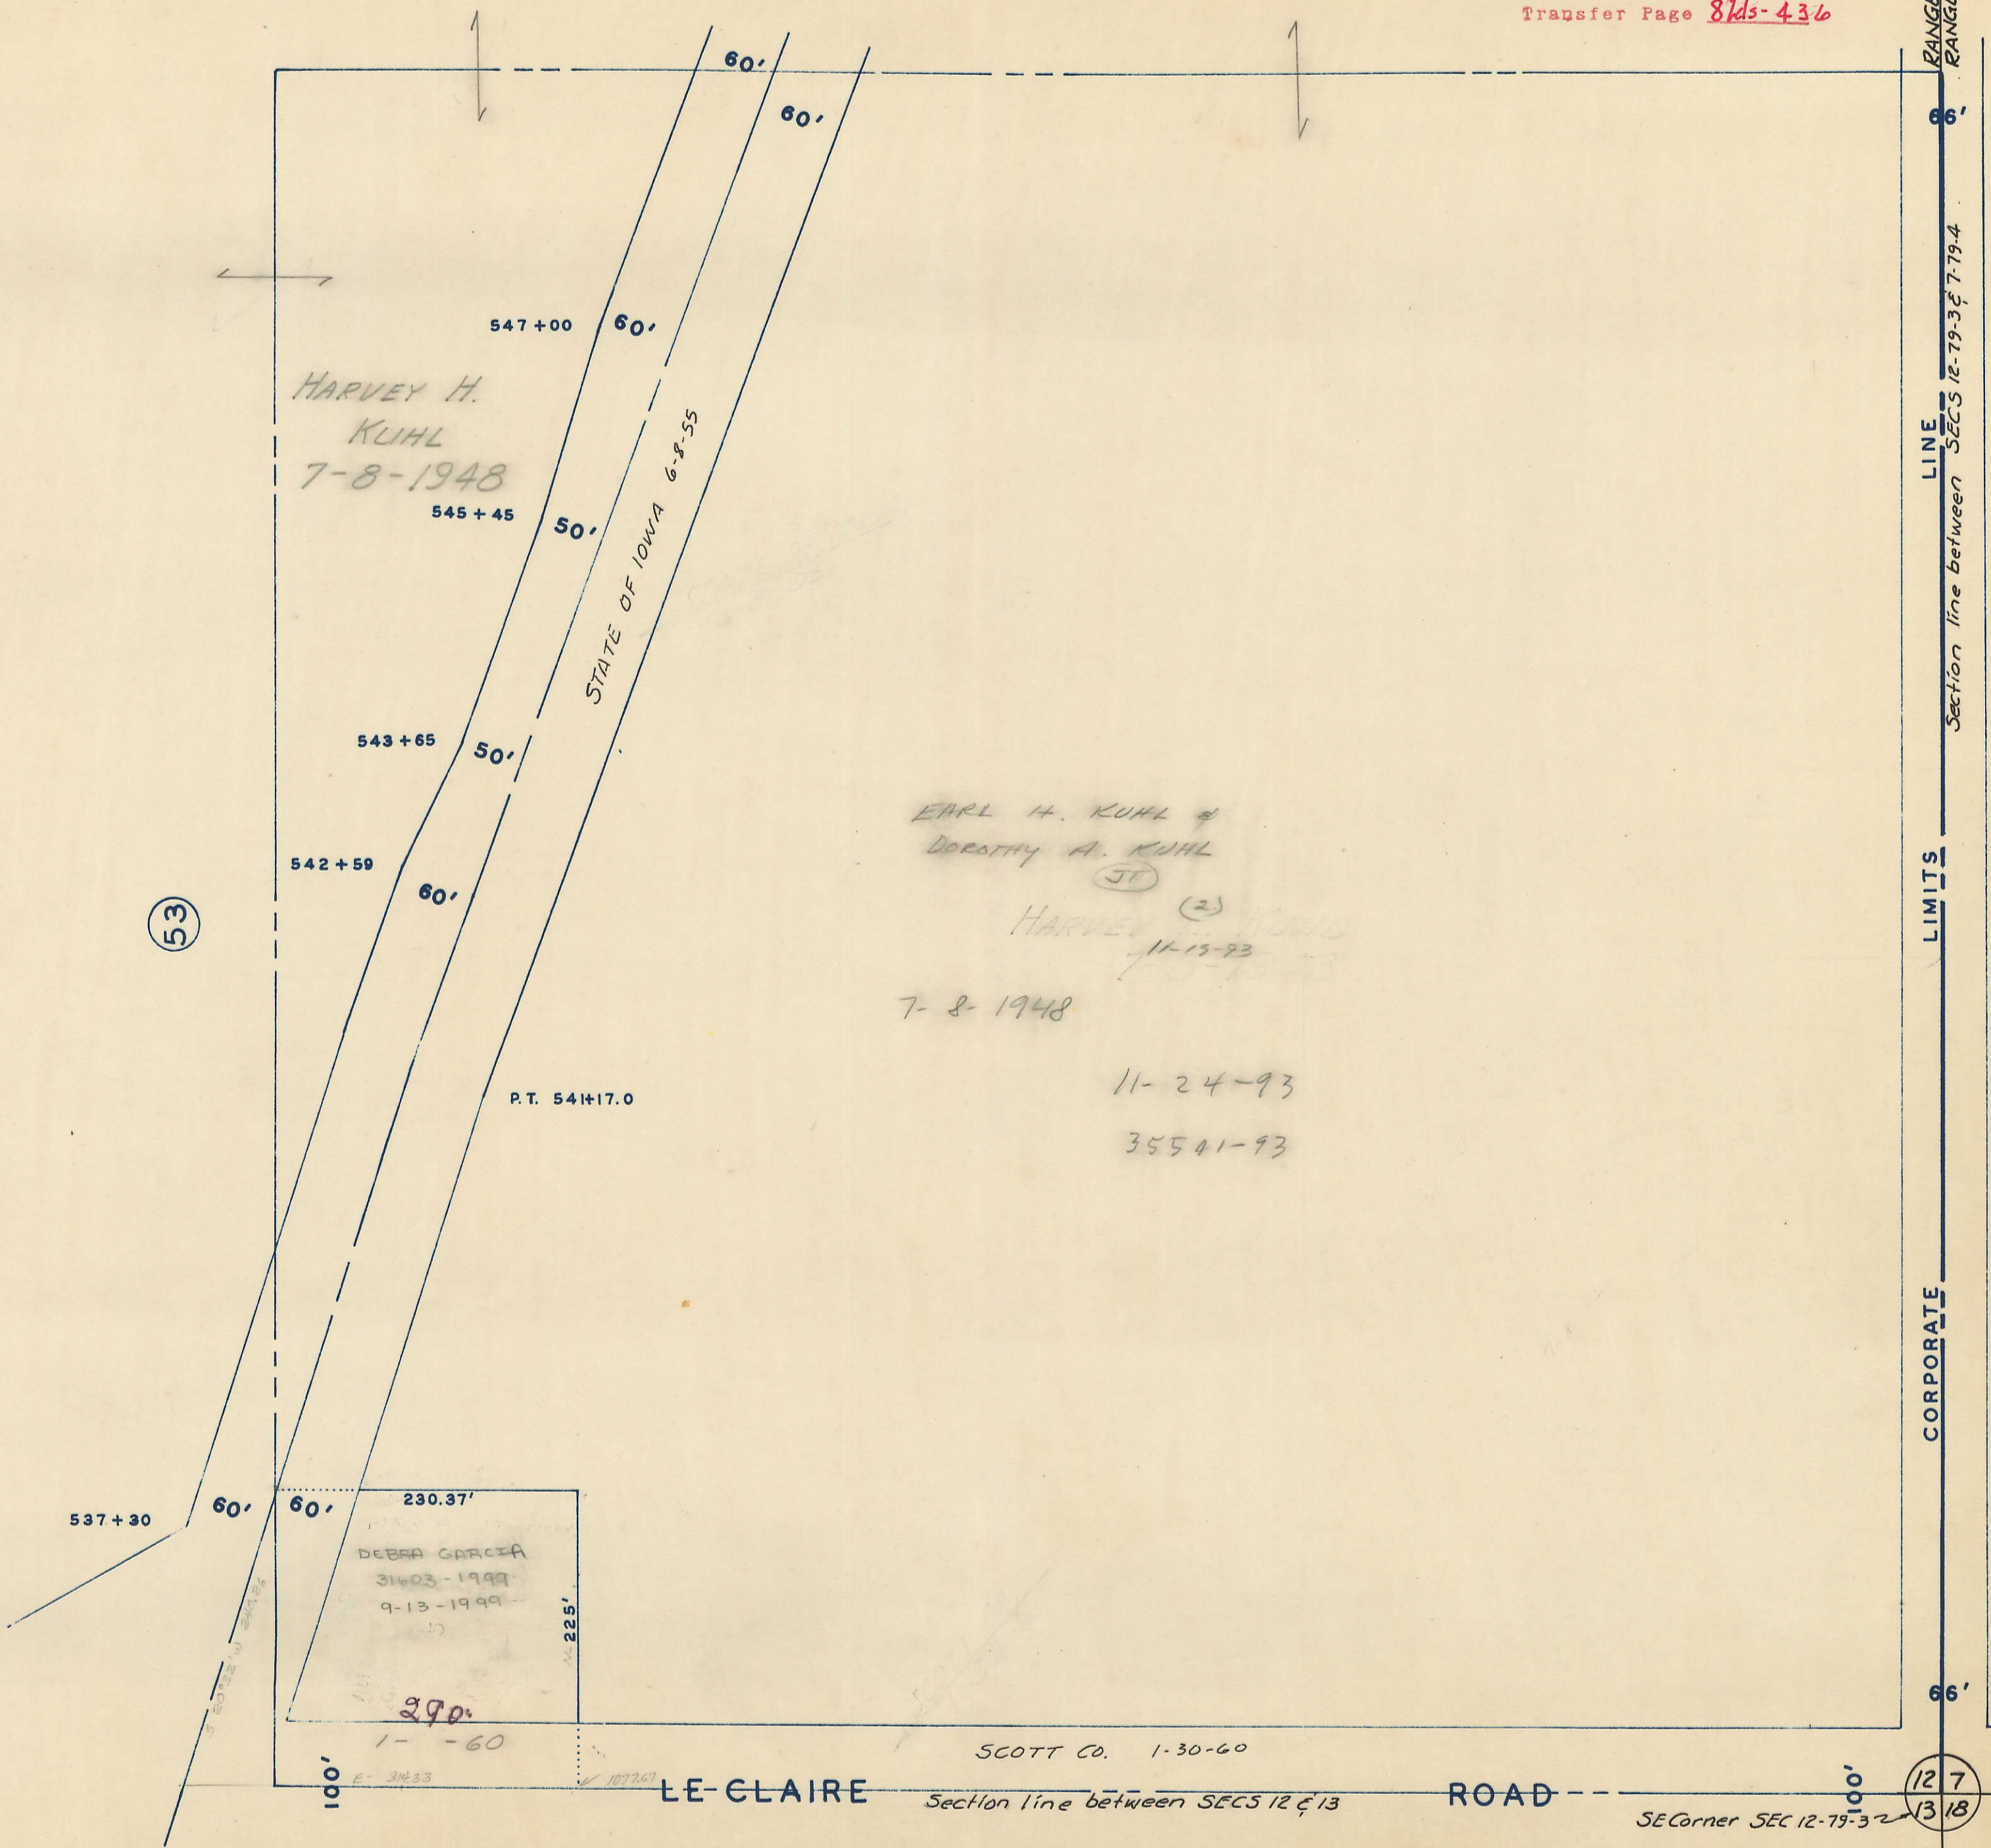

HARVEY H. KUHLE
7-8-1948

EARL H. KUHLE &
DOROTHY A. KUHLE
51
HARVEY (2)
11-13-93
7-8-1948

11-24-93
35541-93

DEBRA GARCIA
31603-1999
9-13-1999

290
1--60

LE-CLAIRE

SCOTT CO. 1-30-60

ROAD

Section line between SECS 12 & 13

SE Corner SEC 12-79-32

7-SEC. 13

RANGE 3 E
RANGE 4 E

66'

LINE
Section line between SECS 12-79-3 & 7-79-4

LIMITS

CORPORATE

66'

127
1318

RANGE 3 E
RANGE 4 E

LINCOLN TOWNSHIP
SECTION 7-79-4