

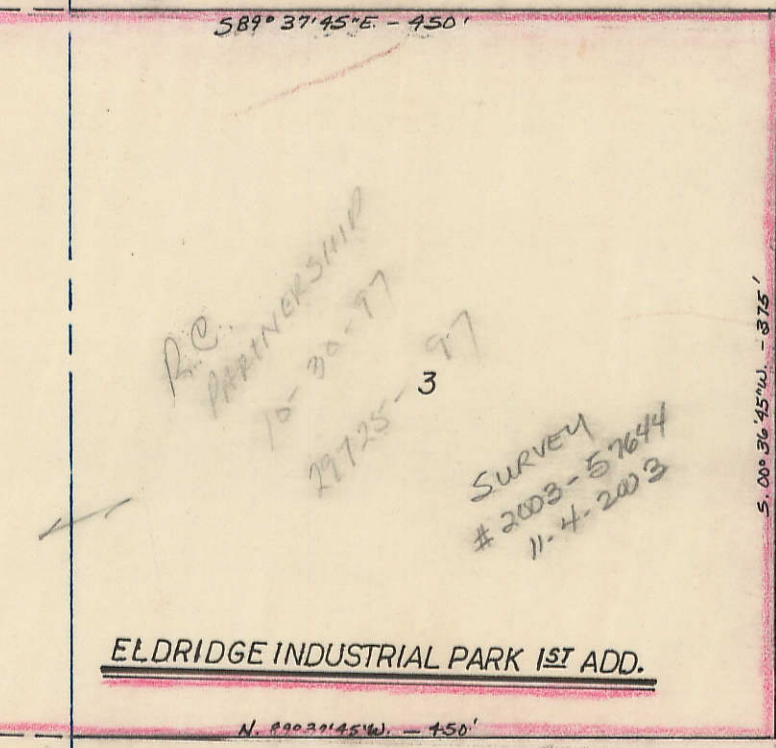


35

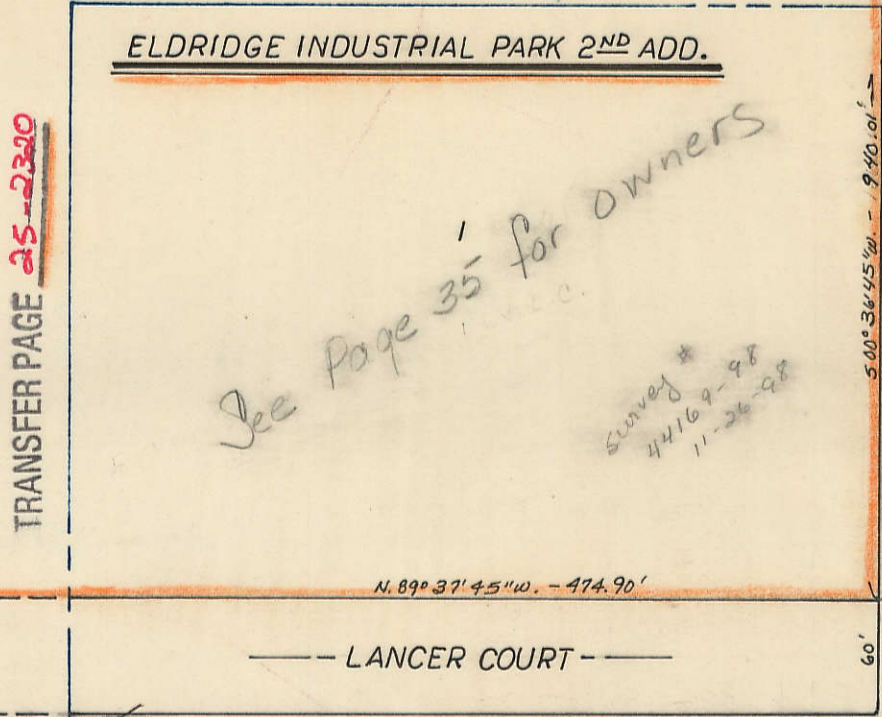

EDWIN A. KNICKREHN
 EDWARD H. CARROLL 2-14-79
 EUGENE A. POCHAU

8-22-66
 12-28-78 QCD
 2-11-79 QCD
 2-28-79 QCD

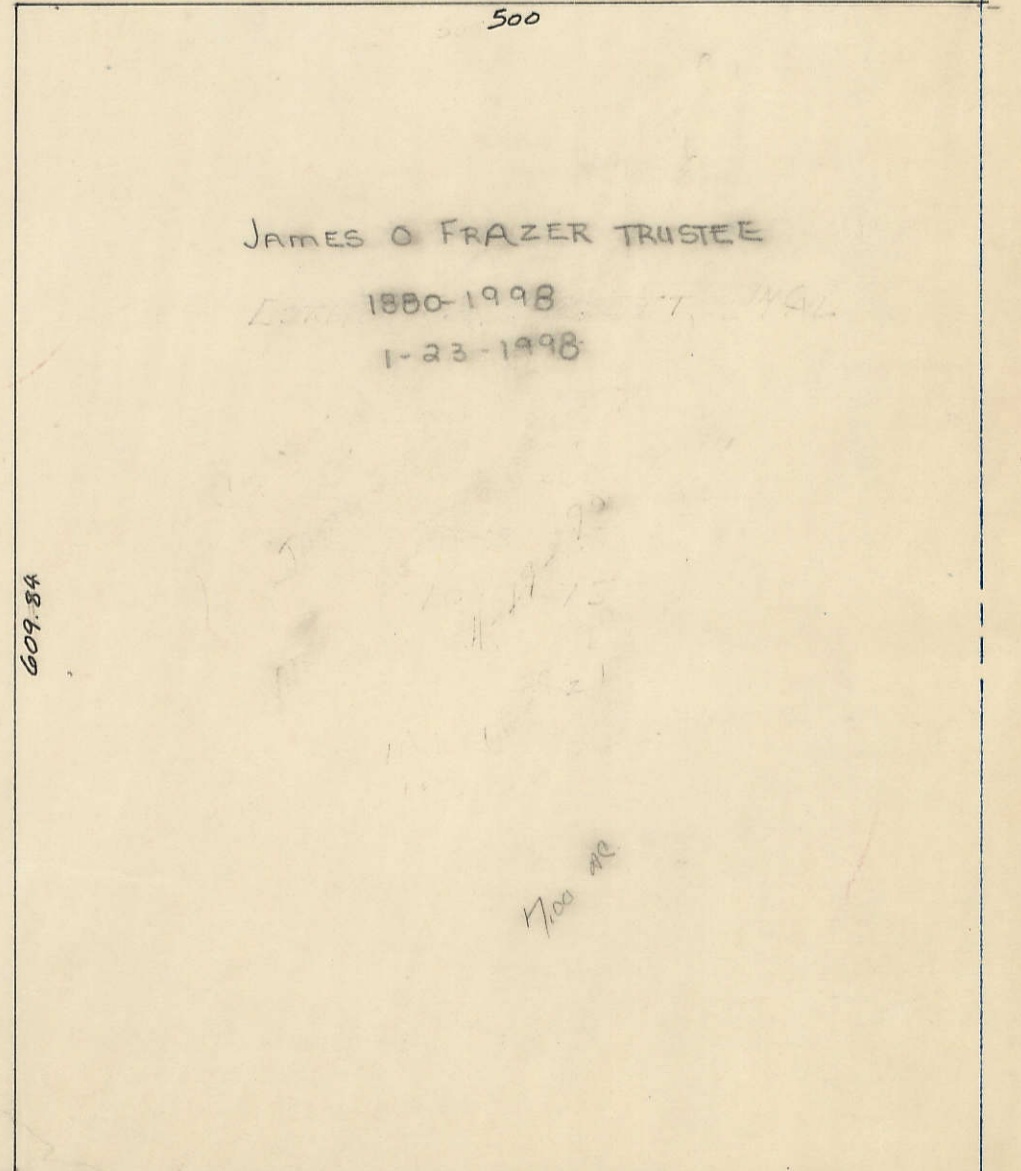

49

53

E. line SW 1/4 SEC 12-79-3

100'

STATE OF IOWA 9-20-38

Section line between SECS 12 & 13

S 1/4 Corner SEC 12-79-3

3- SEC. 13

12
13

