


N. line SW 1/4 NW 1/4 Sec 14-79-3

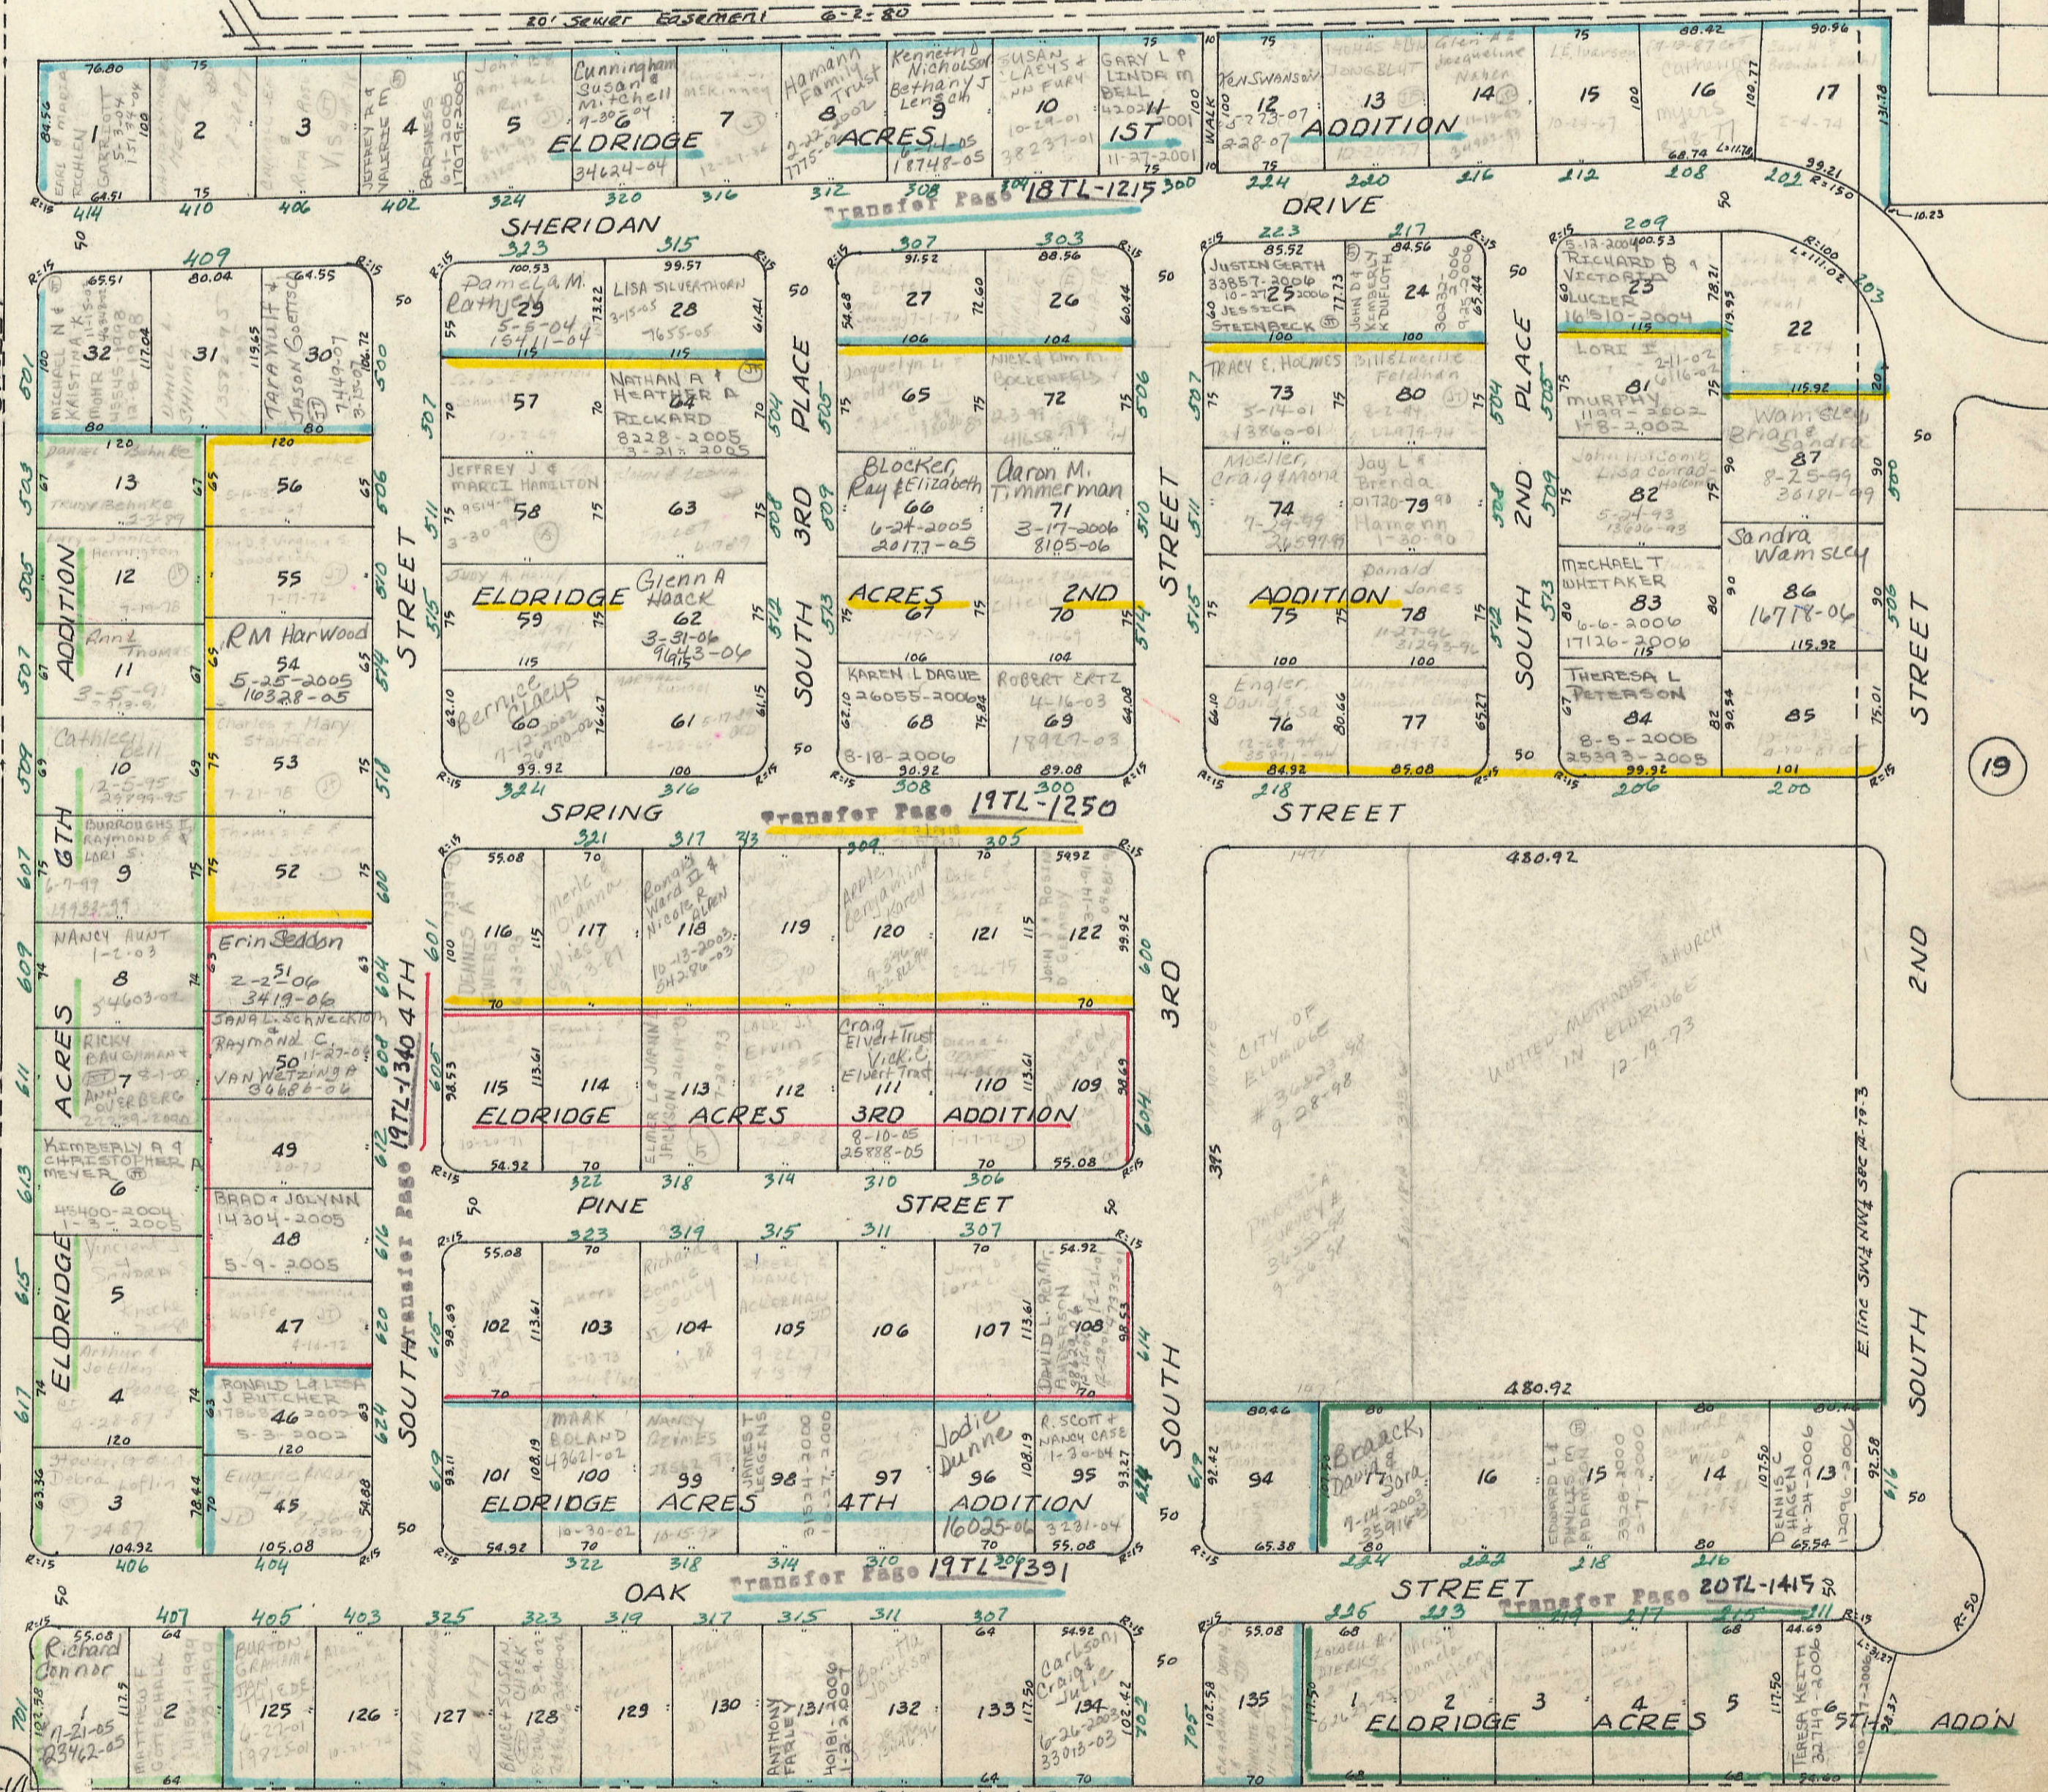

SEC 15

23

Transfer Page 20TL-1469

W. line Sec 14-79-3

S. line Sec 14-79-3

5TH STREET

6TH STREET

7TH STREET

8TH STREET

9TH STREET

10TH STREET

11TH STREET

12TH STREET

13TH STREET

1

19


33

15-14

SW 1/4 NW 1/4 Sec 14-79-3

S. line NW 1/4 Sec 14-79-3

L-W. 1/4 ner

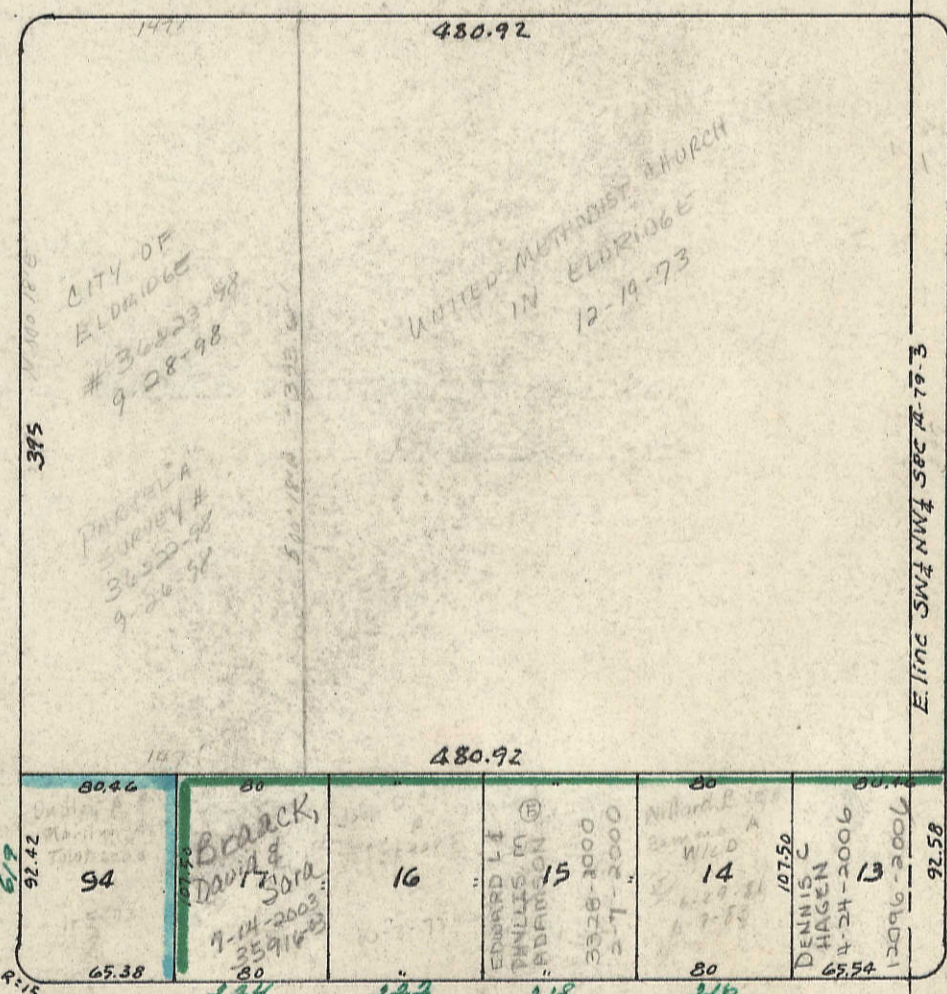

Transfer Page 20TL-1415

ELDRIDGE ACRES