


(37)

Transfer Page 8lds-447

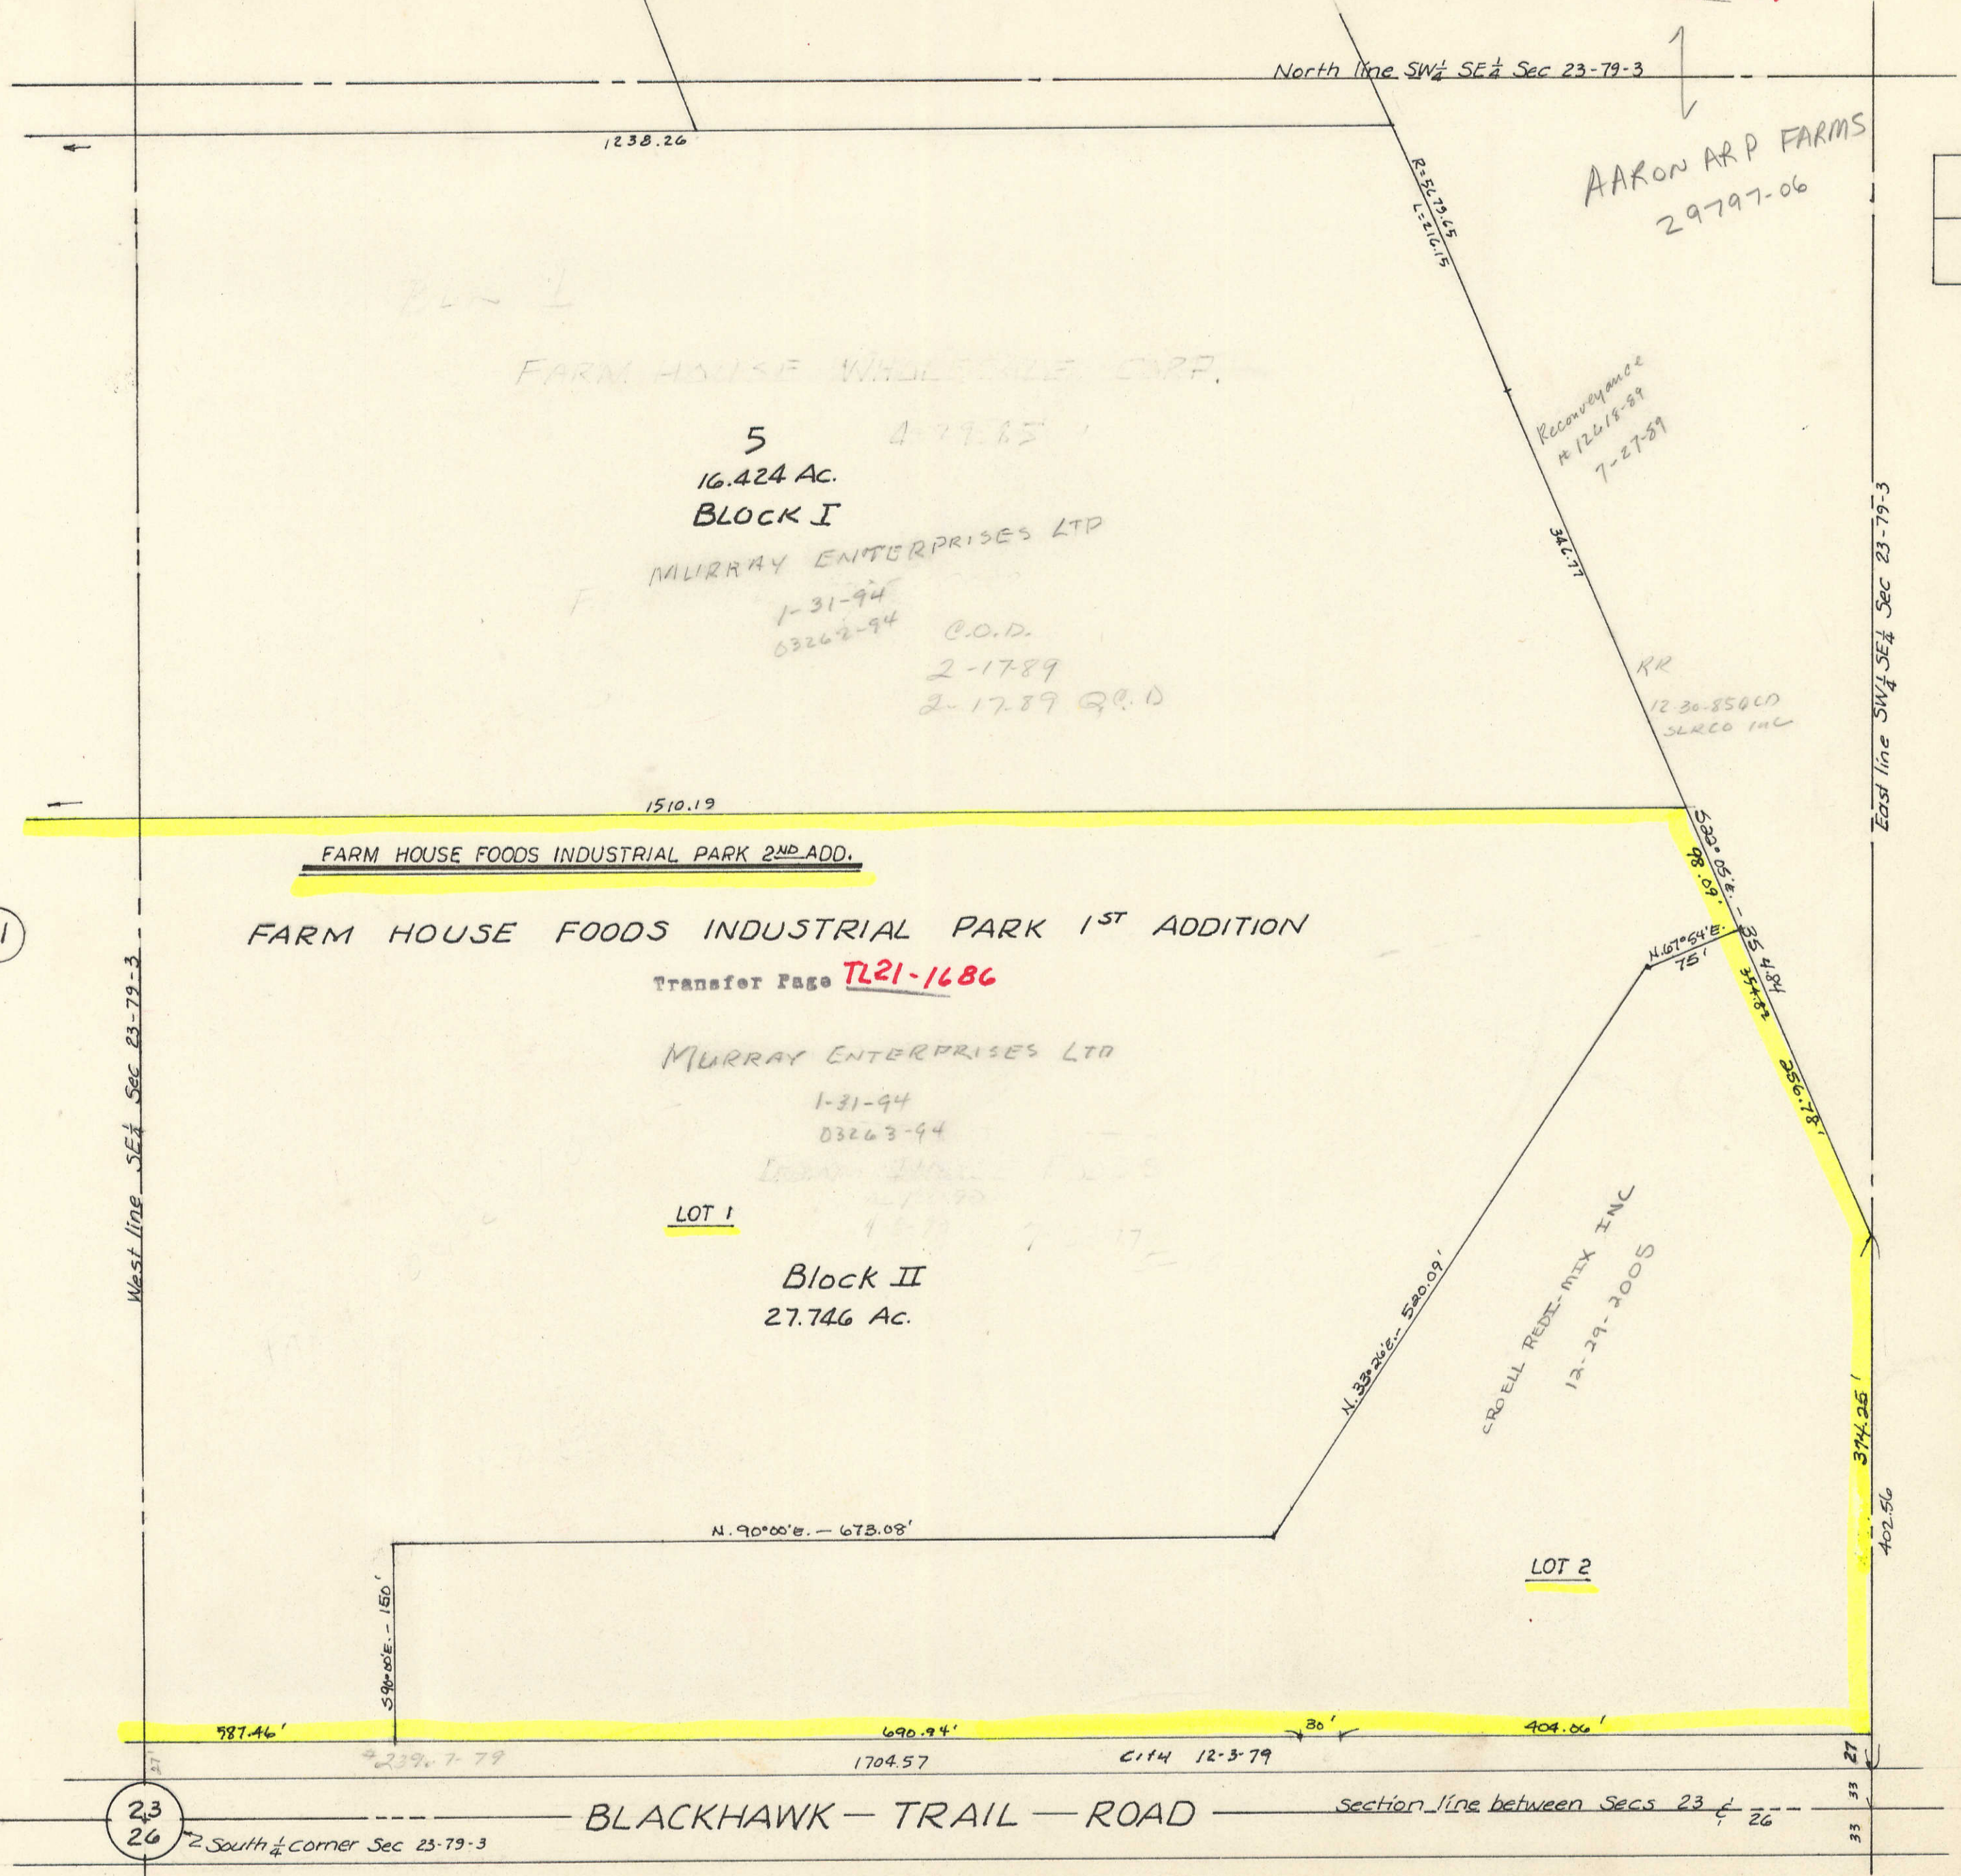

FARM HOUSE WHOLESALE CORP.
5 4-79-65
16.424 AC.
BLOCK I
MURRAY ENTERPRISES LTD
1-31-94
03262-94 C.O.D.
2-17-89
2-17-89 Q.O.D.

FARM HOUSE FOODS INDUSTRIAL PARK 2ND ADD.
FARM HOUSE FOODS INDUSTRIAL PARK 1ST ADDITION
Transfer Page TL21-1686

MURRAY ENTERPRISES LTD
1-31-94
03263-94
LOT 1
Block II
27.746 AC.

CROELL REDE-MIX INC
12-29-2005
LOT 2

AARON ARP FARMS
29797-06

BLACKHAWK - TRAIL - ROAD

(23)
(26)

South 1/4 Corner Sec 23-79-3

Transfer Page 21TL-1686

(5)

SEC 26