


LONG GROVE

NE 1/4, NW 1/4 SEC. 35-80-3

SCALE: 1"=100'

SEC. 26

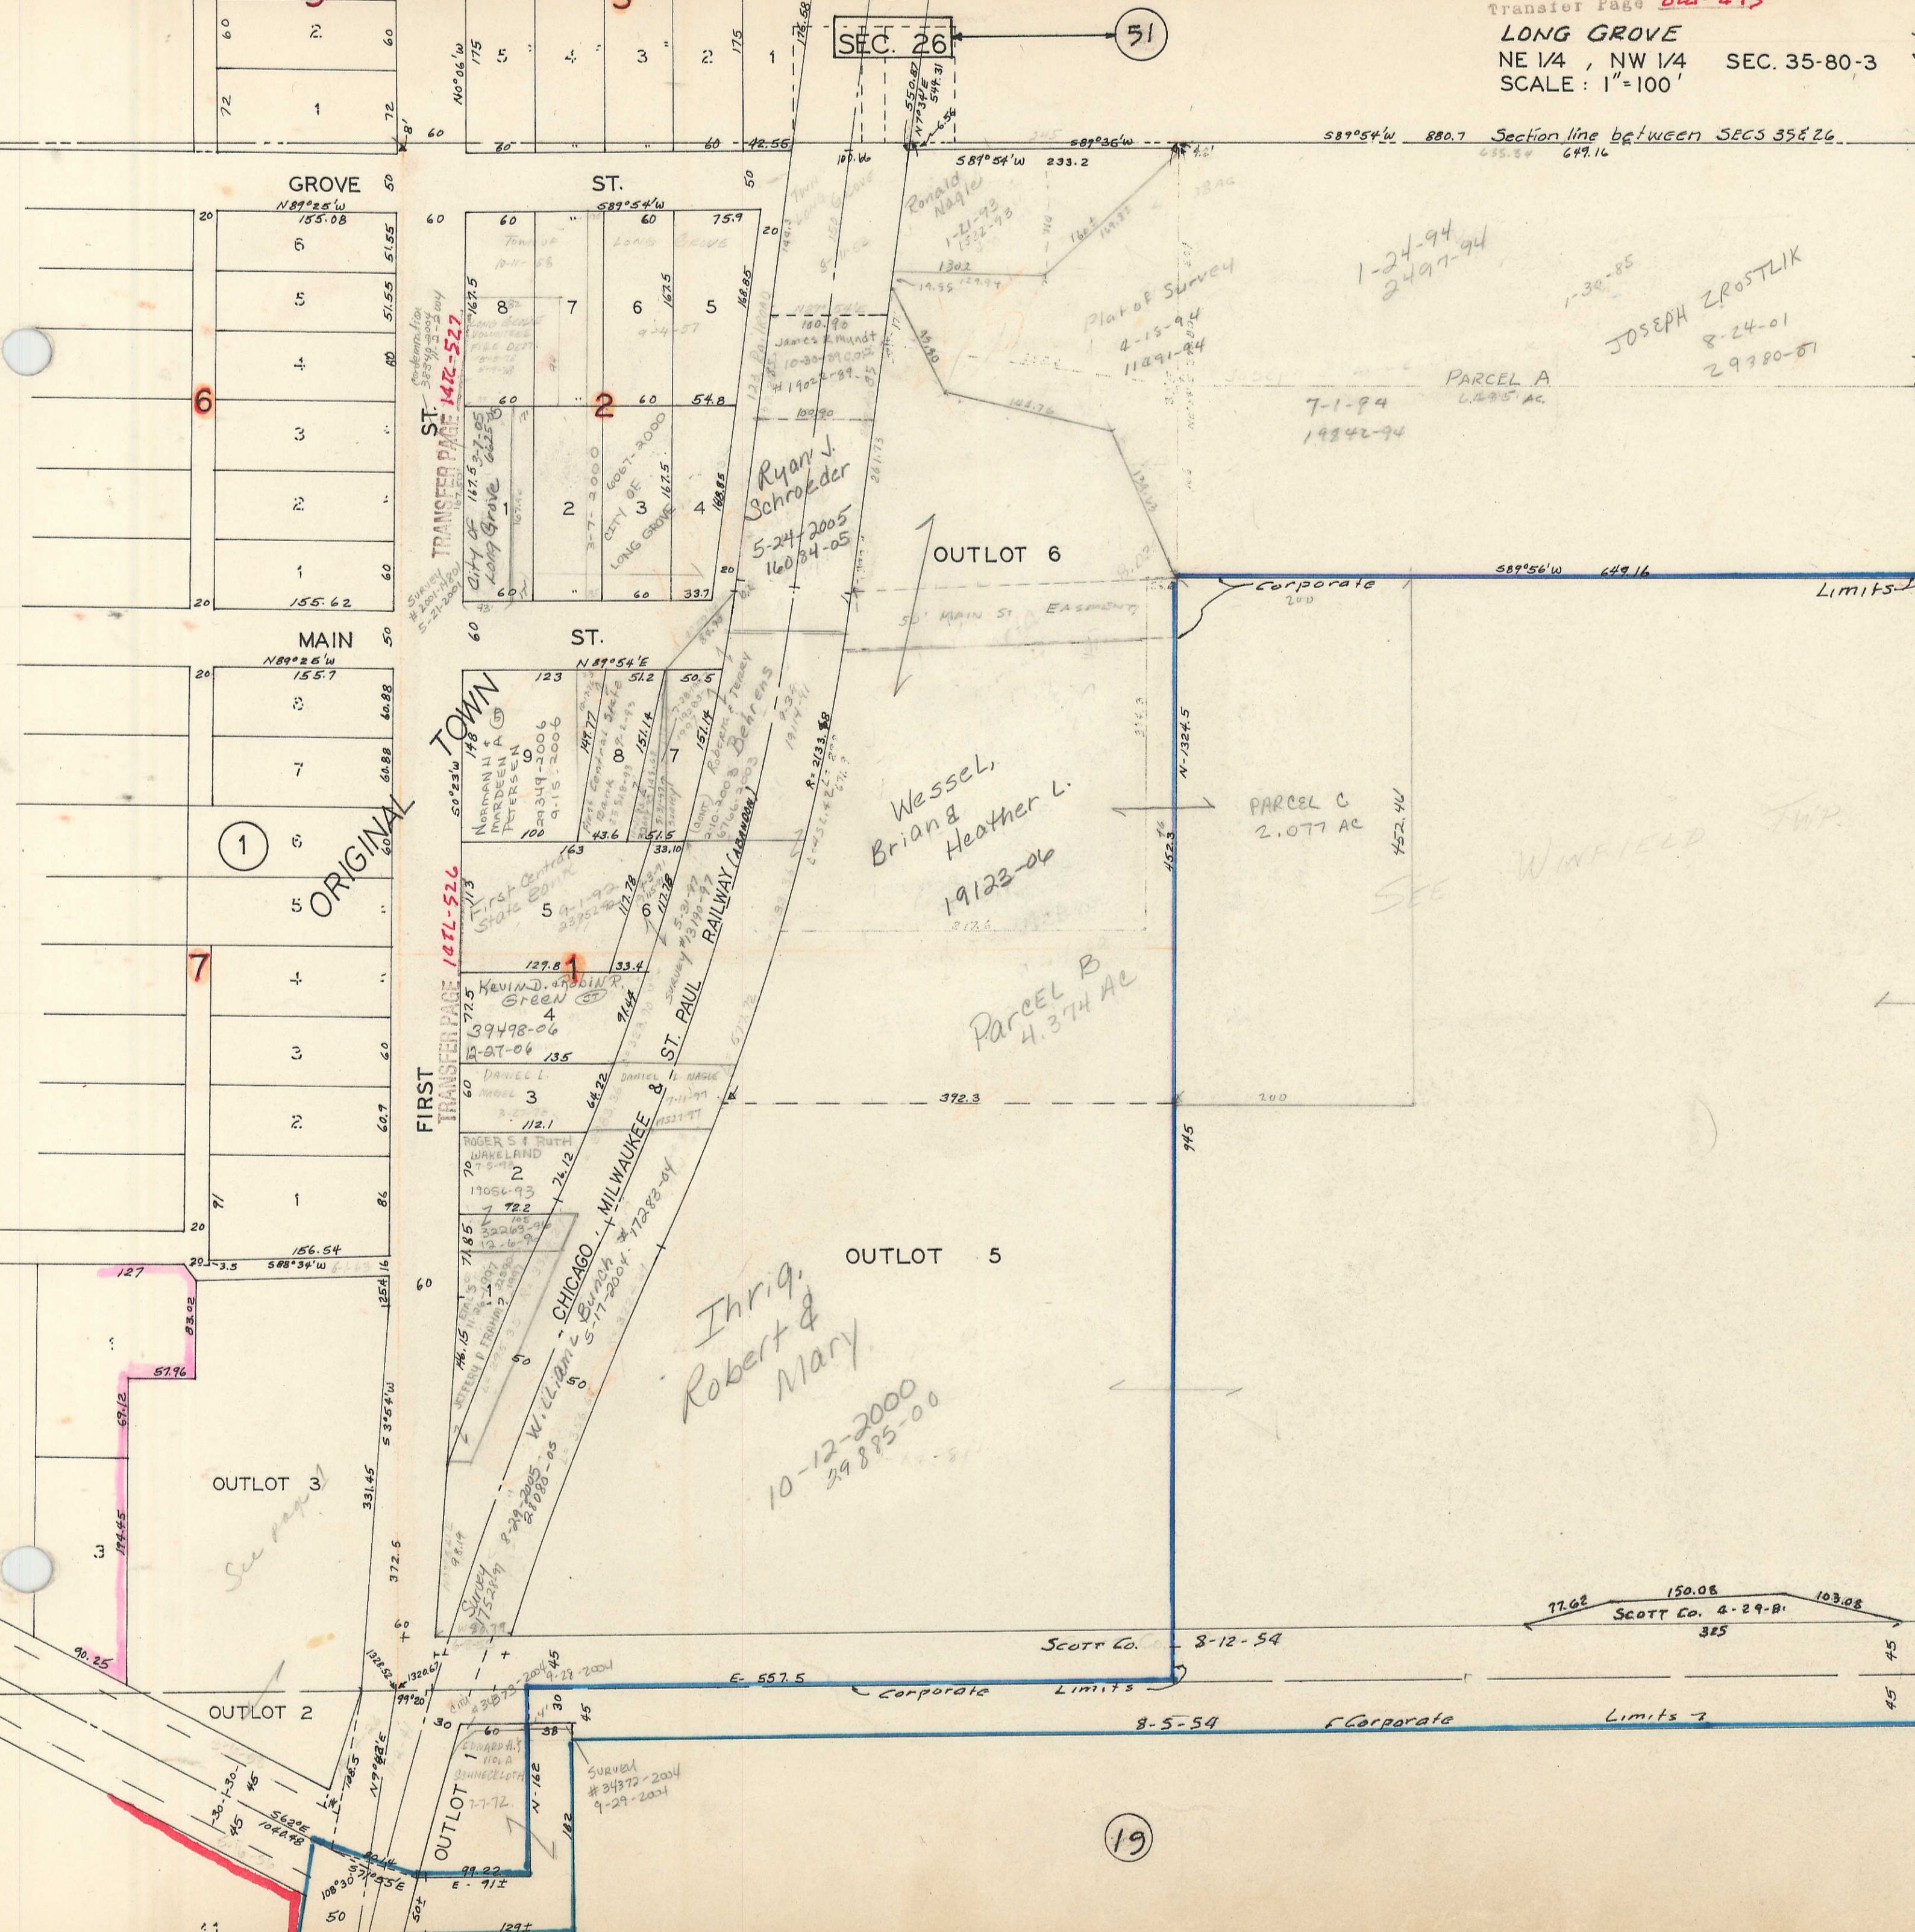

ST. TRANSFER PAGE 1412-527

FIRST TRANSFER PAGE 1471-526

ORIGINAL

1

19

1-24-94  
2497-94

1-30-85

JOSEPH ZROSTLIK  
8-24-01  
29380-01

Ryan J. Schroeder  
5-24-2005  
16034-05

Wessel,  
Brian &  
Heather L.  
19123-06


Ihrig,  
Robert &  
Mary  
10-12-2000  
29885-00

PARCEL A  
6.275 AC.

PARCEL C  
2.077 AC

PARCEL B  
4.374 AC

77.62 150.06 103.08  
SCOTT Co. 4-29-81  
385

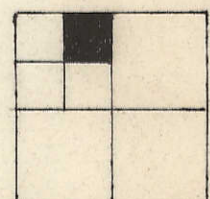

WINFIELD TOWNSHIP PG 35  
NW 1/4 NE 1/4 SEC. 35

E. line NW 1/4 SEC. 35-80-3

Limits

Corporate Limits

Corporate Limits

Corporate Limits