


WINFIELD TOWNSHIP PG 26  
SE 1/4 NW 1/4 SEC. 26

Transfer Page 814-486  
LONG GROVE  
NE 1/4, SW 1/4 SEC. 26-80-3  
SCALE: 1 = 100

WINFIELD TOWNSHIP PG 26  
NW 1/4 SW 1/4 SEC. 26

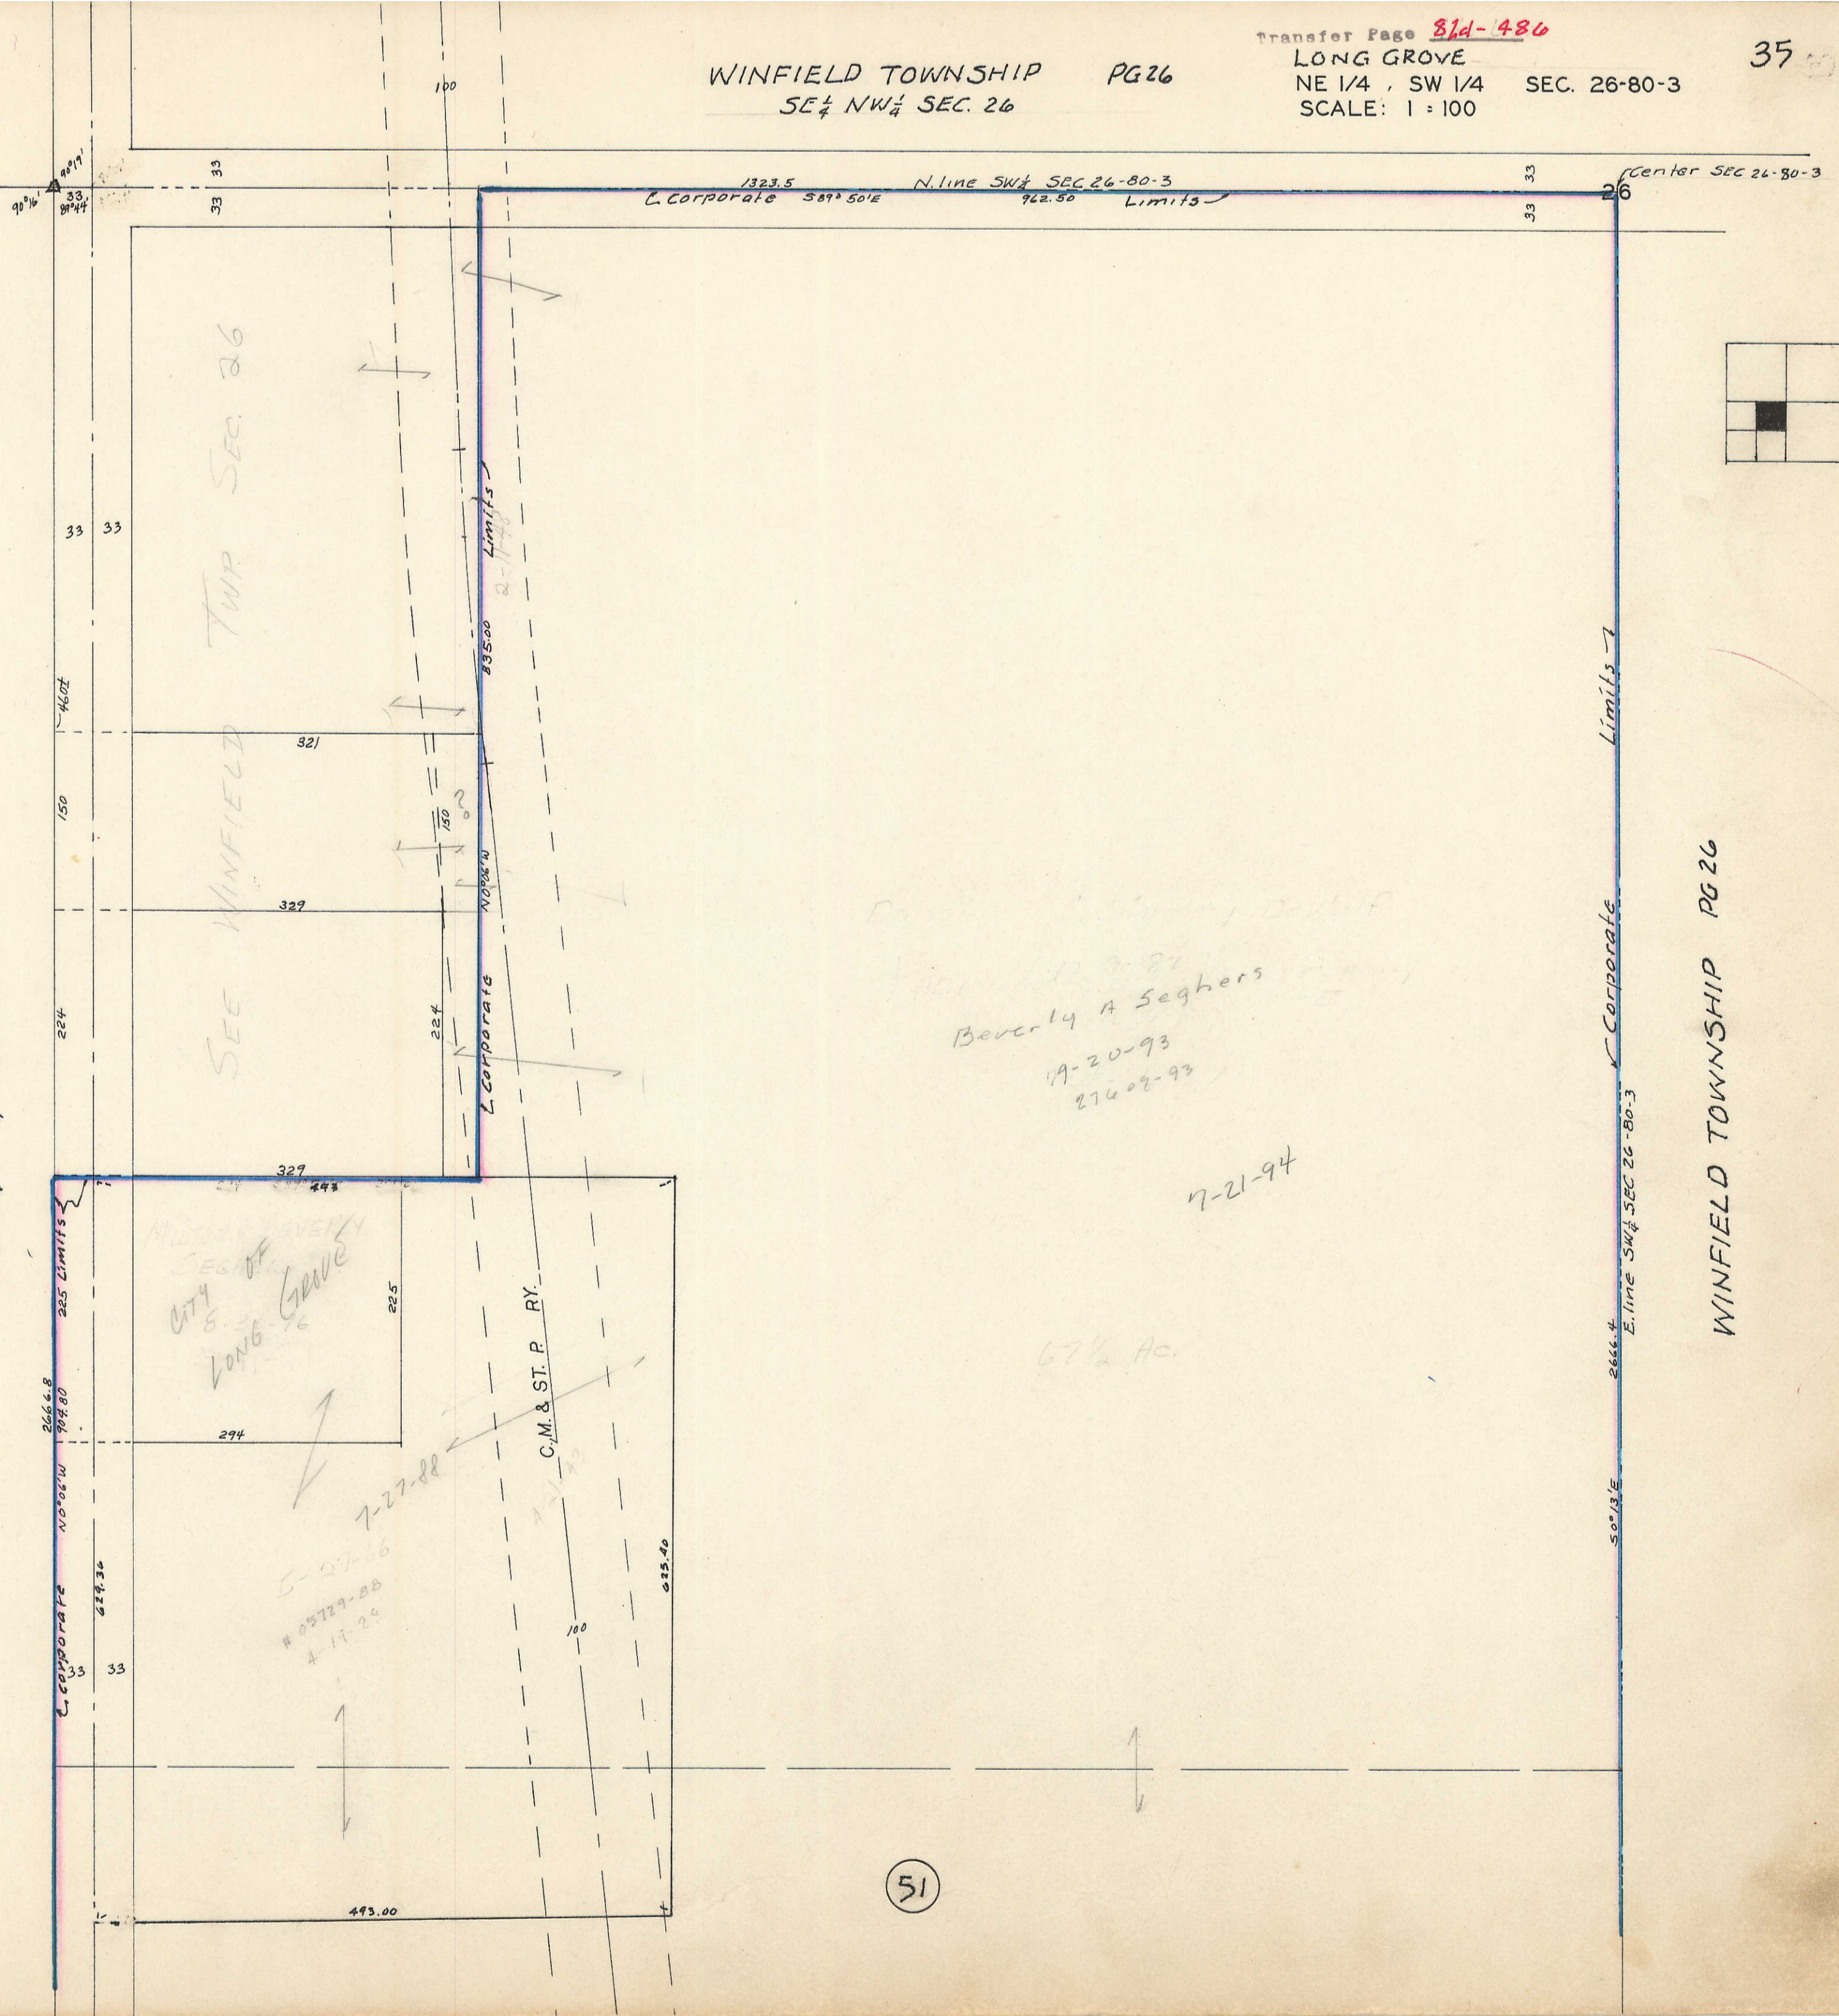

51

