


BUTLER TOWNSHIP SE 1/4 SE 4 SEC. 11-80-4

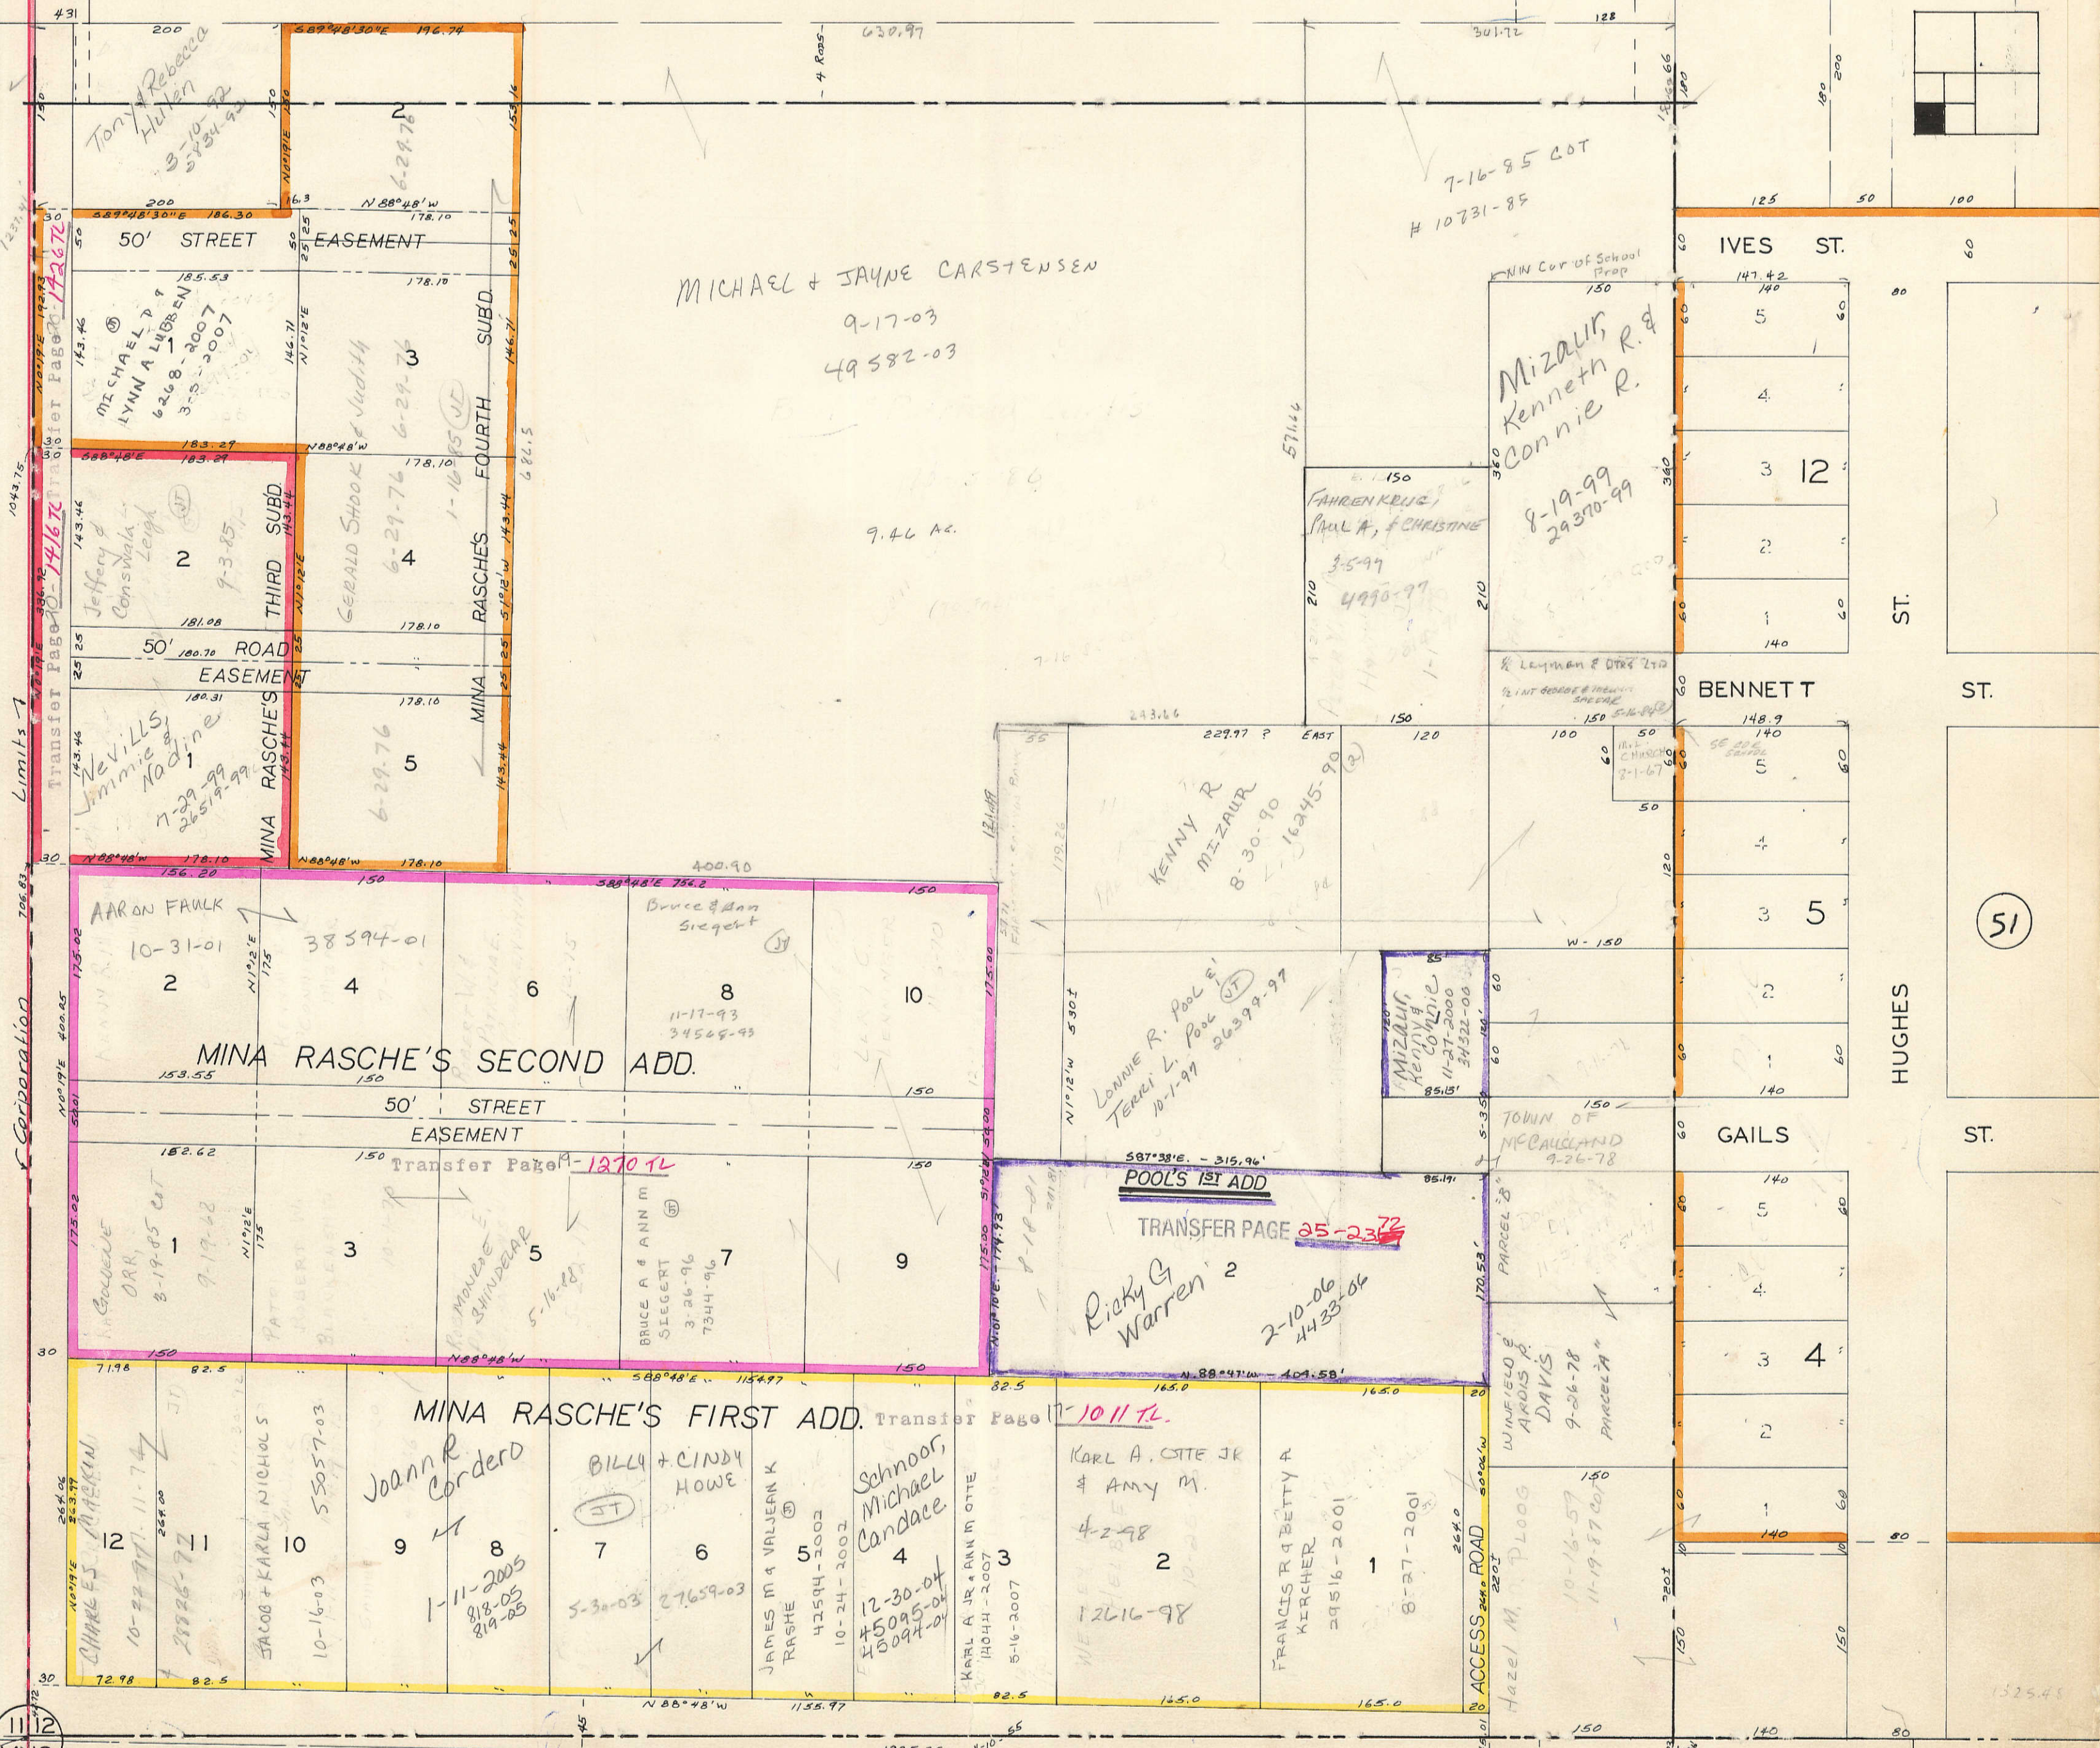

Transfer Page 172-672  
Transfer Page 141-612  
Transfer Page 187-70 TL  
Transfer Page 35-2372  
Transfer Page 10-11 TL

MICHAEL & JAYNE CARSTENSEN  
9-17-03  
49582-03

Mizalur  
Kenneth R. &  
Connie R.  
8-19-99  
29370-99

MINA RASCHE'S SECOND ADD.

MINA RASCHE'S FIRST ADD.

POOL'S 1ST ADD.

CLEAR VIEW ADD. SEC 13

51

11  
12  
48  
3

33

1

HUGHES ST.

ST.

ST.

ST.

ST.

IVES ST.

BENNETT

GAILS

WINFIELD & ARDIS R. DAVIS

Hazel M. PLOOG

FAHRENKELG, PAUL A. & CHRISTINE  
3-5-97  
4990-97

LOUNNE R. POOL & TERRE L. POOL  
10-1-97  
26399-97

Ricky G. Warren  
2-10-06  
4133-06

9.46 AC.

7-16-85 LOT # 10731-85

Tony & Rebecca Huller  
3-10-92  
57301-92

MICHAEL & LYNN A. LYBSEN  
6-20-8  
3-5-2007

Jeffery & Consuela Leigh  
9-3-85

NeVills, Jimmie & Madeline  
7-29-99  
26519-99

AARON FAULK  
10-31-01  
38594-01

BOLEWIE ORR  
8-19-85  
9-19-88

CHARLES J. METERAN  
10-22-97  
2096-77

JACOB & KARLA NICHOLS  
10-16-03  
55057-03

1

34

35

